


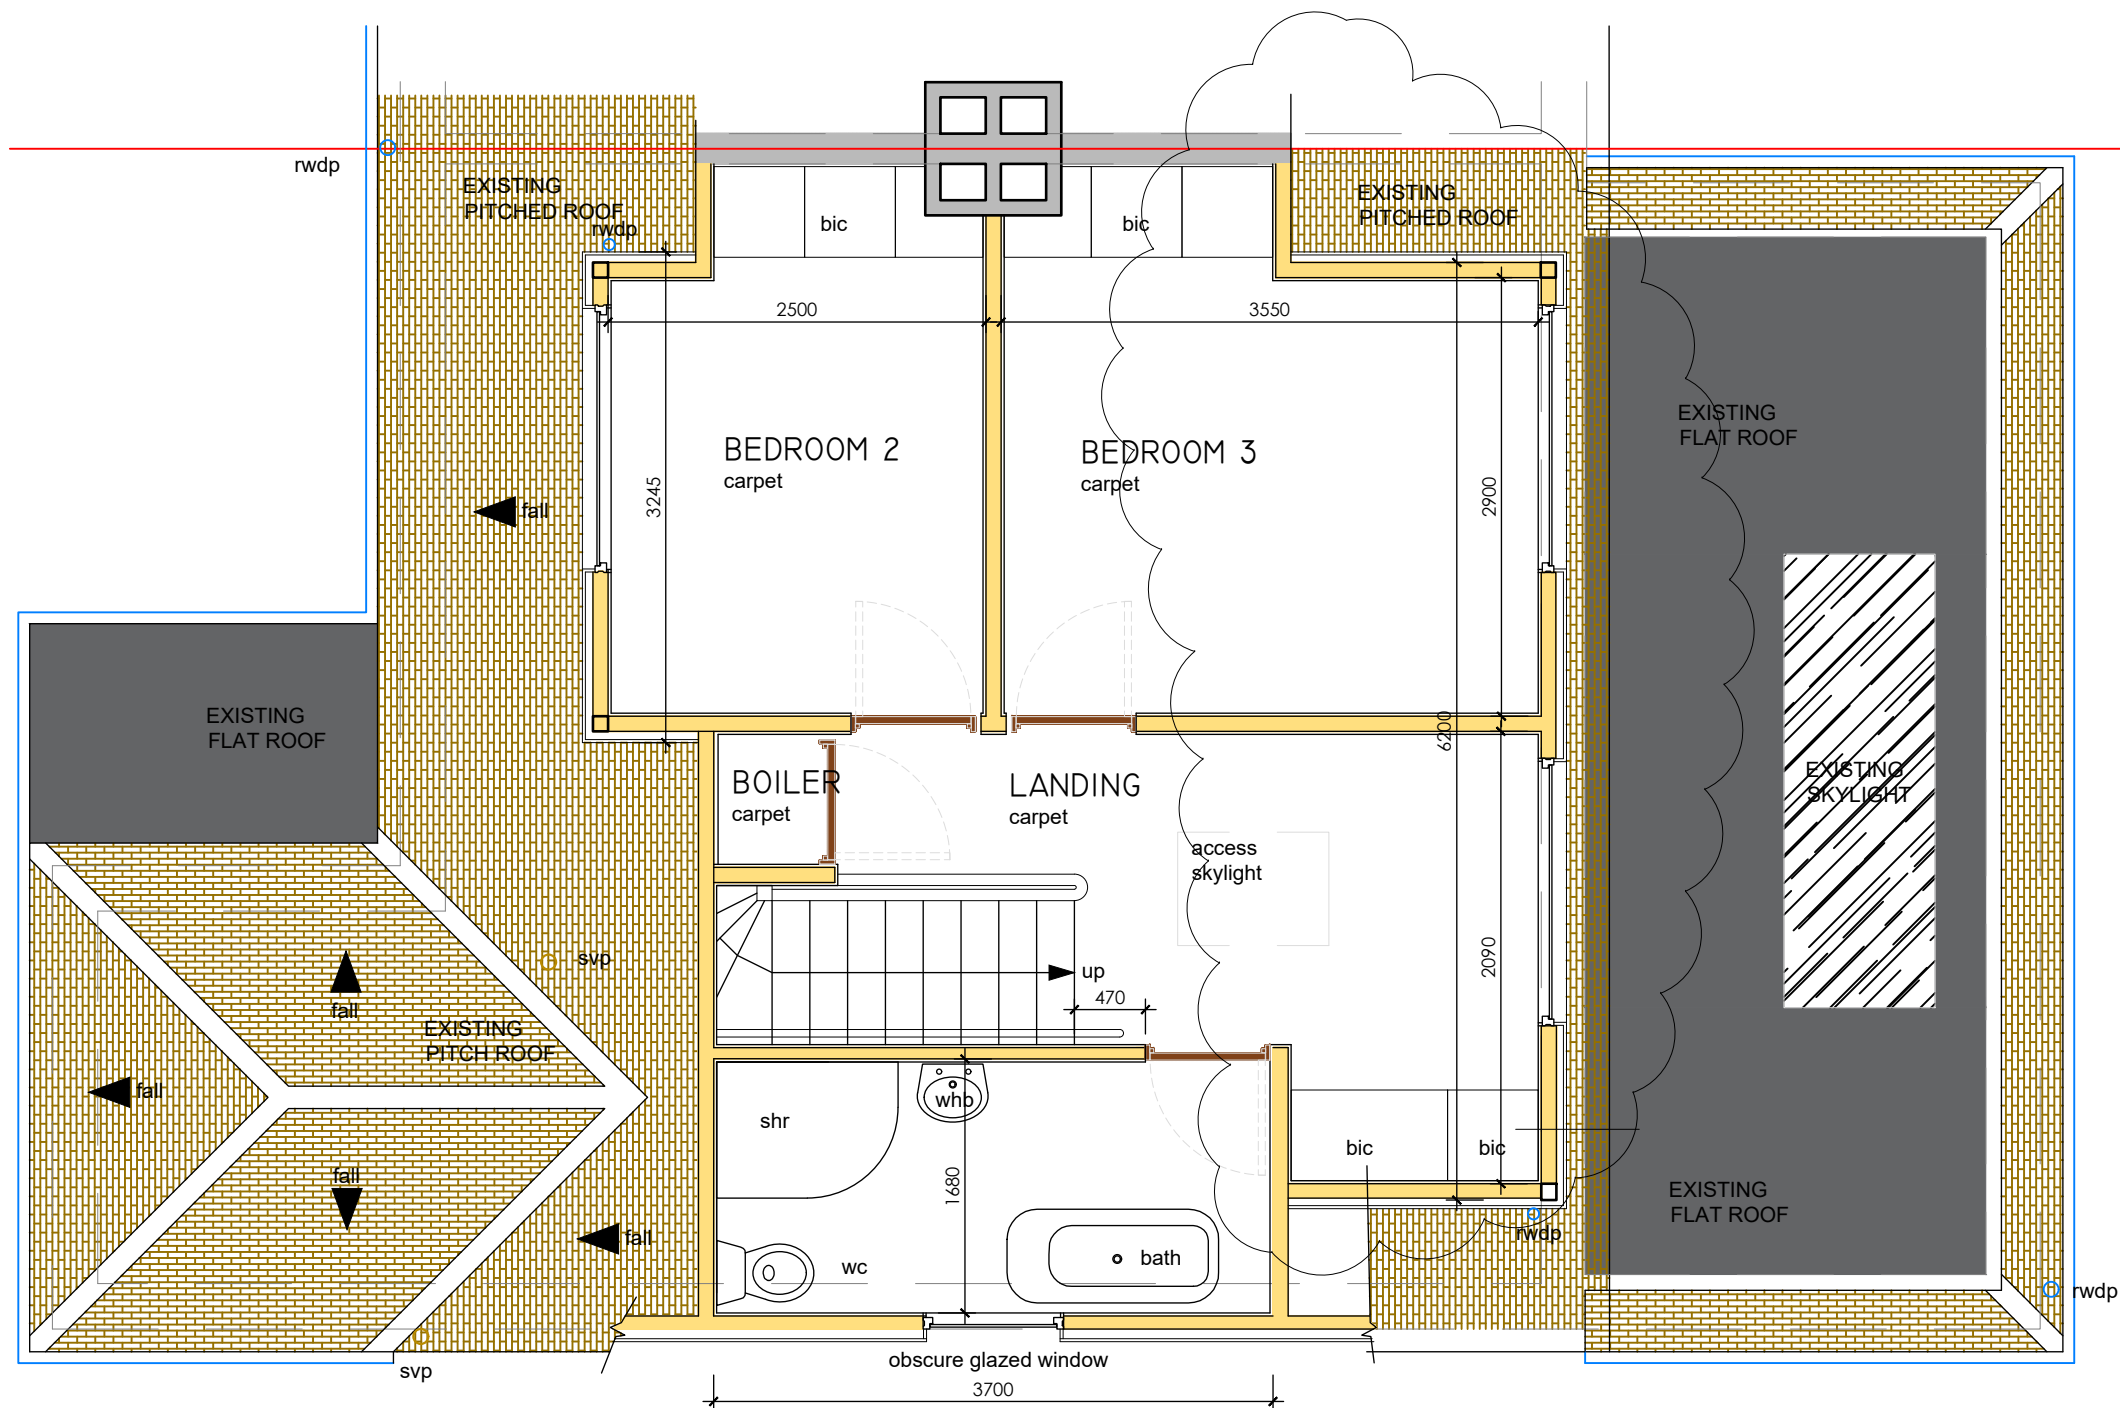

PROPOSED FIRST FLOOR PLAN



SCALE 1:50 @ A3

BATHROOM
VINYL TILES

THIS DRAWING IS COPYRIGHT AND MUST NOT BE REISSUED, LOANED OR COPIED WITHOUT THE WRITTEN CONSENT OF PAUL WILLIAMS.

ALL DIMENSIONS MUST BE CHECKED ON SITE BEFORE PROCEEDING AND ANY DISCREPANCIES NOTIFIED IMMEDIATELY.

ALL SETTING OUT ON SITE IS THE RESPONSIBILITY OF THE CONTRACTOR

Notes:

AS BUILT
CONSTRUCTION
TENDER
BUILDING CONTROL
X PLANNING
DESIGN

C	18.02.26	extended back dorma to wall line below
B	28.01.26	reduced the size of the dorma on the North elevation
A	29.11.25	Added North Point

Rev:	Date:	Amendment:
------	-------	------------



PAUL RICHARD WILLIAMS
DESIGN AND BUILD
CONSULTANCY

42 Mill Green Road
Haywards Heath
West Sussex
RH16 1XQ

0773 245 1708

Client
Ryan Trigwell

Project Address:
20
Ingleside Crescent
Lancing
WEST SUSSEX
BN15 8EN

Project Title:
HSE TRIGWELL
Loft Conversion

Drawing Title:
PROPOSED FIRST FLOOR PLAN

Drawing Ref:
PL 005

Scale : 1:50 @A3

Date : Nov 2025

Rev : C

Drawn By : PRW