



PROPOSED

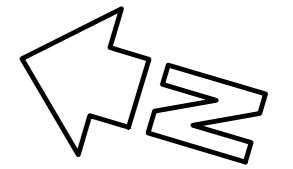

Layout of Second floor outside of red line is as approved under AWDM/1018/20

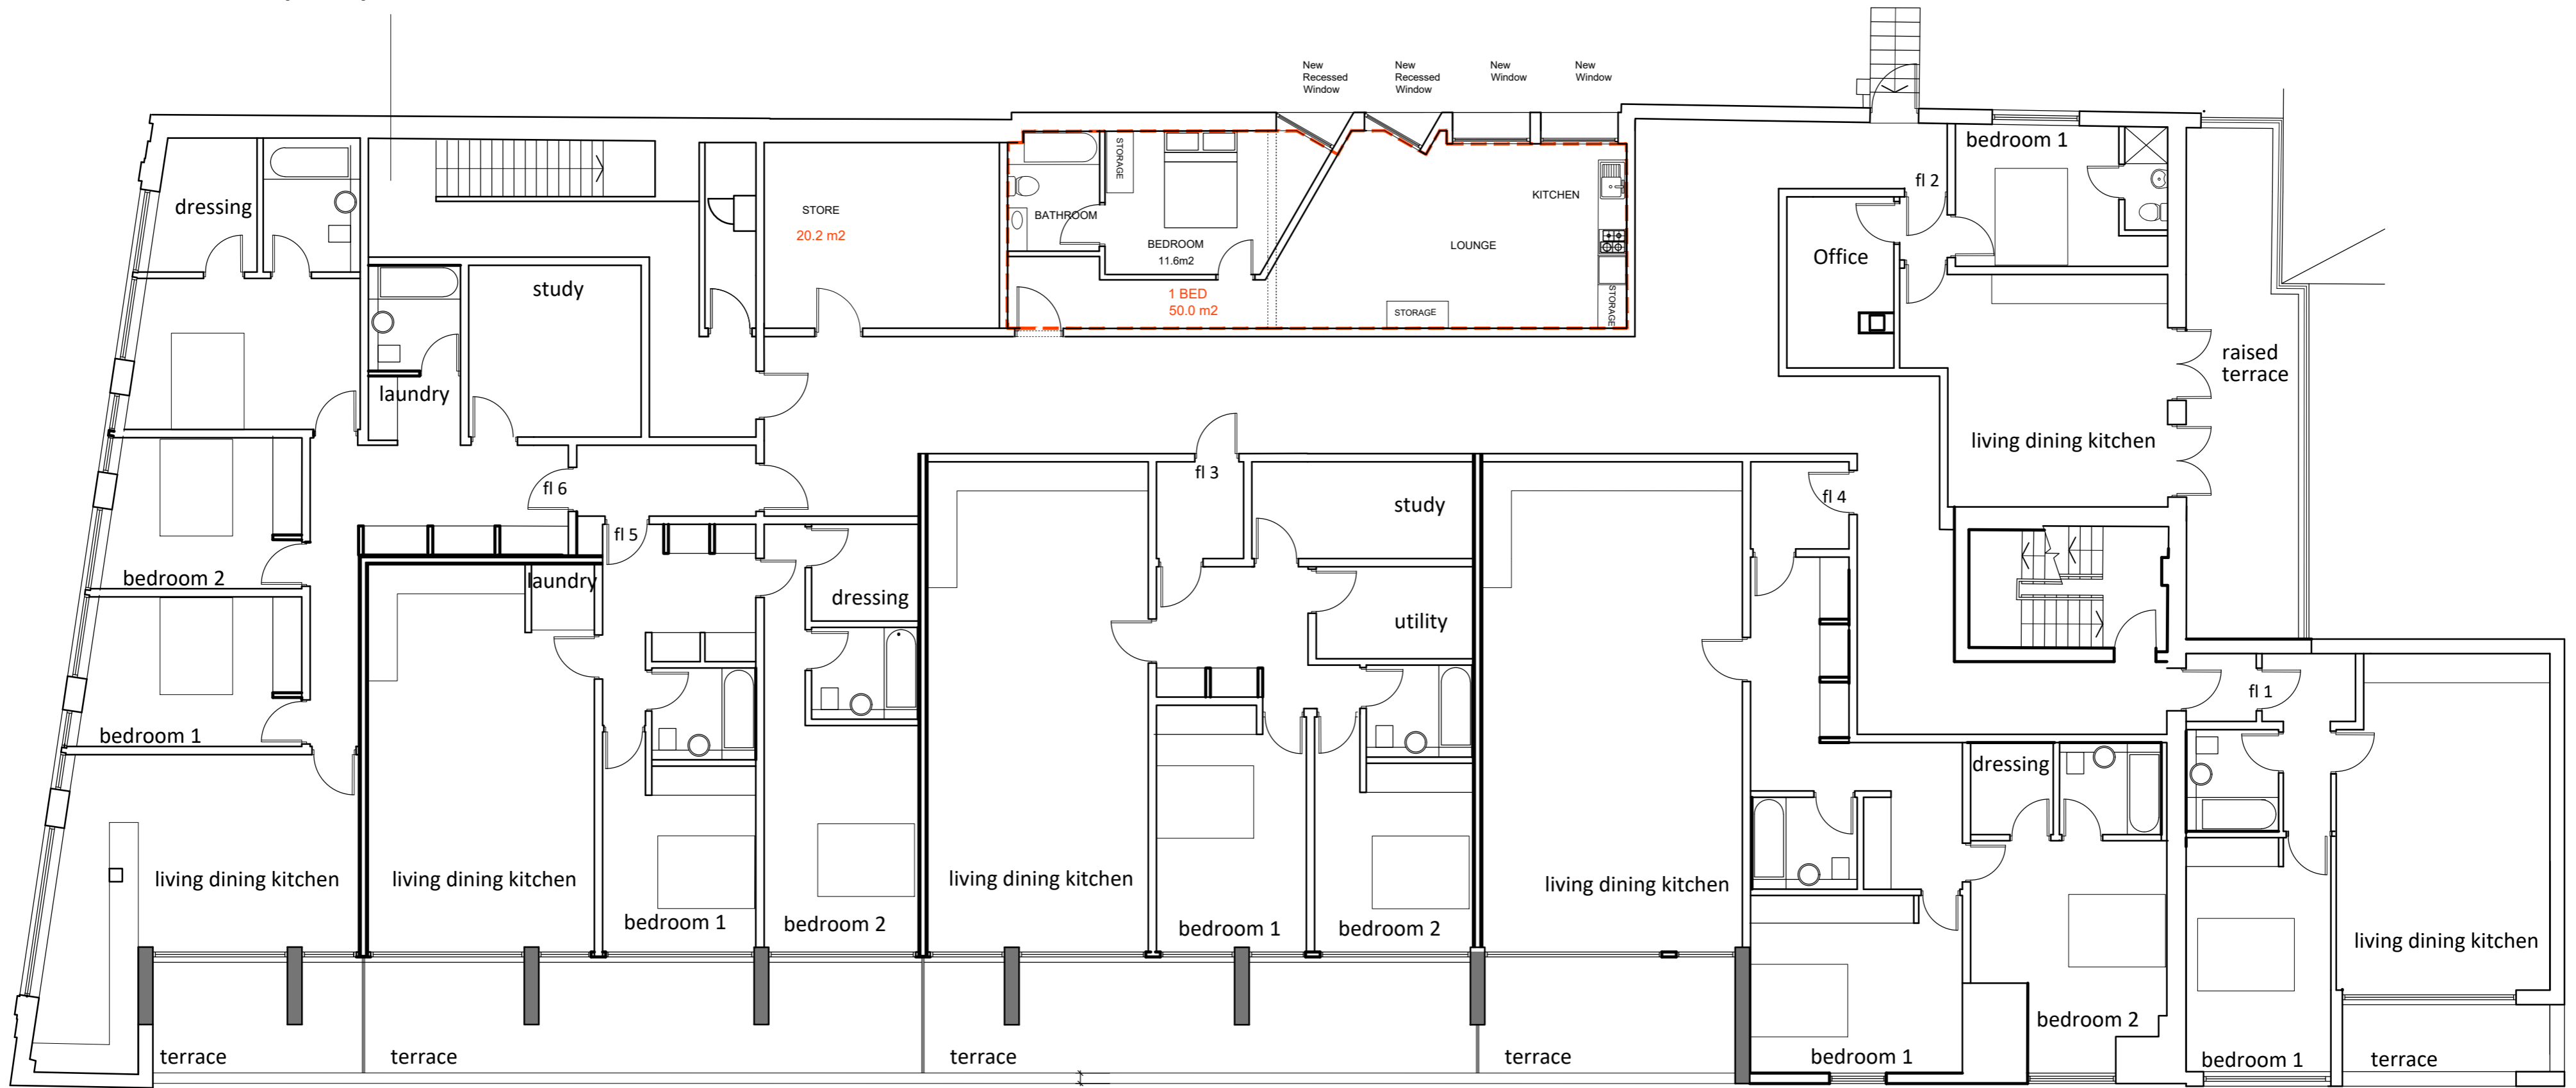

Second Floor

PLANNING

Tel.: 0749275955 Email: gho242@gmail.com	
Client: Avi Cohen	
Project Title: 31-35 Montague Street, Worthing BN11 3BE	
Drawing Title: Second Floor Proposed Plan	
By: HK	Date: May 2025
Project No: 1965	
Drawing No: 1965.PR.101	Revision: D
Scale: 1:100@A2	

