







South Elevation: Scale 1:100

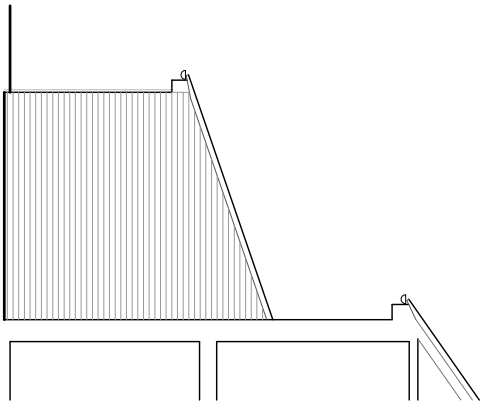


East Elevation: Scale 1:100

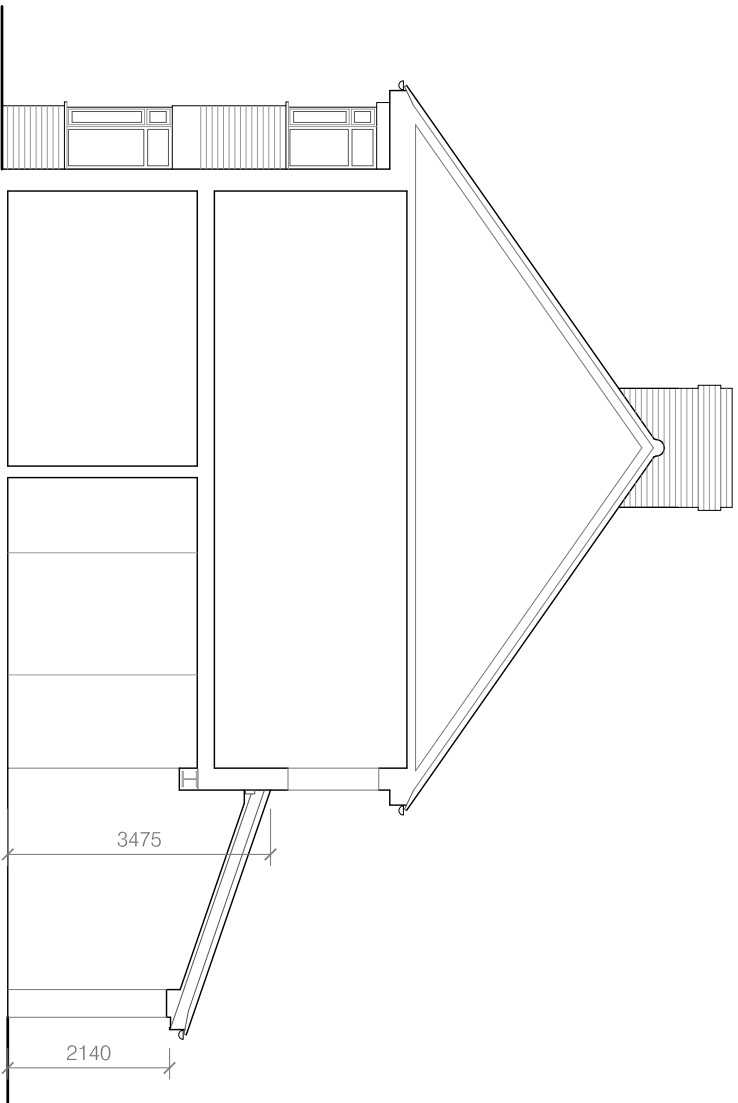

Typical Cross Section and North Elevation: Scale 1:100

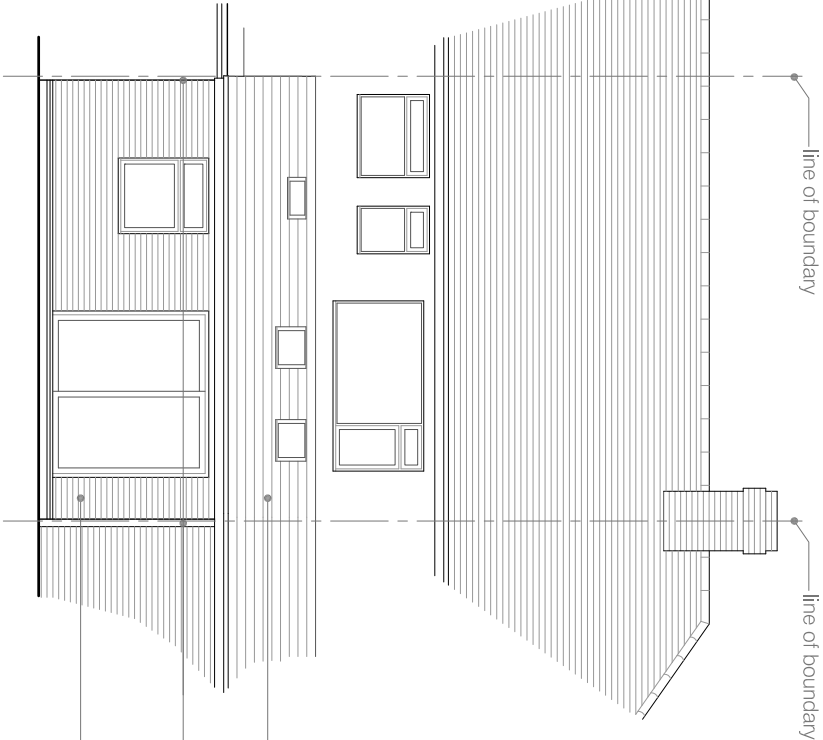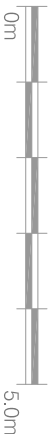

West Elevation: Scale 1:100

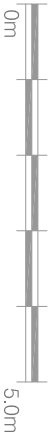

Note:
The new extension is built entirely within
the boundary of the property

- new roof tiles to match the existing
- new extension is not connected to
adjoining properties on either side
- PVCu windows and doors to match the
existing
- new brickwork to match the existing

notes

Permission is granted to scale from this drawing for the purpose of Local Authority
Planning Approval only. In all other cases DO NOT scale from this drawing. Please
contact this office for any additional information required.

Contractors, Sub-Contractors and Suppliers are to check all relevant dimensions, levels
and details of the site and any existing buildings before commencing any shop drawings
or building work. Any discrepancies should be reported to this office.

This drawing must be read in conjunction with all related drawings and documents
relevant to this project. Including those prepared by appointed consultants, specialists and
sub-consultants etc.

This drawing is the copyright of RDV a Design

revisions

revisions	01/04/2026
A dimensions added	13/04/2026
B boundary and notes added to west elevation	02/06/2026
C title block altered	

RDV a Design

9 Oak End | Arundel | West Sussex
Tel: 01903 884013

project	55 Cranleigh Road
	Worthing
	West Sussex
drawing	
	Elevations an Typical Cross Section
	As Built

scale	date	
1:100	@ A3	November 2025
job no	drawing no	rev
25281	02.03	C