

notes



Permission is granted to scale from this drawing for the purpose of Local Authority Planning Approval only. In all other cases DO NOT scale from this drawing. Please contact this office for any additional information required.

Contractors, Sub-Contractors and Suppliers are to check all relevant dimensions, levels and details of the site and any existing buildings before commencing any shop drawings or building work. Any discrepancies should be reported to this office.



This drawing must be read in conjunction with all related drawings and documents relevant to this project, including those prepared by appointed consultants, specialists and sub-consultants etc.

This drawing is the copyright of RDV a Design


revisions	
A	dimensions added 01/04/2026
B	title block altered 02/06/2026

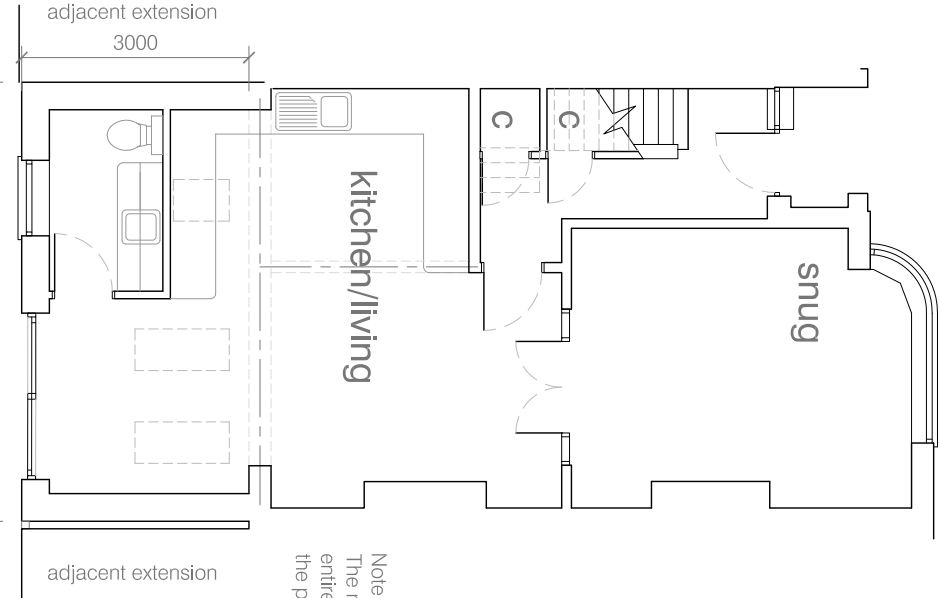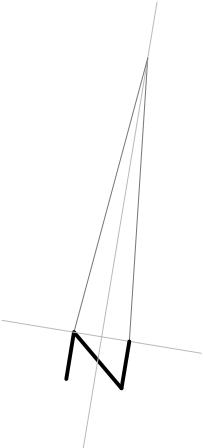

Ground Floor Plan: Scale 1:100

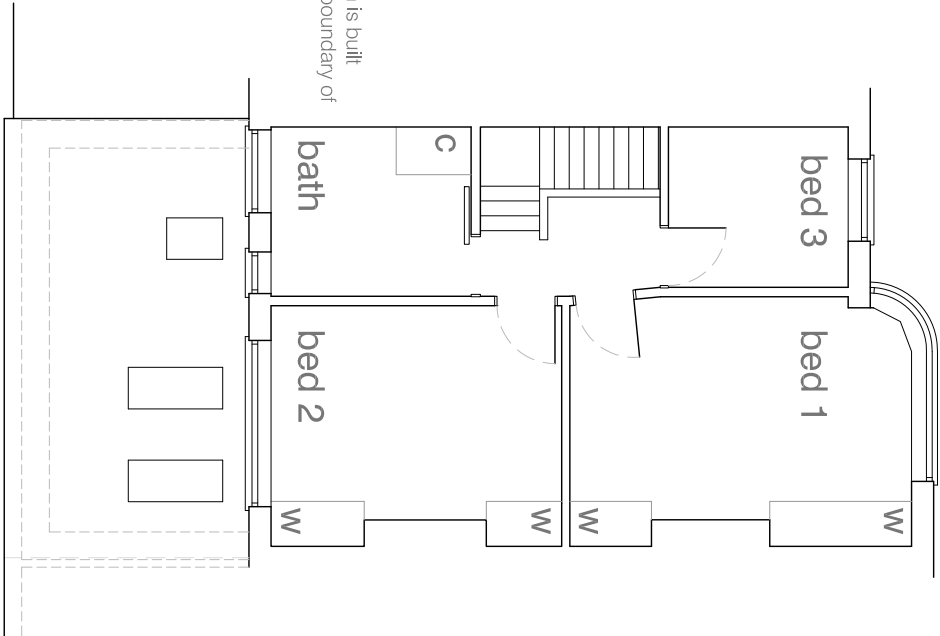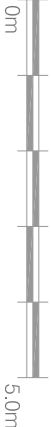

First Floor Plan: Scale 1:100

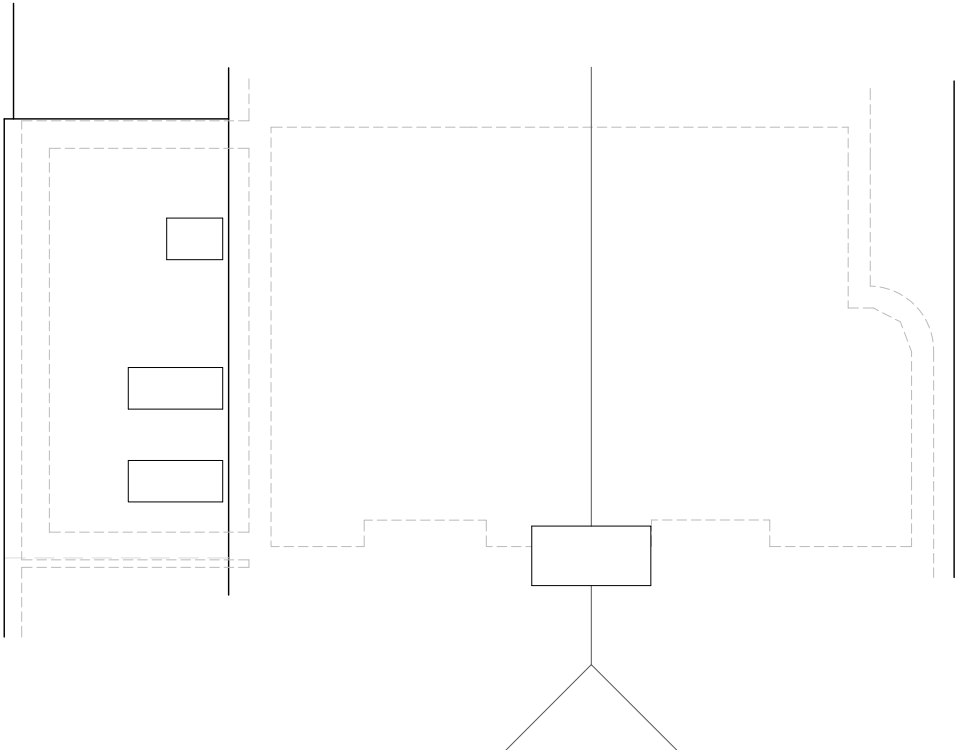

Roof Plan: Scale 1:100



RDV a Design

9 Oak End | Arundel | West Sussex
Tel: 01903 884013

project
55 Cranleigh Road
Worthing
West Sussex

drawing
Floor Plans and Roof Plan
As Built

scale		date	
1:100	@ A3	November 2025	
job no	drawing no	rev	
25281	02.02	B	