




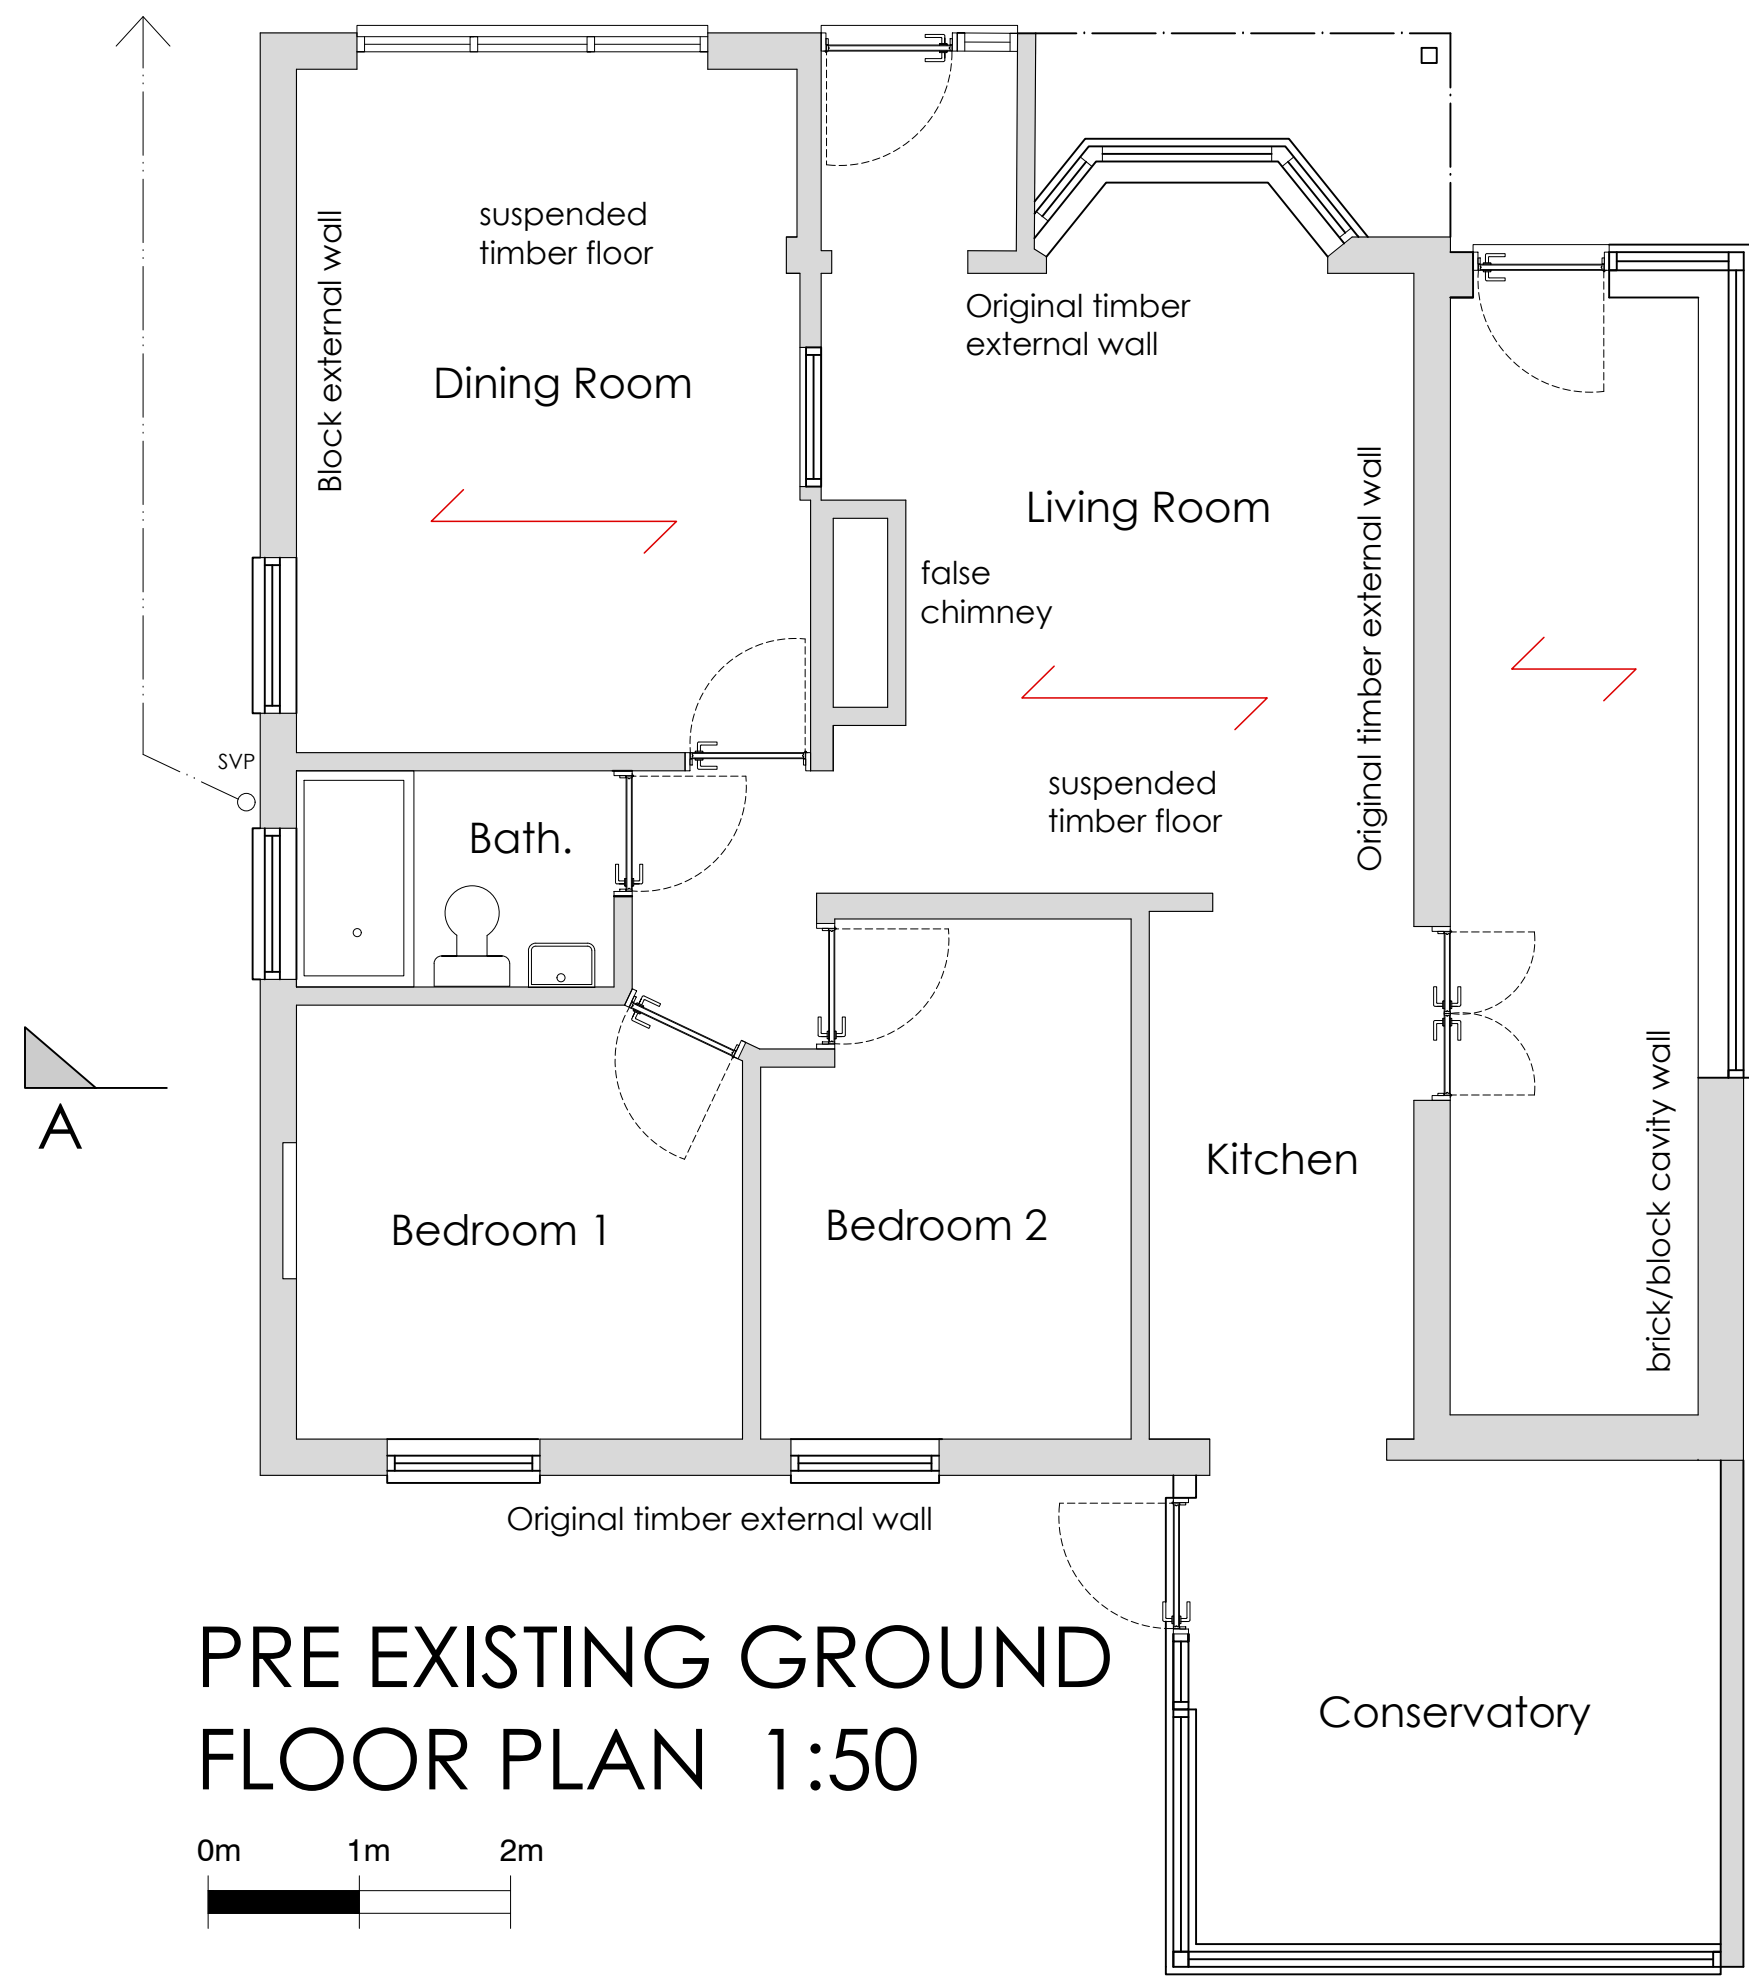


PRE EXISTING GROUND FLOOR PLAN 1:50

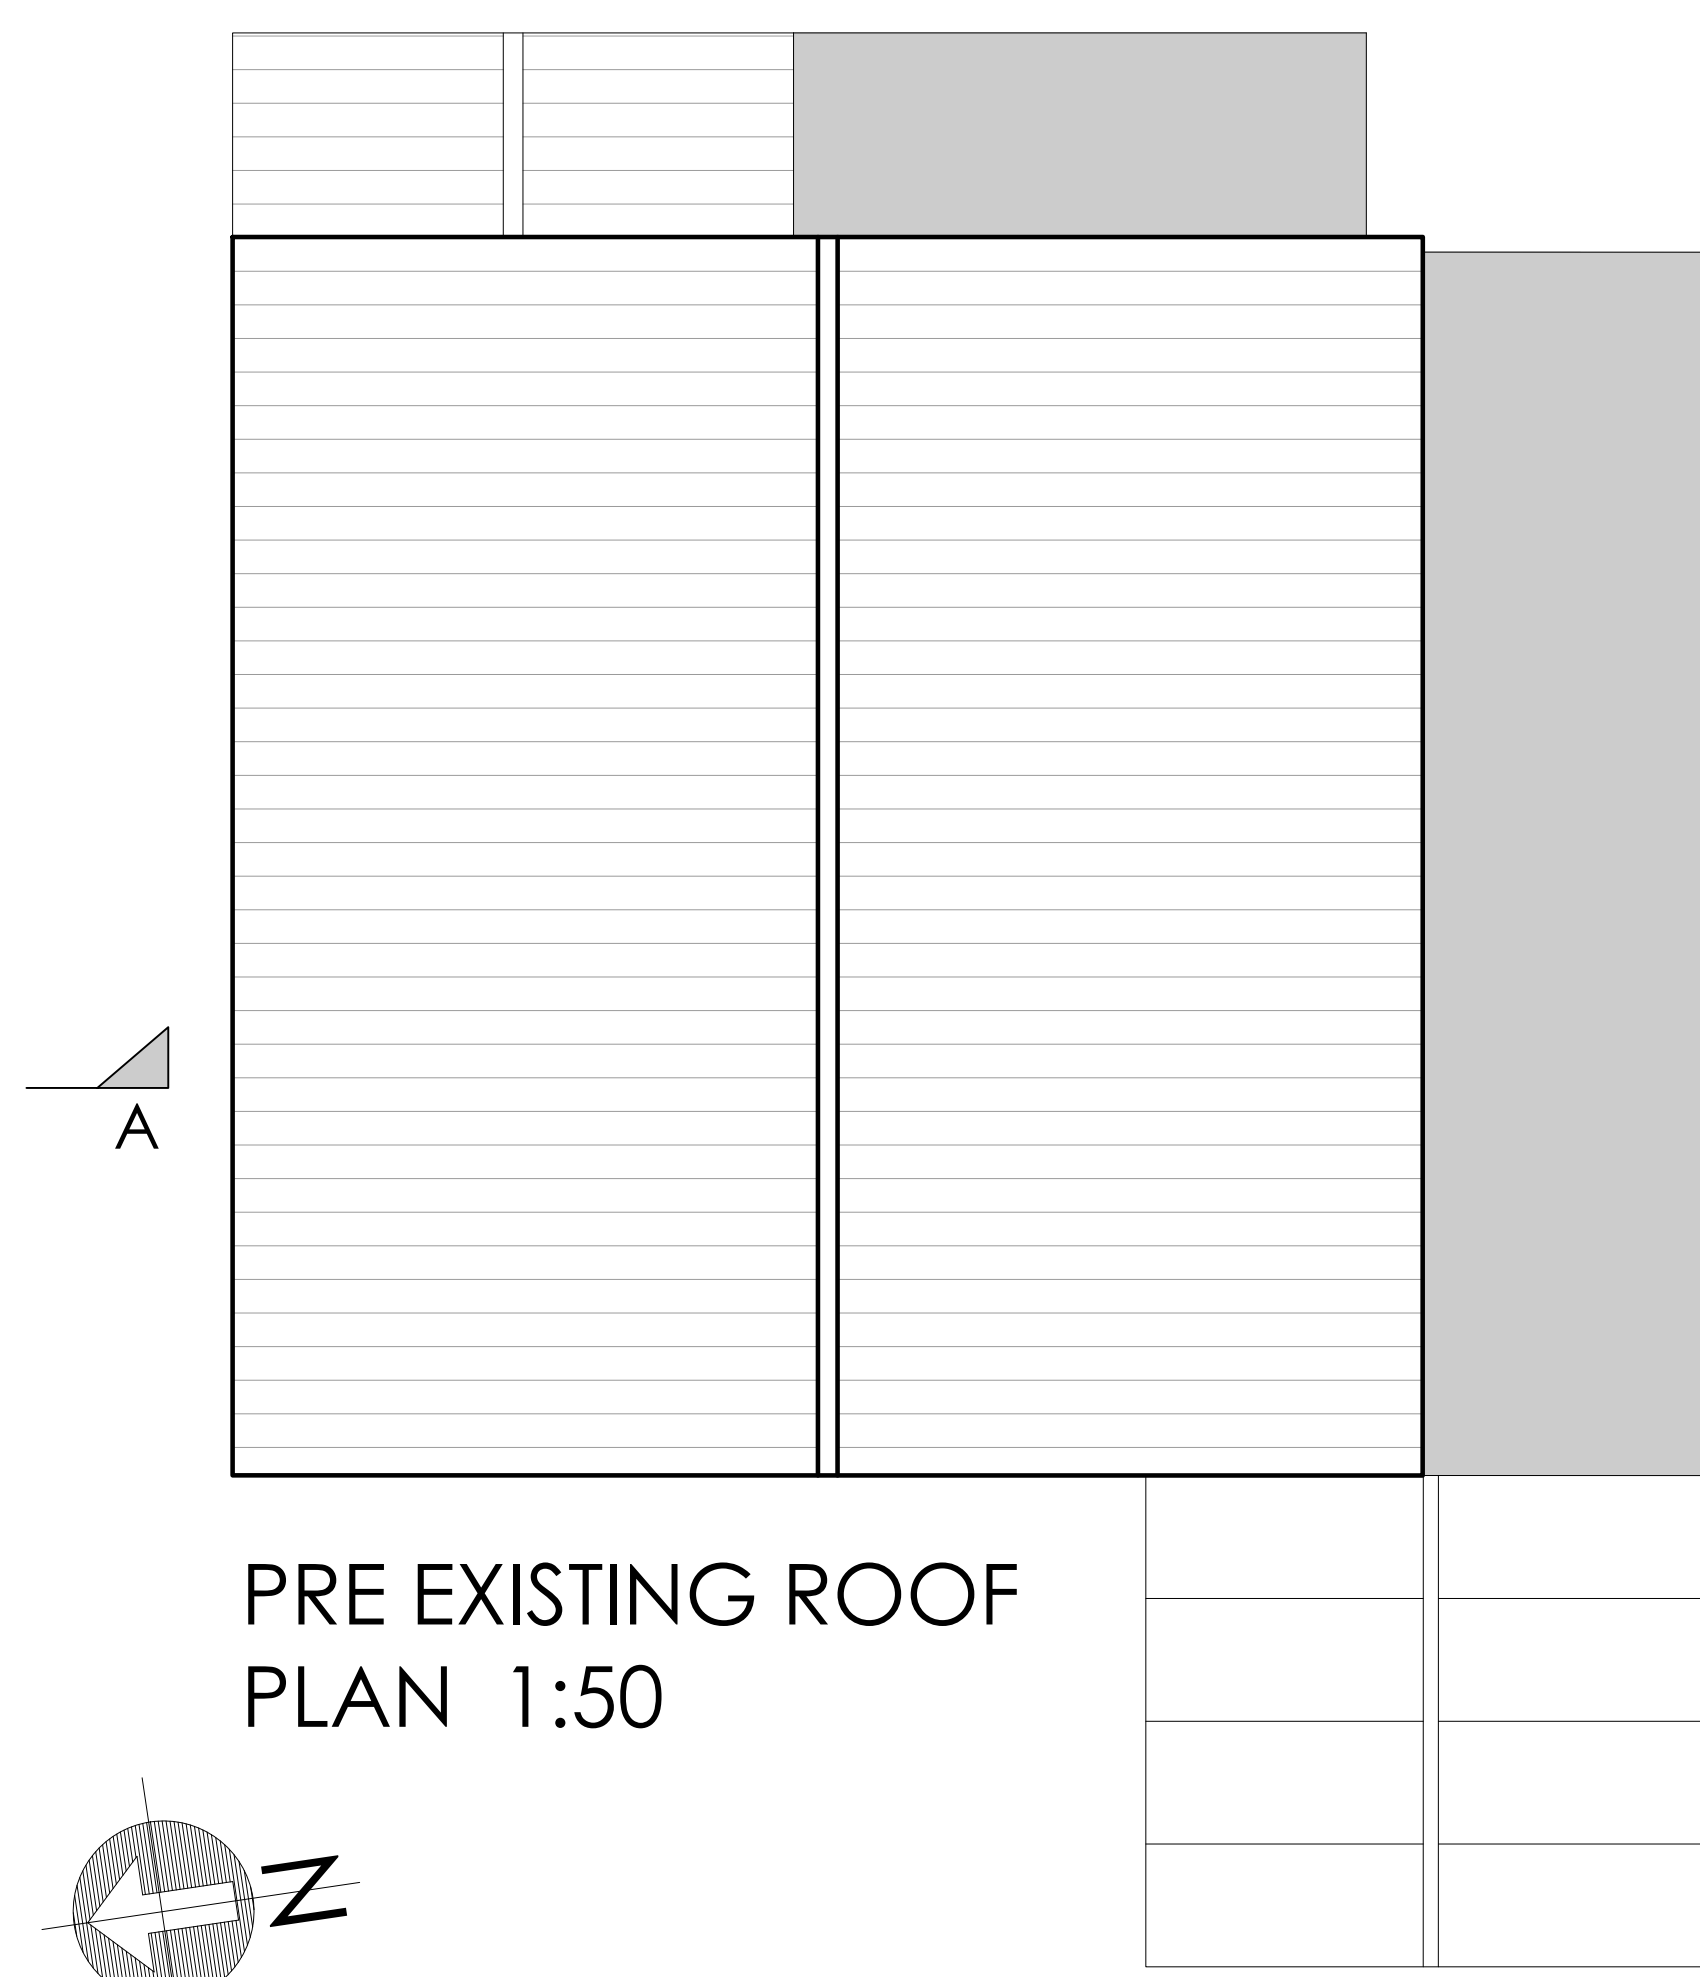

PRE EXISTING ROOF PLAN 1:50

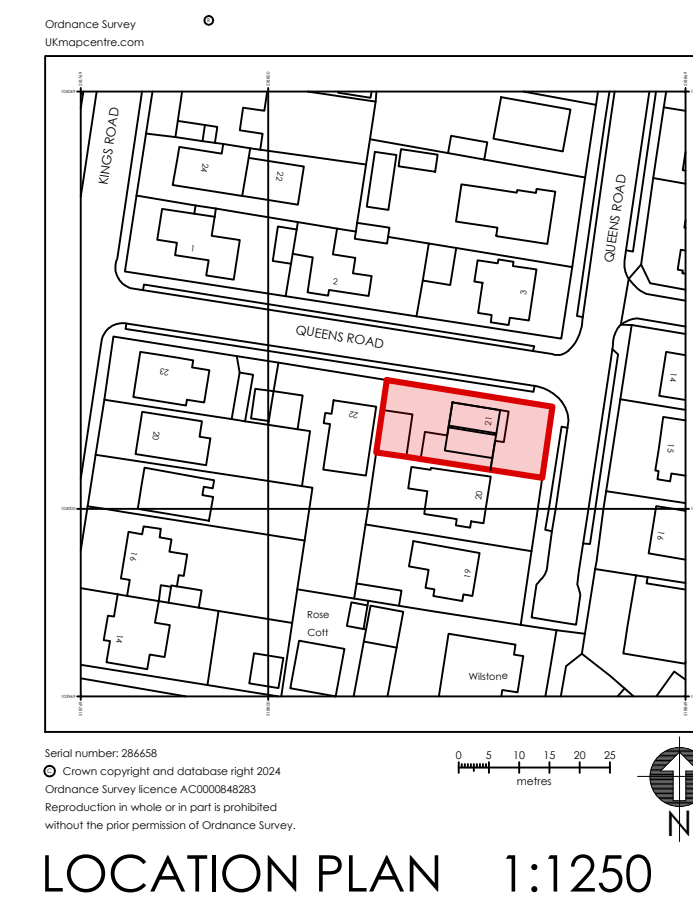


LOCATION PLAN 1:1250

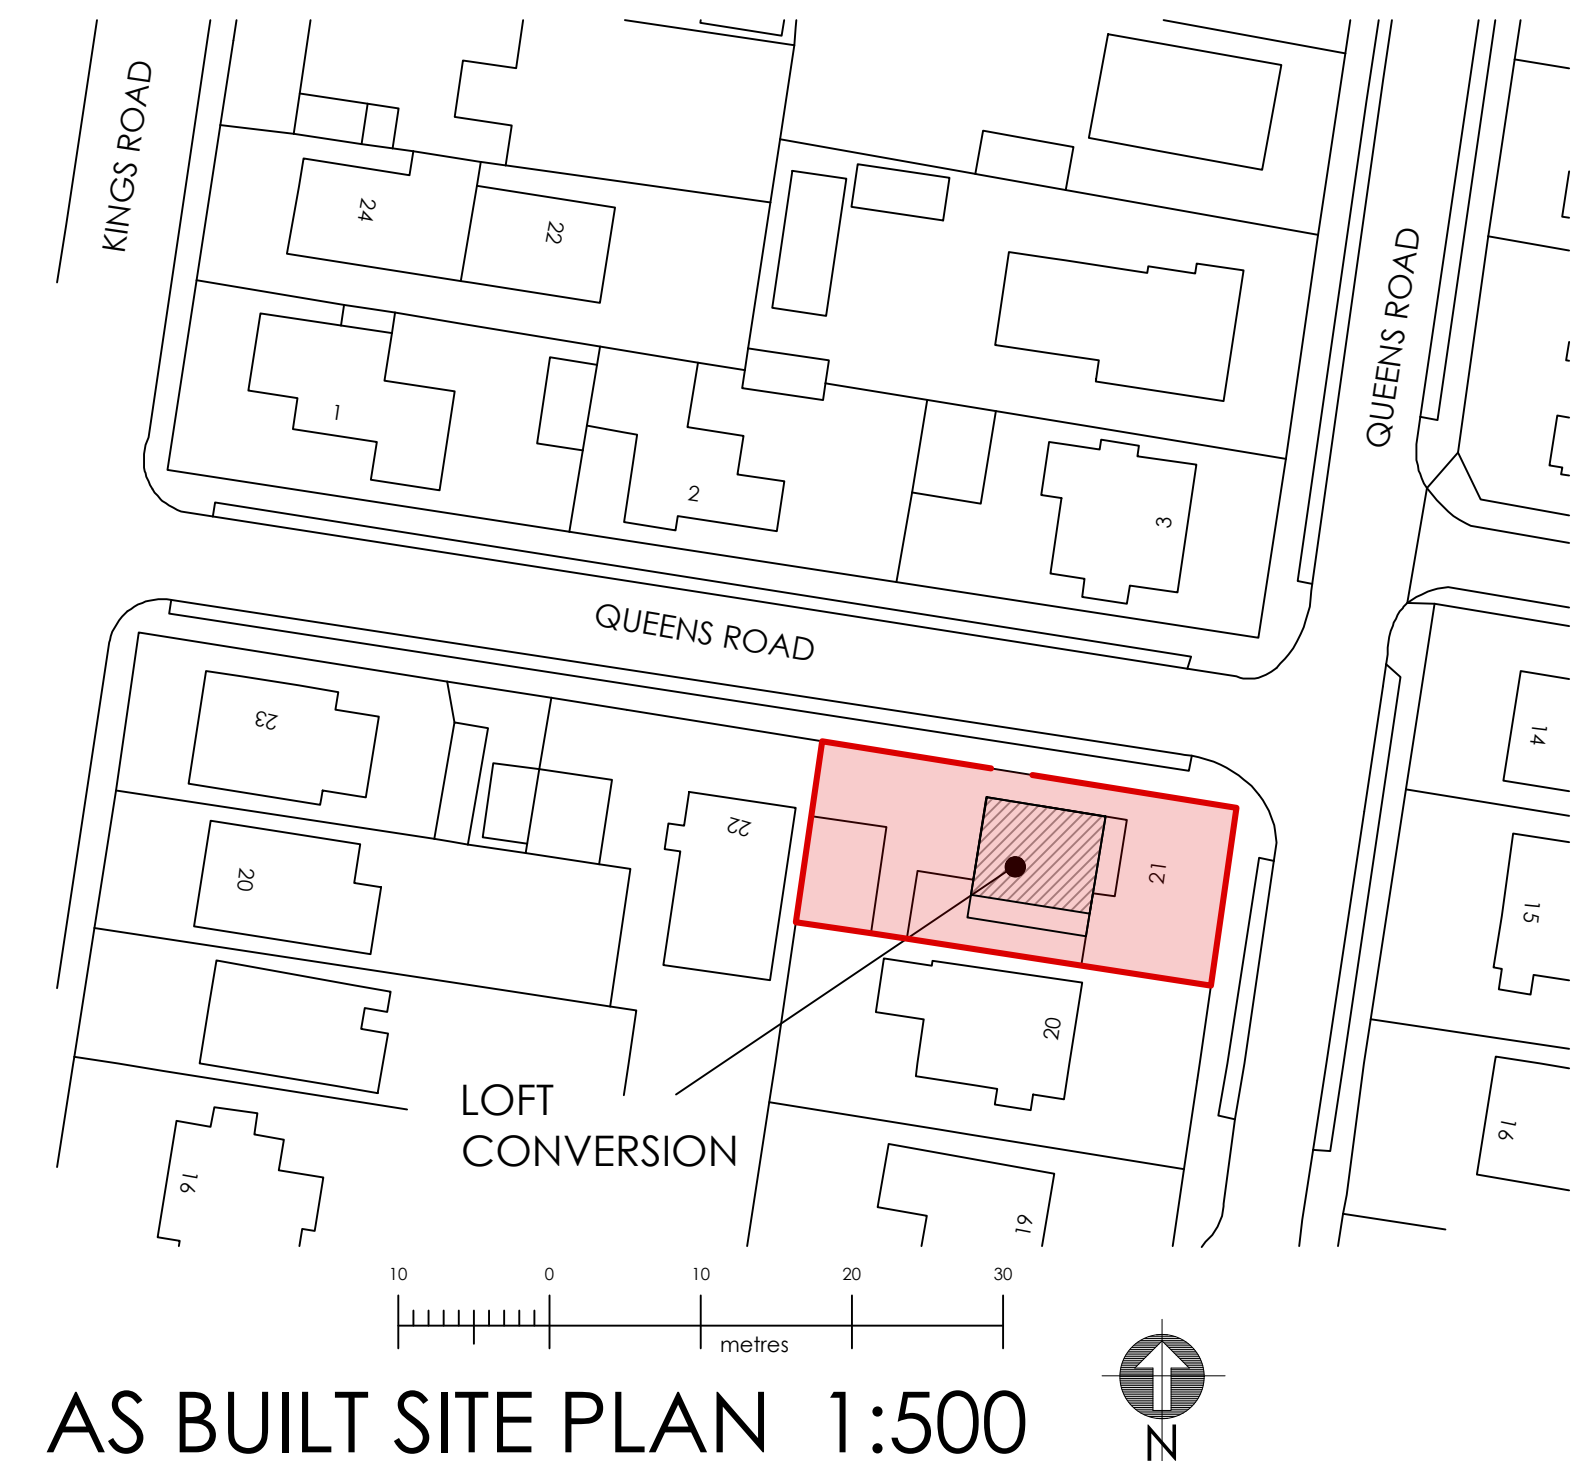


AS BUILT SITE PLAN 1:500

21 QUEENS ROAD,
LANCING

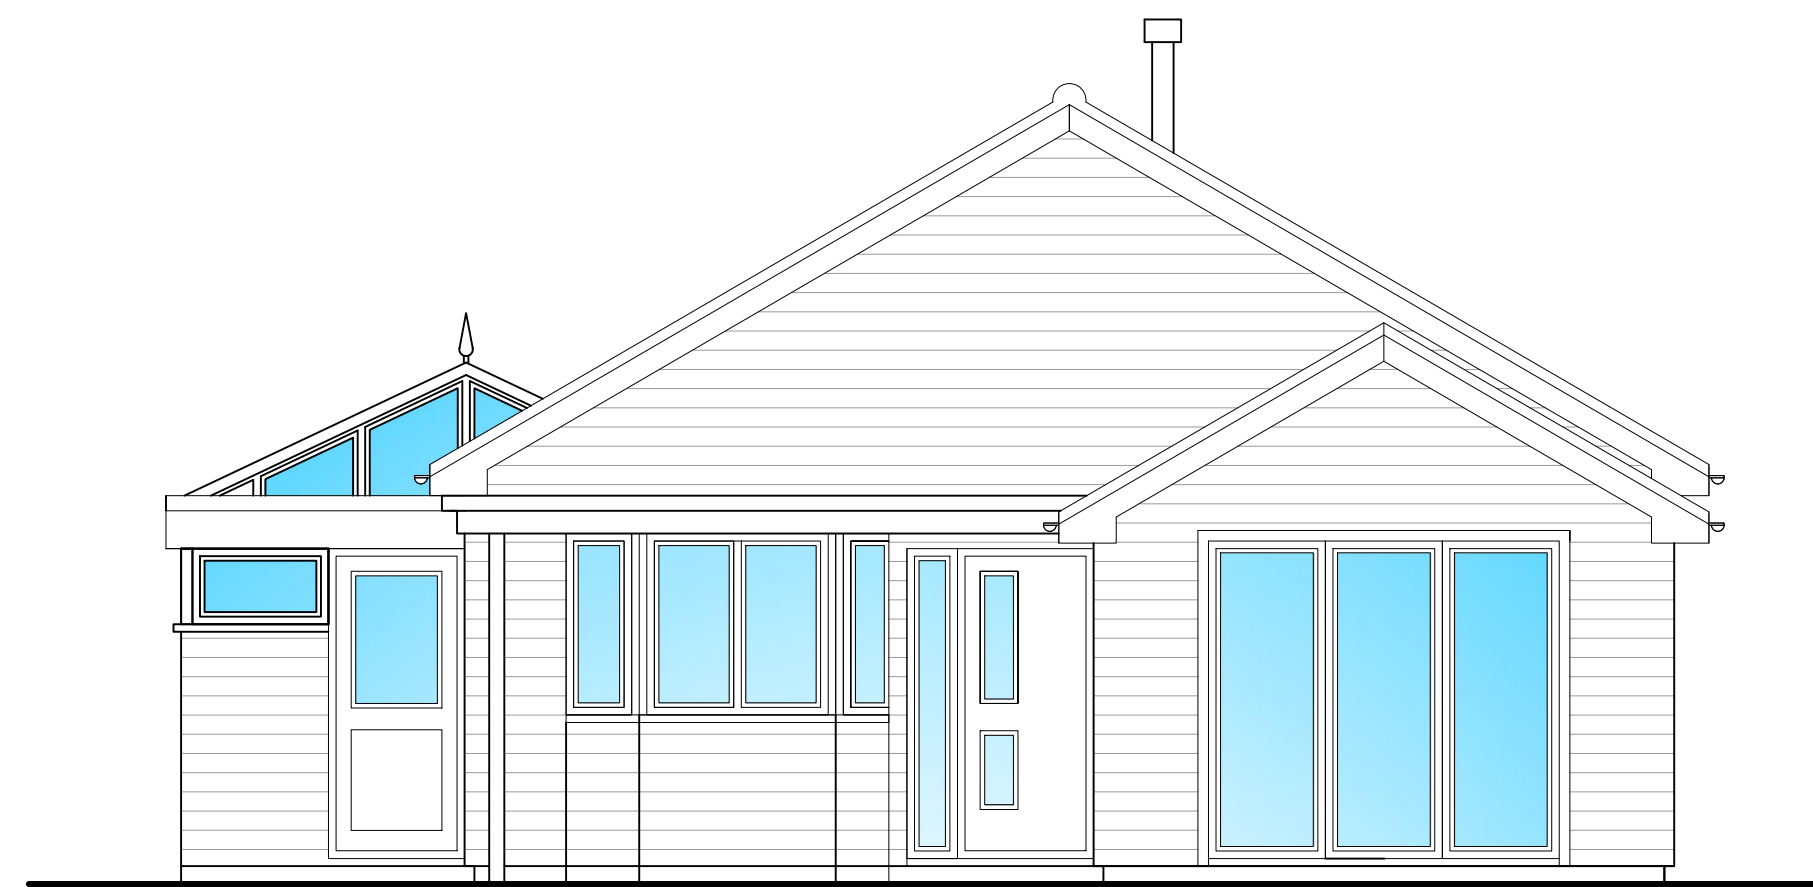

PRE EXISTING EAST ELEVATION 1:50

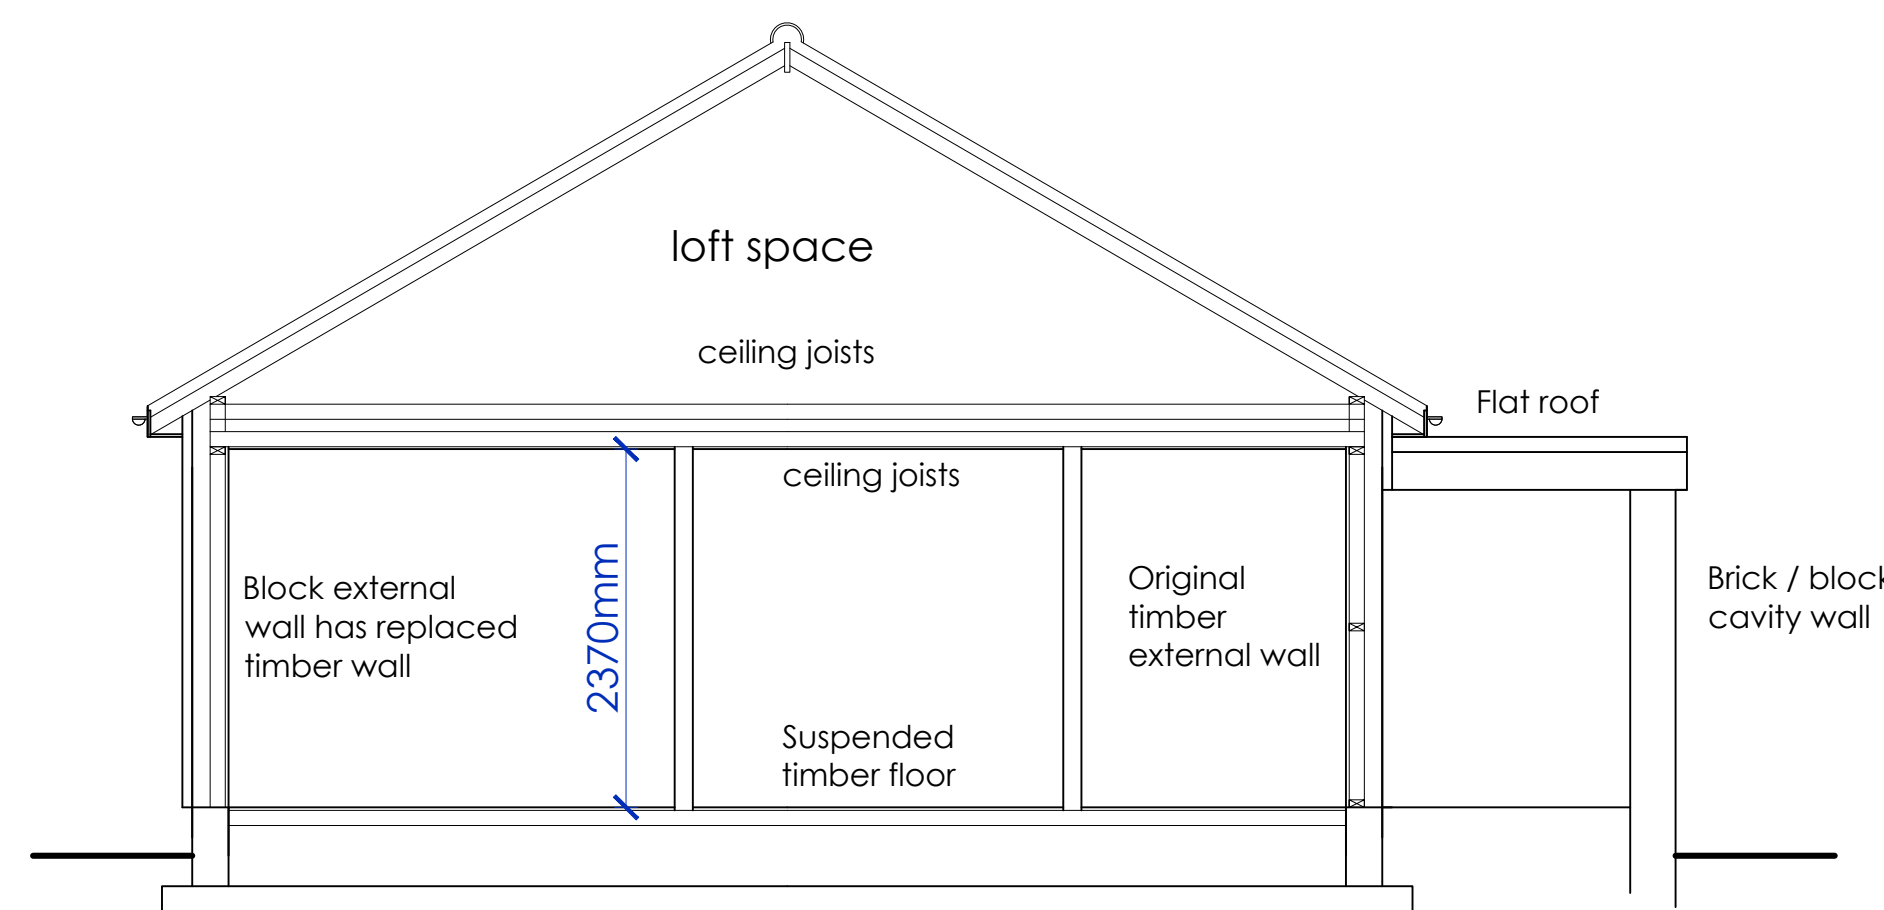

PRE EXISTING SECTION A:A 1:50

The client has advised that the existing timber frame dwelling is built on a 175mm concrete slab



PRE EXISTING SOUTH ELEVATION 1:100

PRE EXISTING WEST ELEVATION 1:100

PRE EXISTING EAST ELEVATION 1:100

PRE EXISTING NORTH ELEVATION 1:100

carl moore
— architectural design —

18 Parklands Avenue
Goring-By-Sea
West Sussex BN12 4NH

01903 533276
carl@cm-arch.co.uk

Address of Works: 21 QUEENS ROAD
LANCING
BN15 8ED

Drawing Title: LOFT CONVERSION (PRE EXISTING)

Paper Size/ Scale: A1

Date: MAY 24

Drawing Number: AD-241-01

Revision: Revision

General Notes:

- 1: Do not scale from these drawings (unless for planning purposes).
- 2: Drawings to be read in conjunction with the structural calculations and the building notes provided.
- 3: The client/ contractor is advised to read the separate notes and the details provided in the structural calculations regarding the CDM regulations.
- 4: The property owner is reminded to serve a Party Wall Notice on any adjoining owner should they need to do so under the requirements of the Party Wall Act 1996.
- 5: No work should be undertaken until all consents (Planning and Building Control) have been received and approved in writing. Any work undertaken without consent is done so at the clients risk.
- 6: All dimensions to be checked on site prior to ordering any materials, kitchens or bathrooms.
- 7: All existing foundations and lintels taking any additional loads are to be exposed and agreed with the Building Control Officer.