




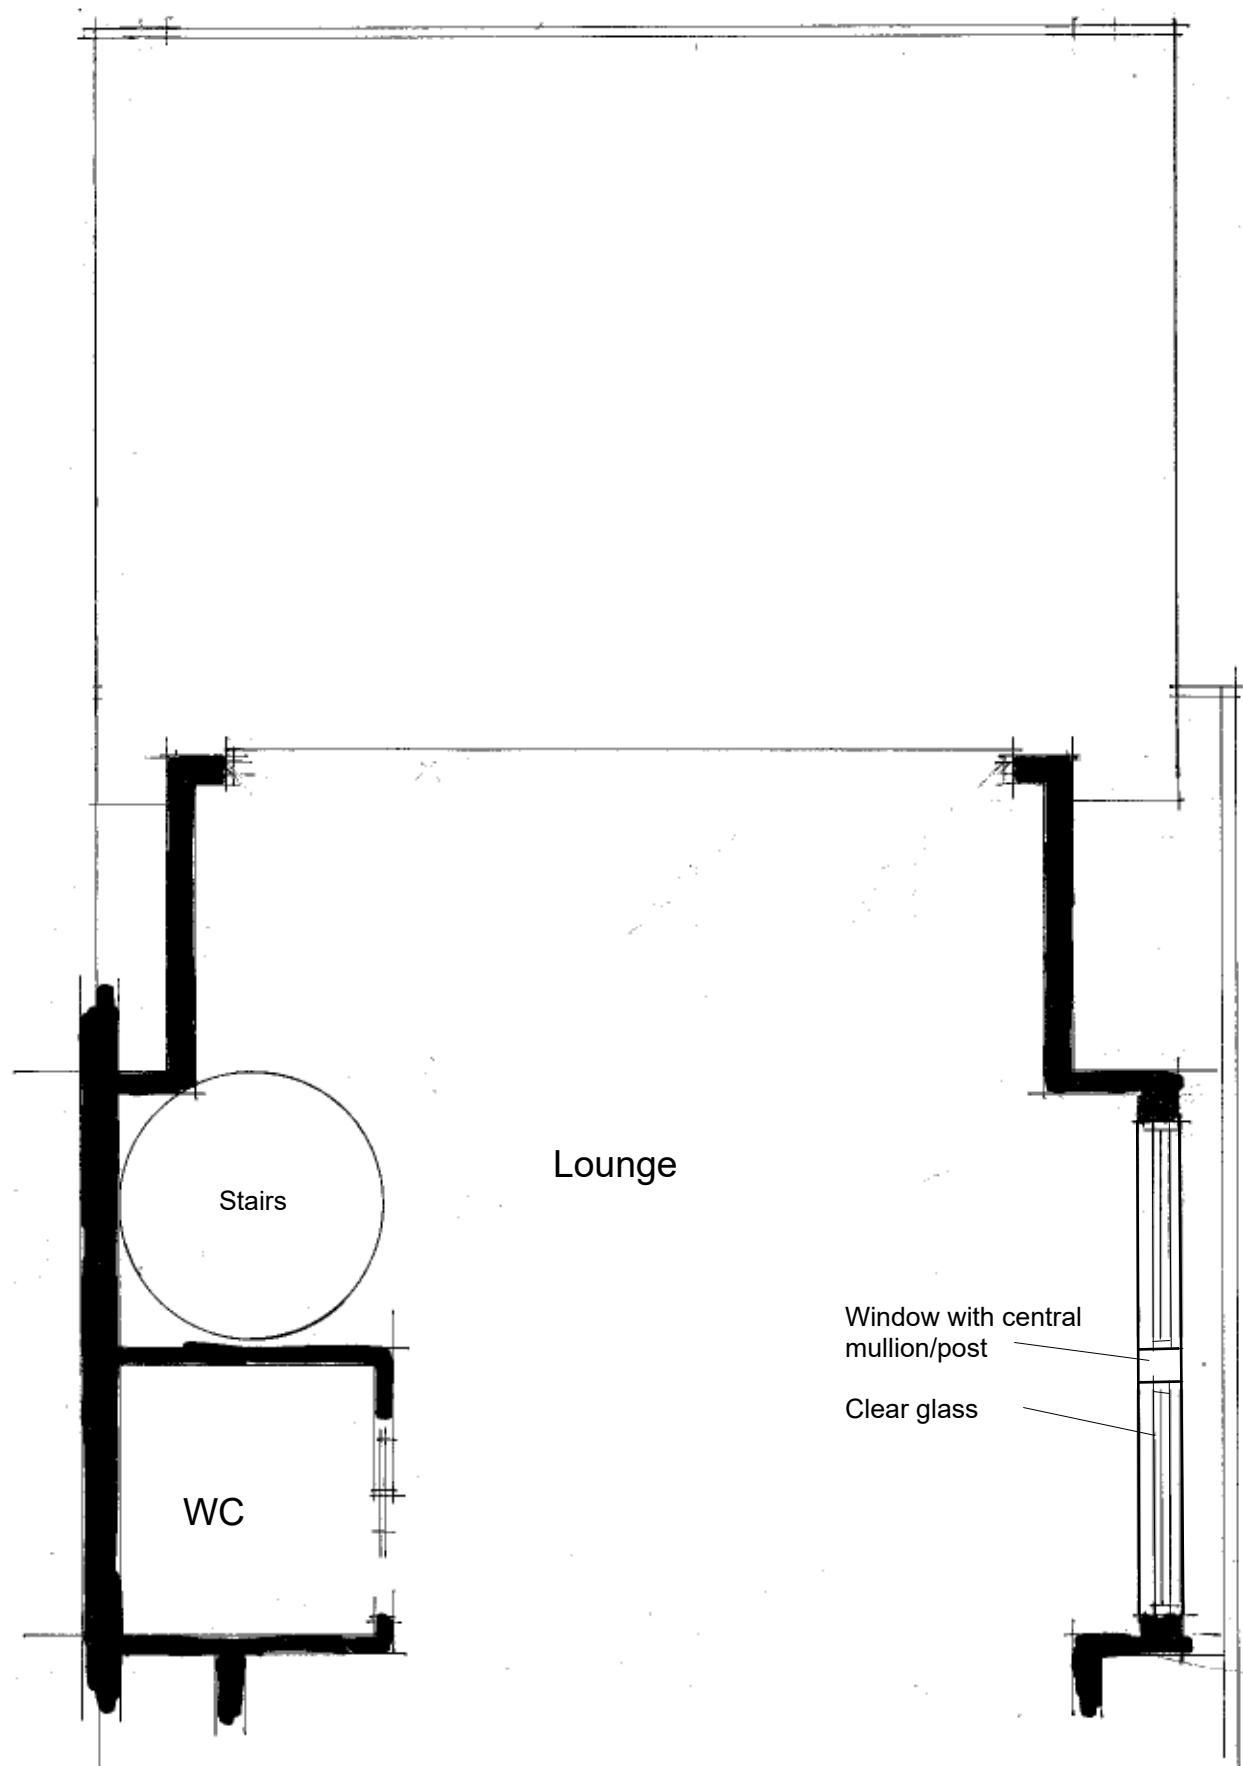

First floor plan 1:50

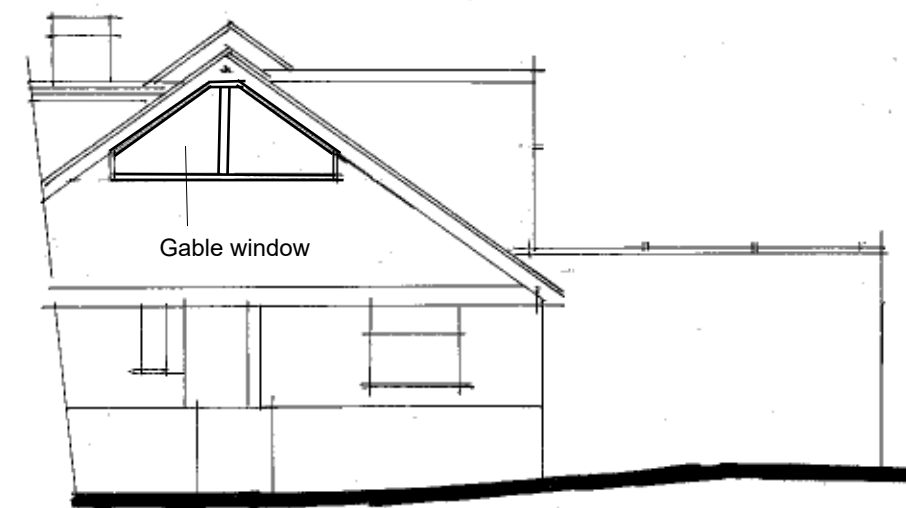

As built South 1:100

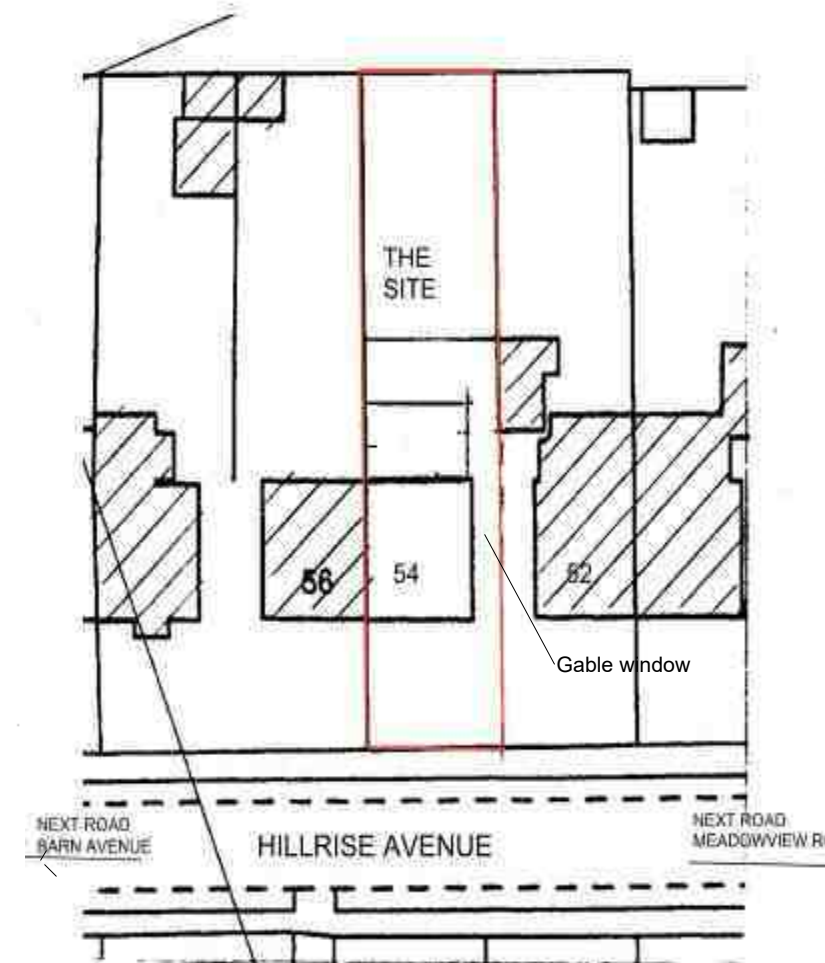

Block plan 1:500

54 Hillrise Avenue : Sompting : Lancing
Amendment to gable window

For Mr. M. Steele
Drawing 0326:3

