
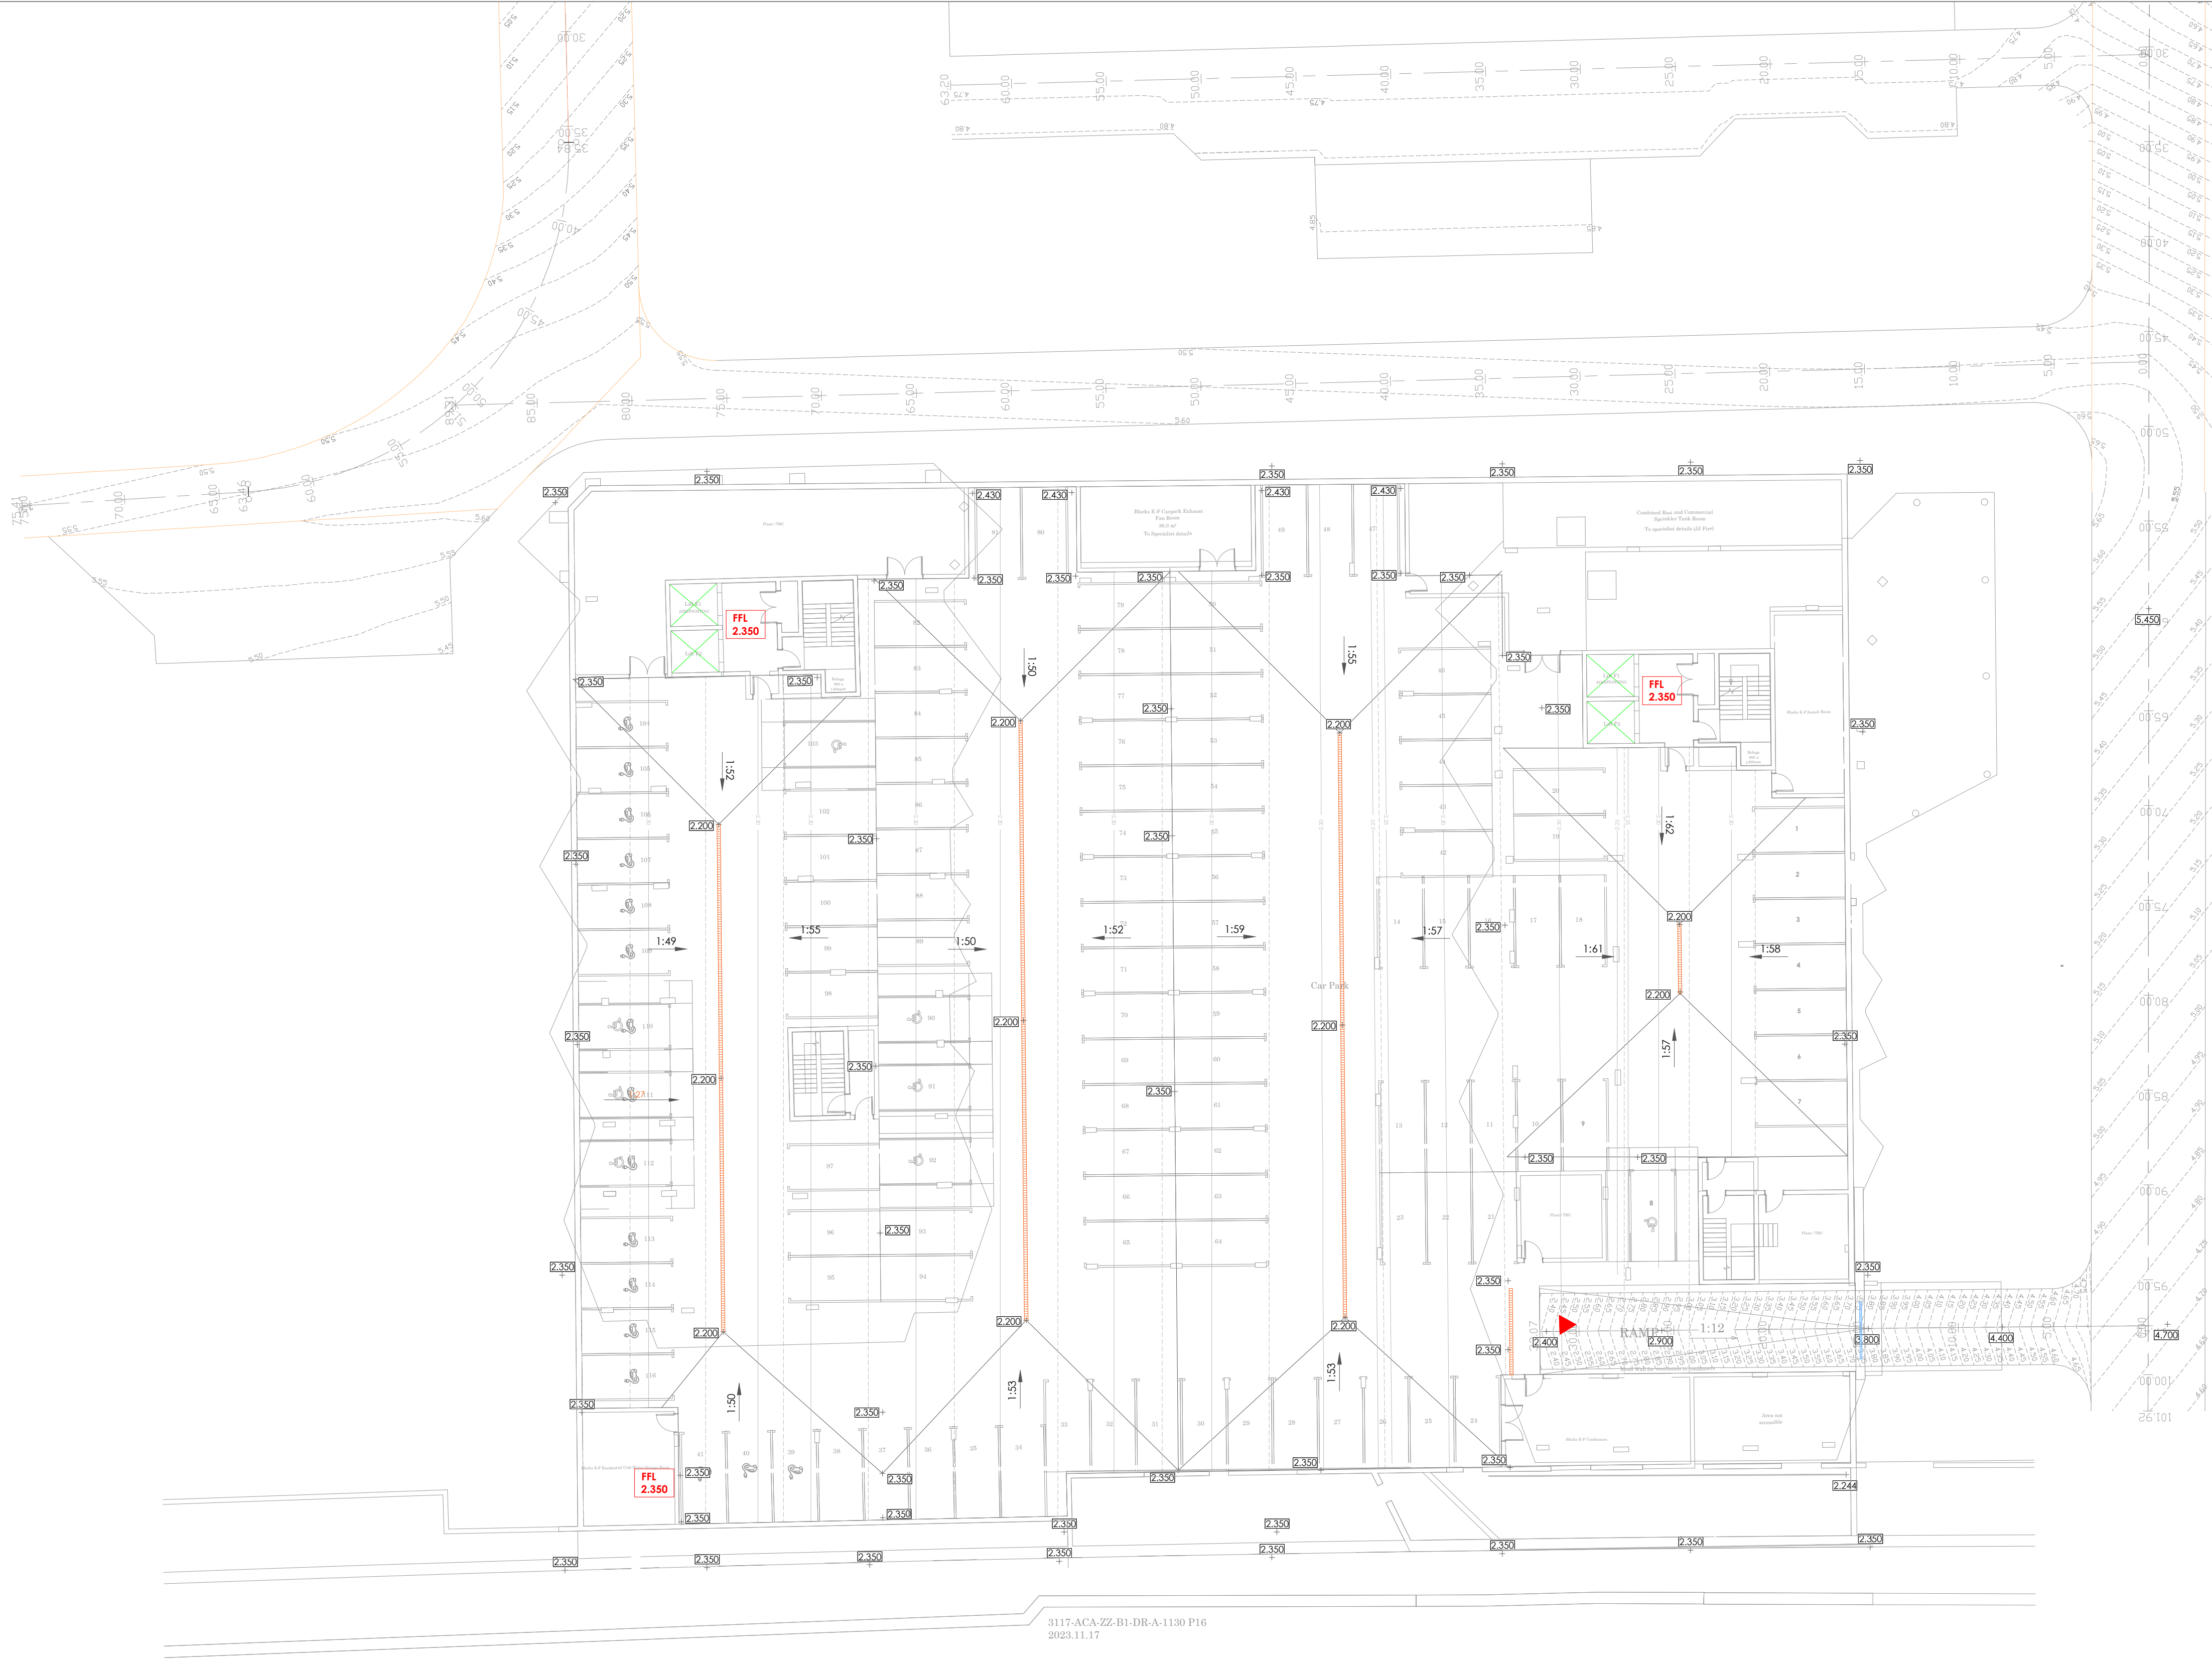


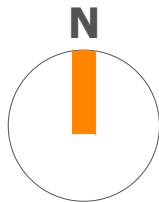

- NOTES:
- All dimensions and levels are in metres unless otherwise noted
 - This drawing is to be read in conjunction with the relevant Architect's/Engineer's drawings, specifications and CDM documentation
 - This drawings has been produced electronically and may have been photo reduced or enlarged when copied. Work to figured dimensions only (DO NOT SCALE). All dimensions to be checked on site. Any errors or omissions to be reported to the engineer immediately.
 - This drawing contains coloured lines / information that may not be clear if reproduced in black and white.
 - Digital copies of this plan can only be considered accurate if supplied directly by Iesis Special Structures Limited.

Levels Legend	
	Proposed level
	Existing survey level (by others)
	Existing level
	Proposed road contour & level
	Direction of slope and approximate fall
	Finished Floor Level (FFL)
	Building access - Primary

NOTE
Final Construction based upon notations provided by HG Construction. HG Construction to confirm layout correctly reflects works carried out on site

AS BUILT DRAWING
(THIS DRAWING IS THE FINAL
CONSTRUCTION ISSUE AND DOES
NOT PURPORT TO BE A SURVEY OF
THE WORKS AS CONSTRUCTED)

HG AS BUILT DRAWING
CONSTRUCTION HG CONSTRUCTION LIMITED

FC1	10.10.25	NJ/RJW	FINAL CONSTRUCTION ISSUE
REV	DATE	DRAWN/CHK	REVISION INFO
STATUS:			

FINAL CONSTRUCTION

CLIENT:
HG CONSTRUCTION

PROJECT:
Freewharf
Shoreham-by-Sea
BN43 6RE

DRAWING TITLE:
Levels Design Lower Ground Floor
(Sheet 1 of 1)

JOB NUMBER:	SCALE AT A1:	REV. STATUS:
SE2002	1:200	A

DRAWING NUMBER:	REVISION:
ISS-XX-02-DR-C-3202	FC1

LONDON 20 IRONMONGER LANE | LONDON | EC2V 8EP | UK
T: +44 (0)207 600 2912
BRISTOL 89-95 REDCLIFFE STREET | BRISTOL | BS1 6LU | UK
T: +44 (0)117 922 7039
www.iesisgroup.com

IESISSTRUCTURES