


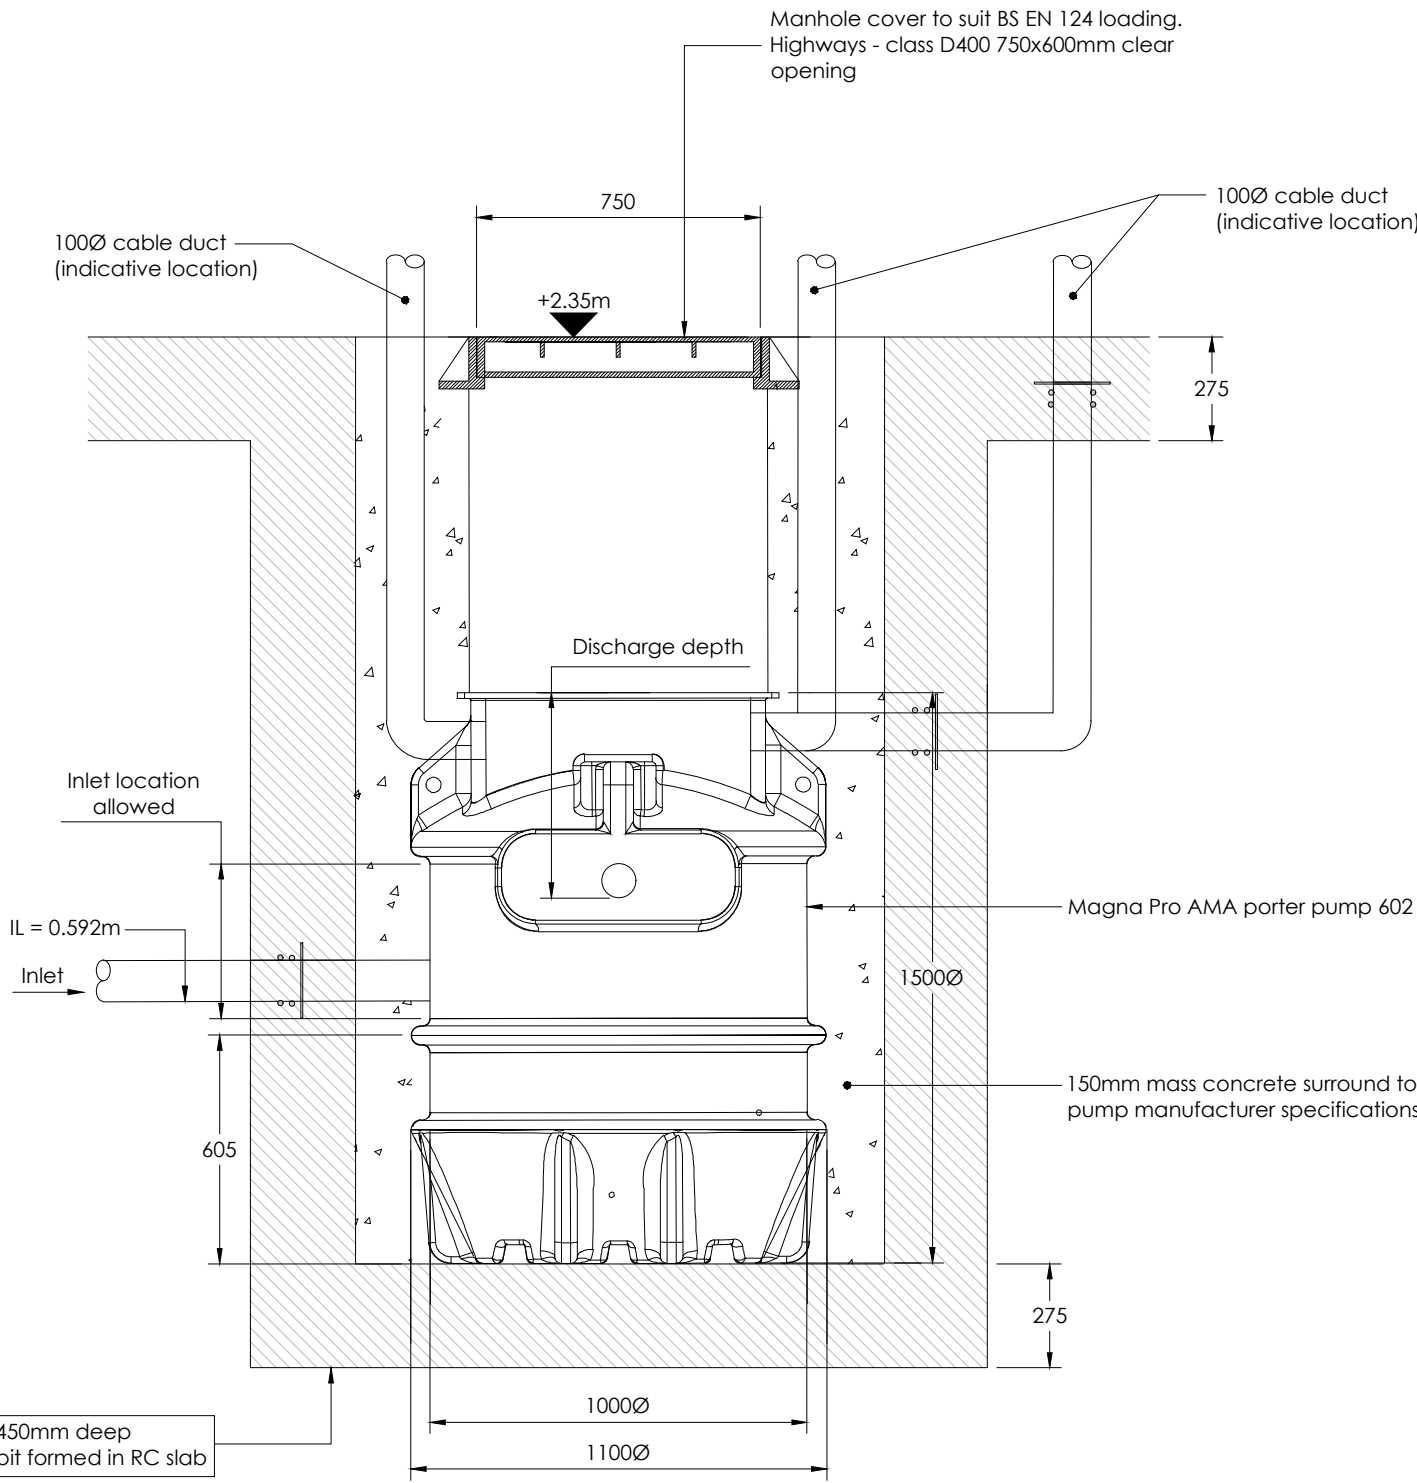

CAR PARK PUMP CP1.2

(Pump details based on Edincare Pumps Specification Reference JC2060)

NOTES:

- All dimensions and levels are in metres unless otherwise noted
- This drawing is to be read in conjunction with the relevant Architect's/Engineer's drawings, specifications and CDM documentation
- This drawings has been produced electronically and may have been photo reduced or enlarged when copied. Work to figured dimensions only (DO NOT SCALE). All dimensions to be checked on site. Any errors or omissions to be reported to the engineer immediately.
- This drawing contains coloured lines / information that may not be clear if reproduced in black and white.
- Digital copies of this plan can only be considered accurate if supplied directly by Iesis Special Structures Limited.

NOTE
Final Construction based upon notations provided by HG Construction. HG Construction to confirm layout correctly reflects works carried out on site

AS BUILT DRAWING
(THIS DRAWING IS THE FINAL
CONSTRUCTION ISSUE AND DOES
NOT PURPORT TO BE A SURVEY OF
THE WORKS AS CONSTRUCTED)

HG AS BUILT DRAWING
CONSTRUCTION HG CONSTRUCTION LIMITED

FC1	10.10.25	NJ/RJW	FINAL CONSTRUCTION ISSUE
REV	DATE	DRAWN/CHK	REVISION INFO
STATUS:			
FINAL CONSTRUCTION			
CLIENT:			
HG CONSTRUCTION			
PROJECT:			
Freewharf Shoreham-by-Sea BN43 6RE			
DRAWING TITLE:			
Drainage Construction Details (Sheet 3 of 3)			
JOB NUMBER:		SCALE AT A1:	REV. STATUS:
SE2002		NTS	A
DRAWING NUMBER:			REVISION:
ISS-XX-XX-DR-C-3402			FC1
LONDON		20 IRONMONGER LANE LONDON EC2V 8EP UK T: +44 (0)207 600 2912	
BRISTOL		89-95 REDCLIFFE STREET BRISTOL BS1 6LU UK T: +44 (0)117 922 7039	
www.iesisgroup.com			