




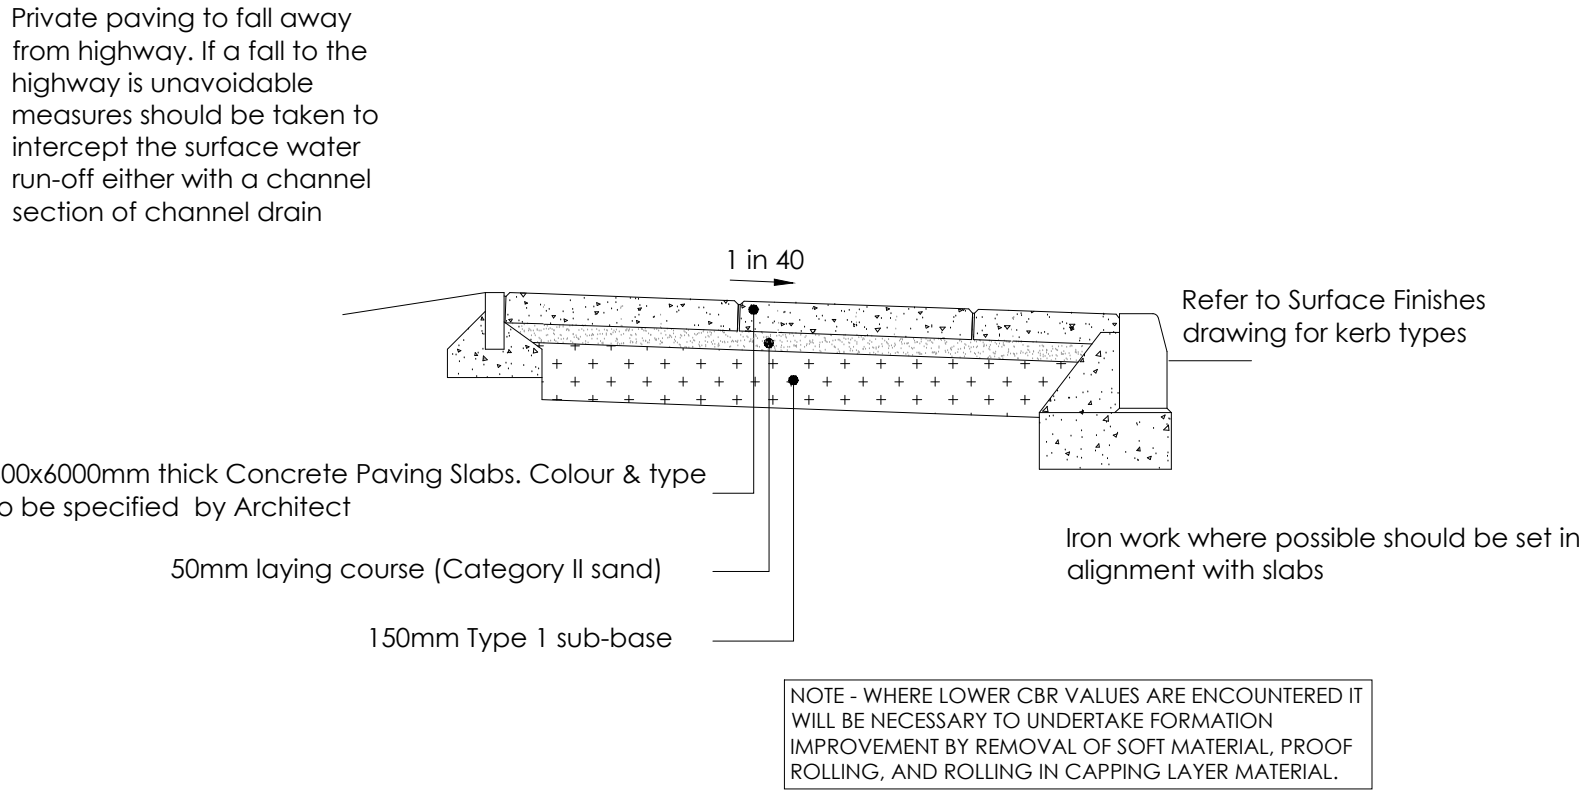


SLABBED SURFACING FOOTPATH/PATIO - P9

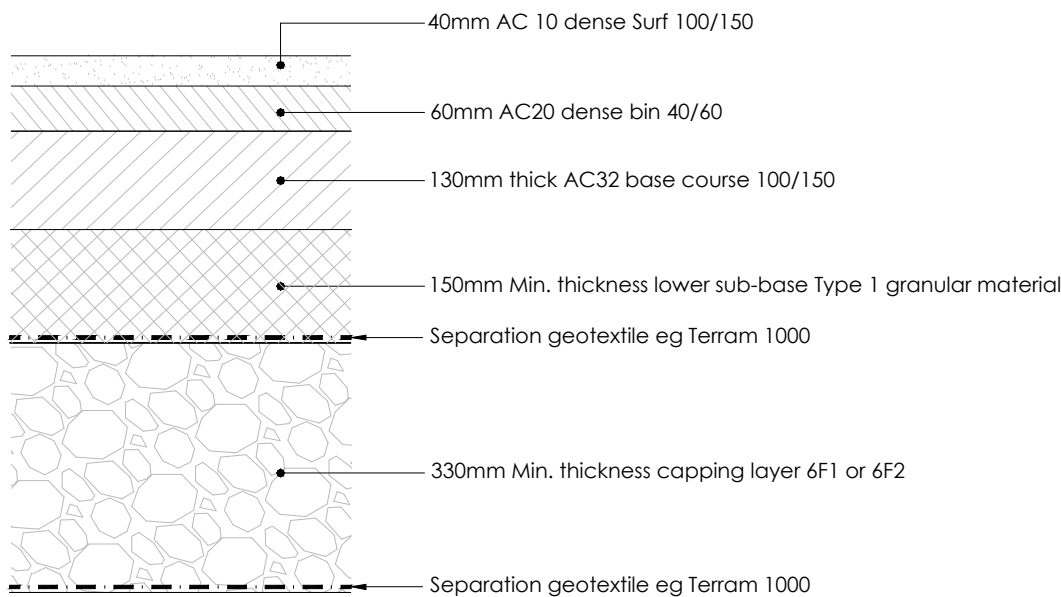


ASPHALT CONCRETE ROAD DETAIL - P1

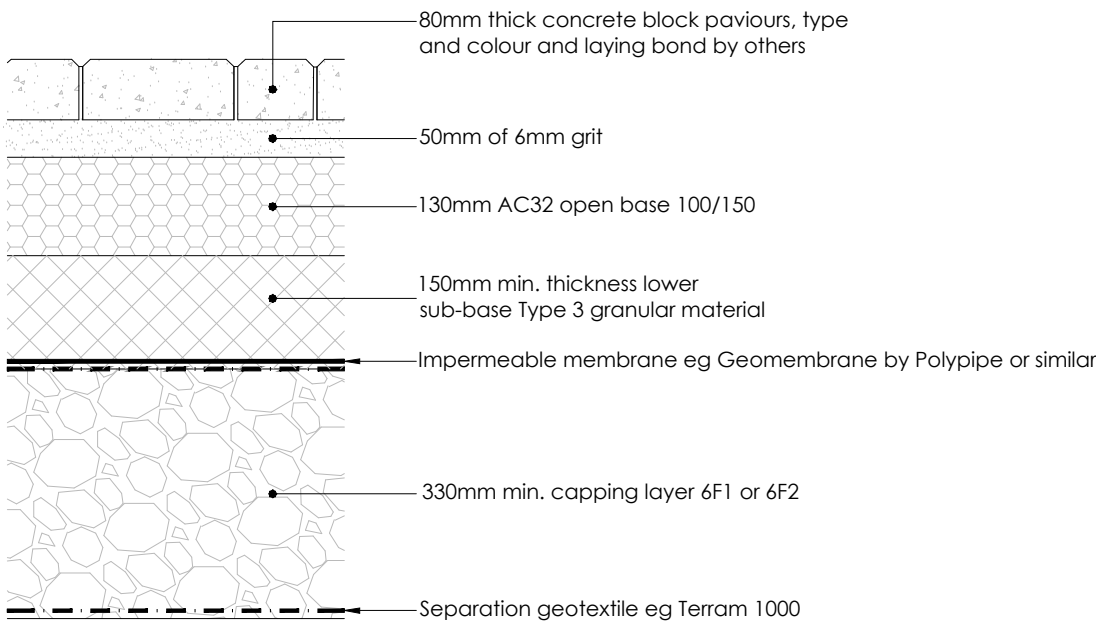

BLOCK PAVIOUR SURFACING PRIVATE ROAD - P3/P4/P5/P6/P8
eg Private Road, Refuse vehicles

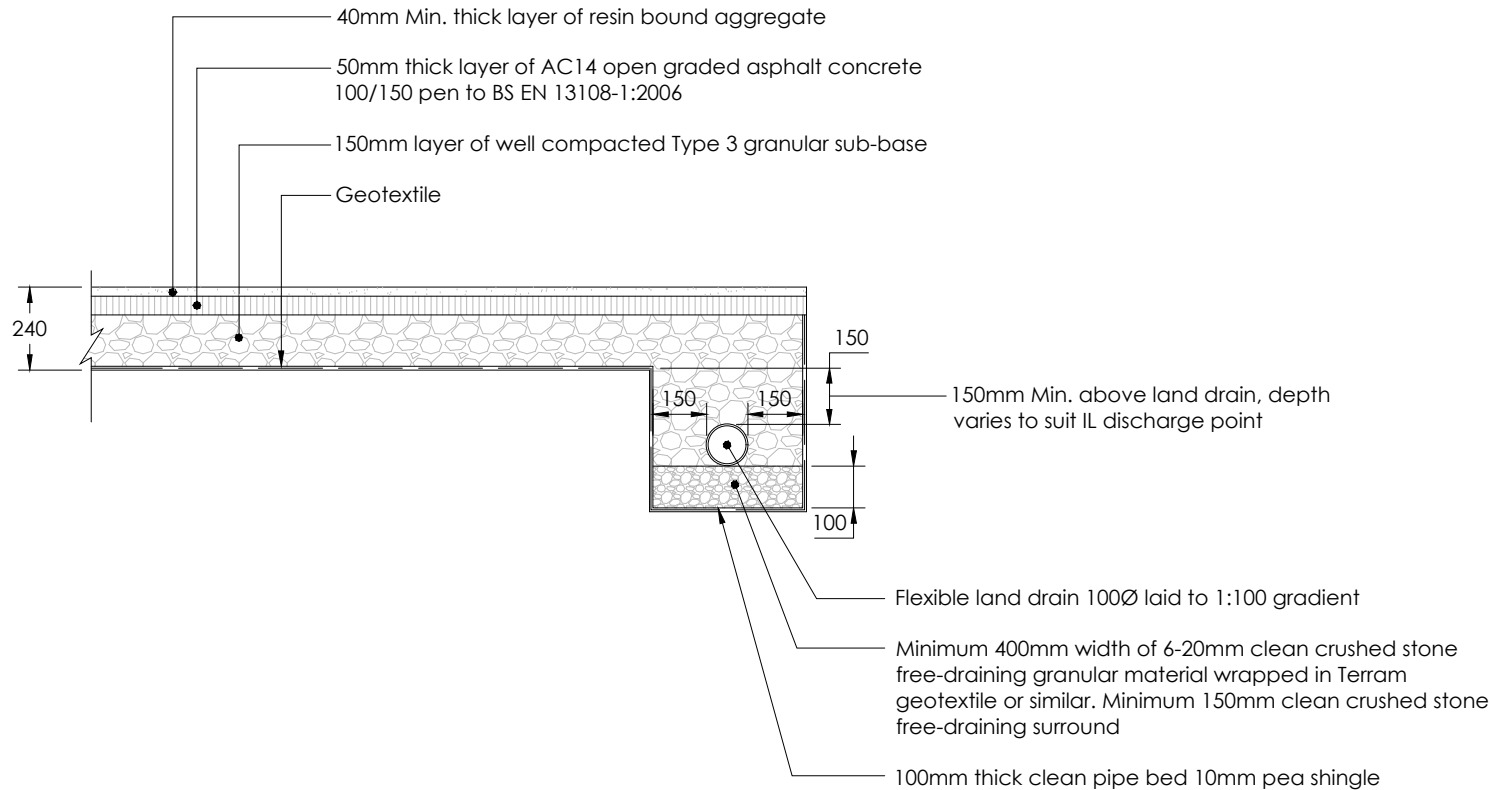

POROUS RESIN BOUND GRAVEL FOOTPATH WITH LAND DRAIN - P7
(Non-trafficked above made up ground)

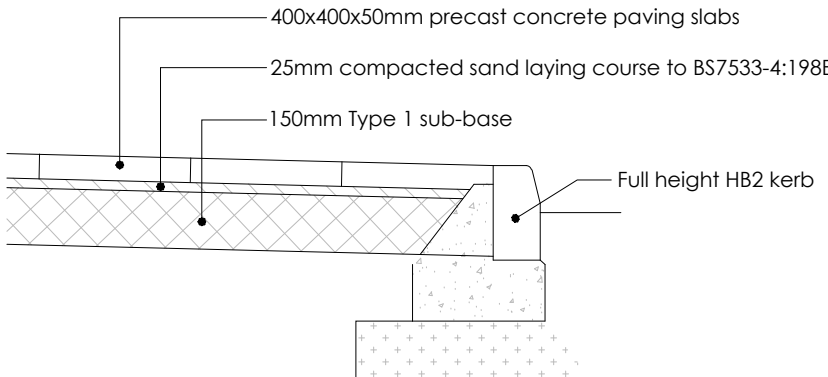

HIGHWAYS PRECAST CONCRETE PAVING FLAGS
FOOTWAY CONSTRUCTION DETAIL - P9

NOTE
Refer to Allen Pyke drawings for locations

- NOTES:
- All dimensions and levels are in metres unless otherwise noted
 - This drawing is to be read in conjunction with the relevant Architect's/Engineer's drawings, specifications and CDM documentation
 - This drawings has been produced electronically and may have been photo reduced or enlarged when copied. Work to figured dimensions only (DO NOT SCALE). All dimensions to be checked on site. Any errors or omissions to be reported to the engineer immediately.
 - This drawing contains coloured lines / information that may not be clear if reproduced in black and white.
 - Digital copies of this plan can only be considered accurate if supplied directly by Iesis Special Structures Limited.

NOTE
Final Construction based upon notations provided by HG Construction, HG Construction to confirm layout correctly reflects works carried out on site

AS BUILT DRAWING
(THIS DRAWING IS THE FINAL CONSTRUCTION ISSUE AND DOES NOT PURPORT TO BE A SURVEY OF THE WORKS AS CONSTRUCTED)

IESIS
STRUCTURES

HG

CONSTRUCTION

AS BUILT DRAWING

HG CONSTRUCTION LIMITED

FC1

10.10.25

NJ/RJW

FINAL CONSTRUCTION ISSUE

REV

DATE

DRAWN/CHK

REVISION INFO

STATUS:

FINAL CONSTRUCTION

CLIENT:

HG CONSTRUCTION

PROJECT:

Freewharf - Phase 2

Shoreham-by-Sea

BN43 6RE

DRAWING TITLE:

Road Construction Details

(Sheet 1 of 2)

JOB NUMBER:

SE2002

SCALE AT A1:

NTS

REV. STATUS:

A

DRAWING NUMBER:

ISS-XX-02-DR-C-3405

REVISION:

FC1

LONDON

20 IRONMONGER LANE | LONDON | EC2V 8EP | UK

T: +44 (0)207 600 2912

BRISTOL

89-95 REDCLIFFE STREET | BRISTOL | BS1 6LU | UK

T: +44 (0)117 922 7039

www.iesisgroup.com