




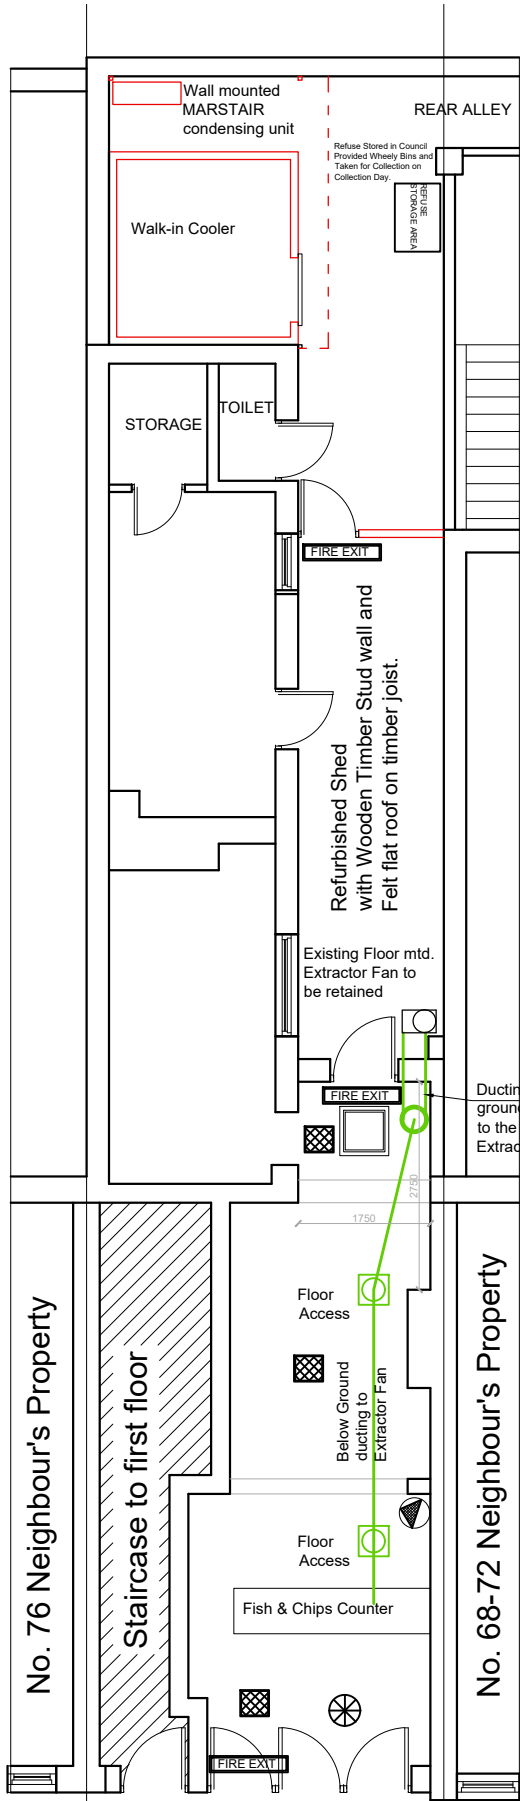

EXISTING GROUND FLOOR PLAN
AS BUILT

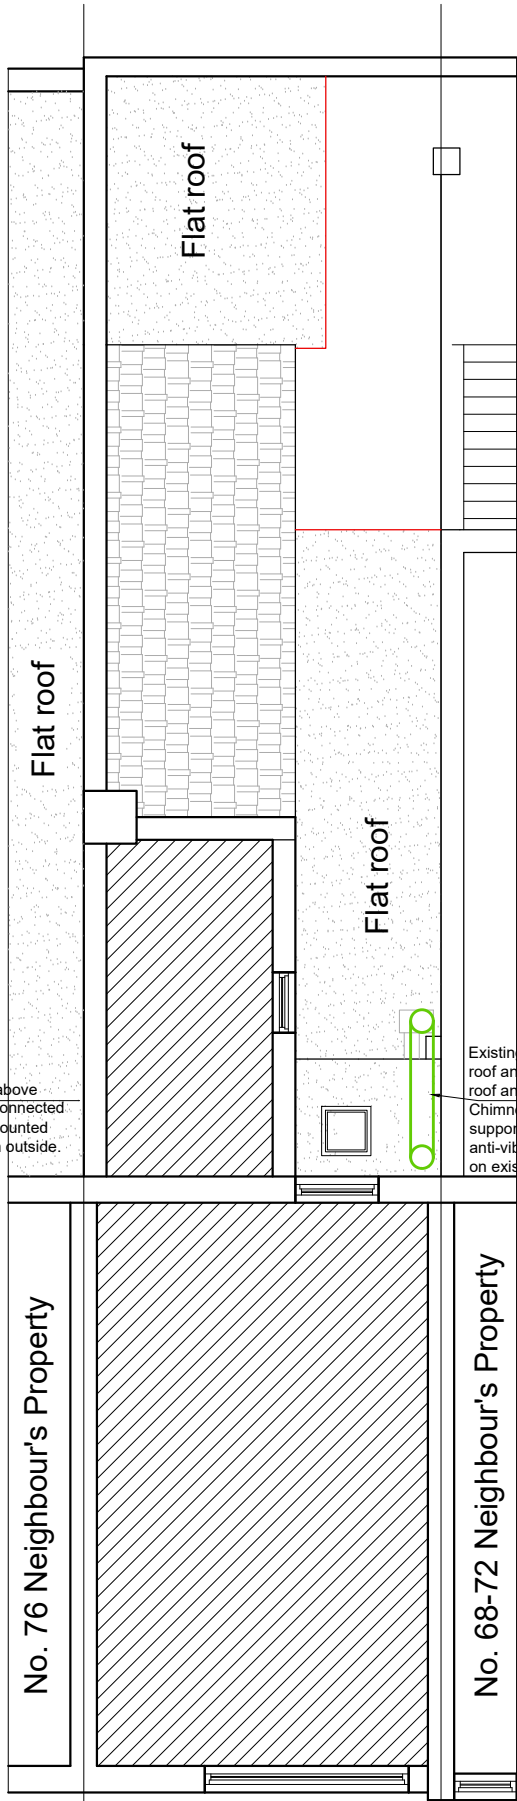

EXISTING FIRST FLOOR PLAN
AS BUILT

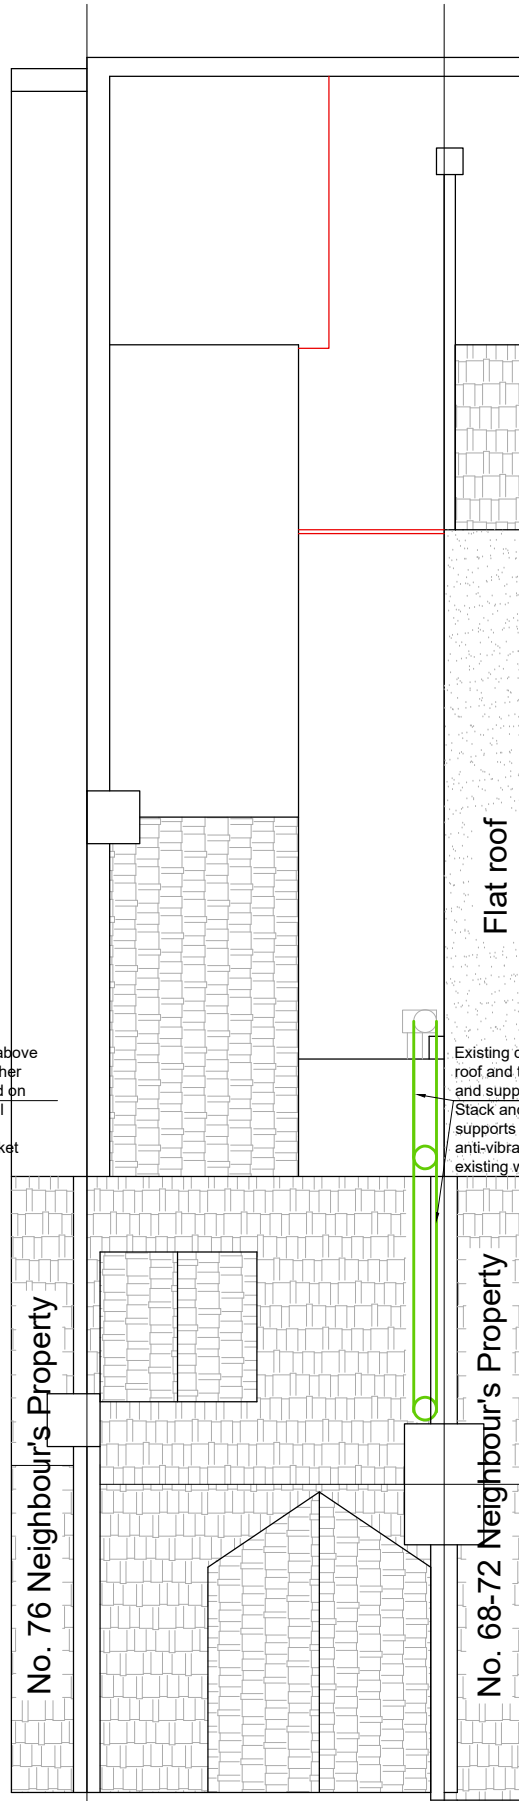

EXISTING ROOF PLAN
AS BUILT



Drawn By	NS	Title PROPOSED INSTALLATION OF NEW EXTRACTION SYSTEM WITH ADDITIOANL FLUE PIPE RISER AT REAR ELEVATION. RETROSPECTIVE APPLICATION FOR REFURBISHED SHED AND NEW WALK IN COOLER ROOM AT THE REAR	Client: Mr RAJAN MANICKAM 74 HEENE ROAD WORTHING BN11 3RG	Keeran Designs Ltd Tel: (020) 8531 6000 Fax : (020) 8531 5444 E mail : Keeran@ consultant.com Web :www.keerandesigns.co.uk
Dr.No-	KD/REFURB/PP/63/25/H-255.2			
Date	January 2026			
Scale	1:100 @ A3 Paper			