




Site Plan
1 : 750



Location Plan
1 : 1250

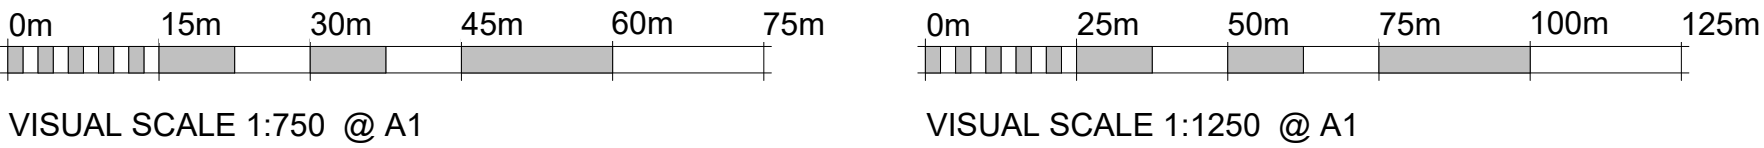

- Notes:
1. THE COPYRIGHT OF THIS DRAWING IS VESTED IN ARCHEVOLVE AND IT MAY NOT BE REPRODUCED IN WHOLE OR PART OR USED FOR THE MANUFACTURE OF ANY ARTICLE WITHOUT THE EXPRESS PERMISSION OF THE COPYRIGHT HOLDERS.
 2. WORK TO FIGURED DIMENSIONS ONLY.
 3. THIS DRAWING IS TO BE READ IN CONJUNCTION WITH ALL RELEVANT ARCHITECT'S, SERVICE ENGINEER'S AND ARCHEVOLVE AND SPECIFICATIONS.

- Developable Area
- Site Boundary
- Location of Existing Sheds
- Tree Locations
- Hedge Locations



Rev_A	Updated Plans for Validation		AP	01/07/26
Revision Number	Revision Description		Issued by	Revision Date
DATE:	STATUS:	SHEET SIZE:		
06/10/25	PLANNING ISSUE	A1		
SCALE:	DRAWN:	CHECKED:		
As indicated	AP			
CLIENT:		SITE ADDRESS:		
Courtlands				

DRAWING:
Change of Use

TITLE:
As Built Location &
Site Plan

REVISION:
Rev_A

DRAWING NO:
APC/012/26/06

PROJECT NO:
Courtlands



ARCHEVOLVE

// design @archevolve.co.uk

// www. archevolve.co.uk

// 01798 879894

