


Part Ground Floor - 1:50

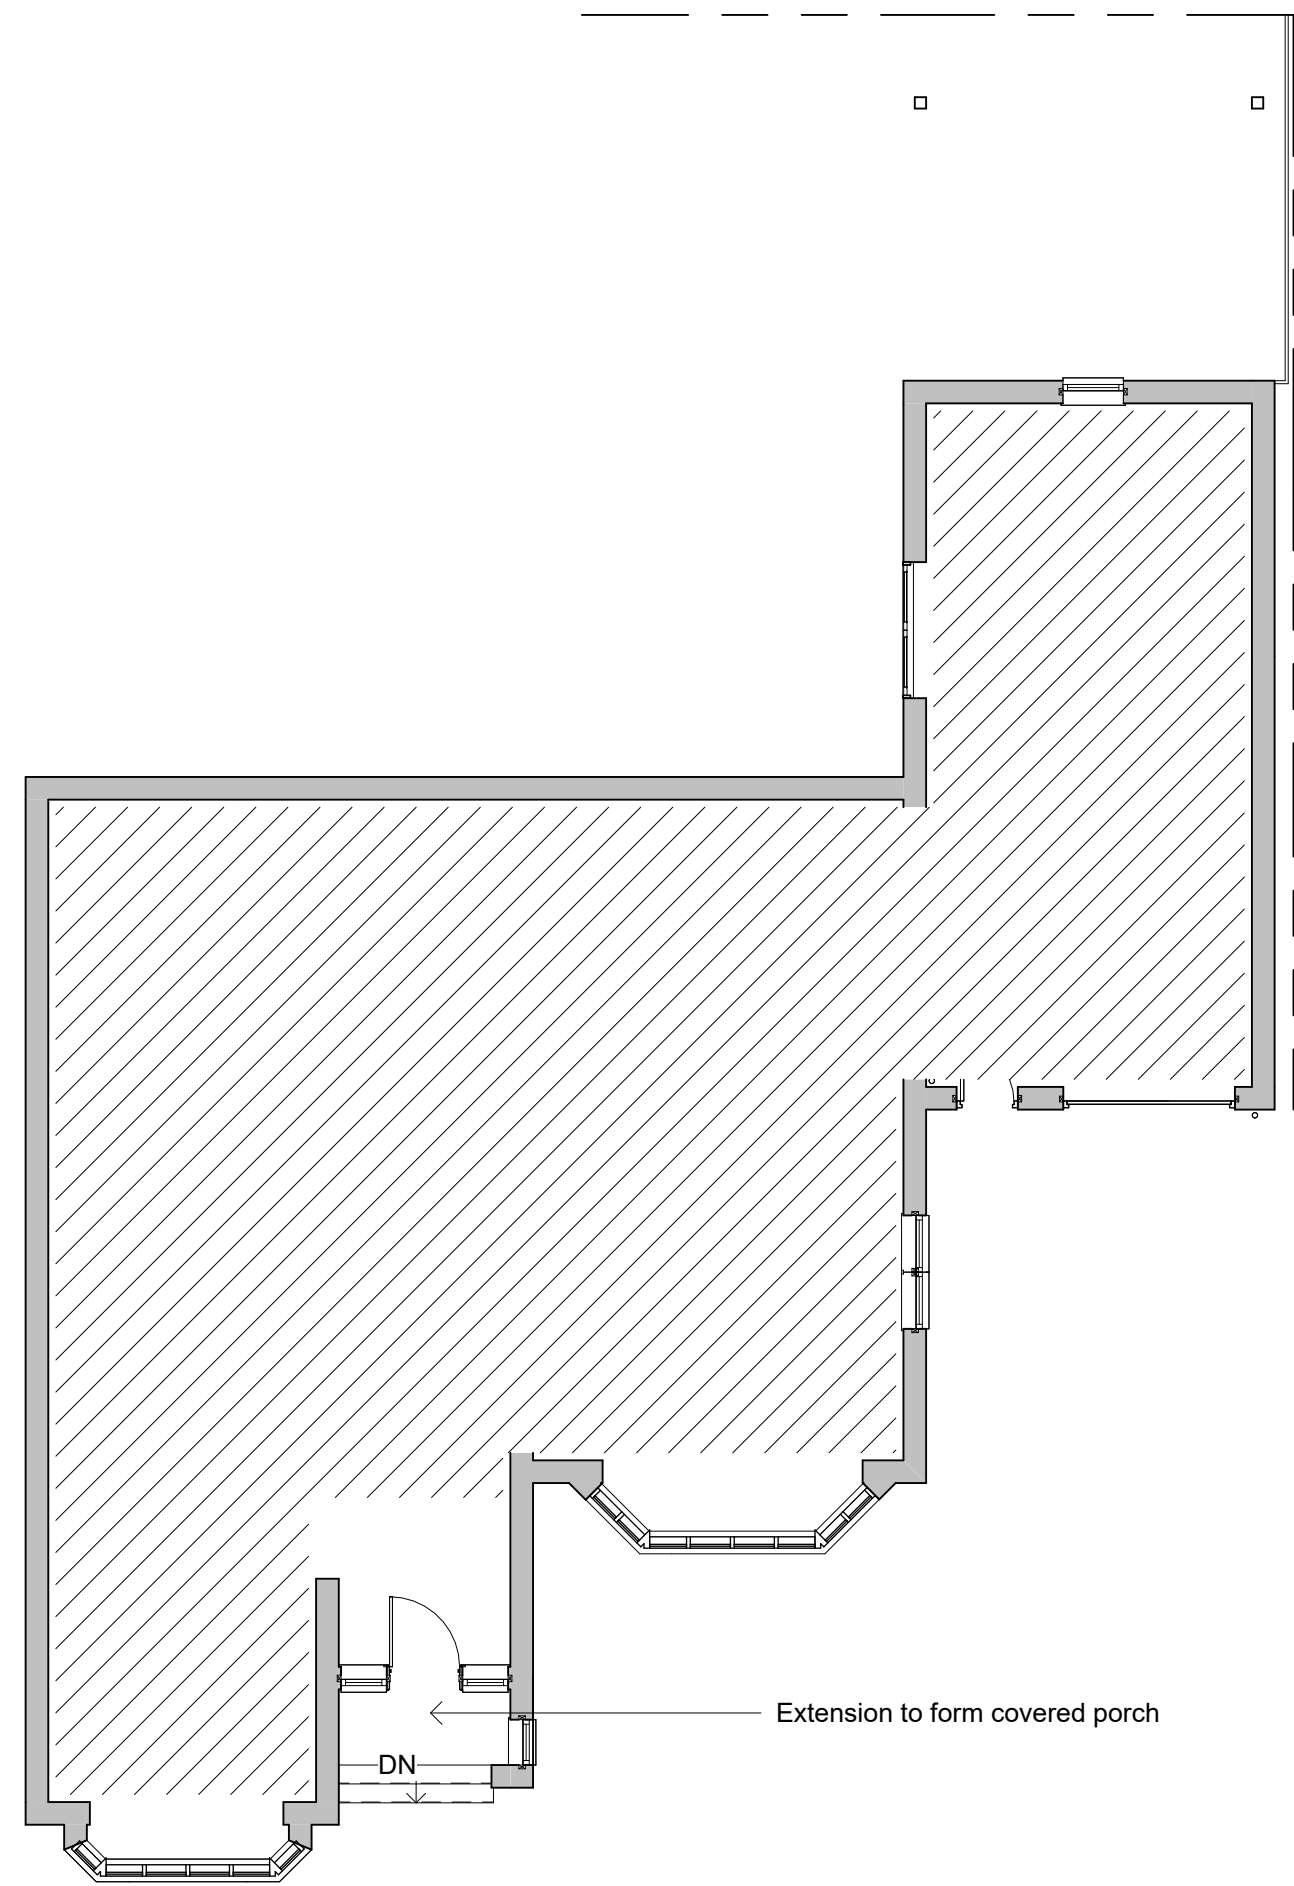

Side Elevation - West


1:100



Front Elevation - South





Side Elevation - East

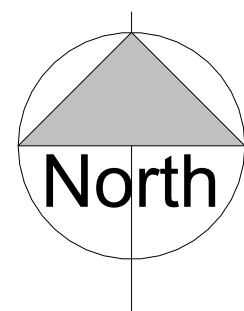


Site Plan 1:500

Site Plan 1:1250

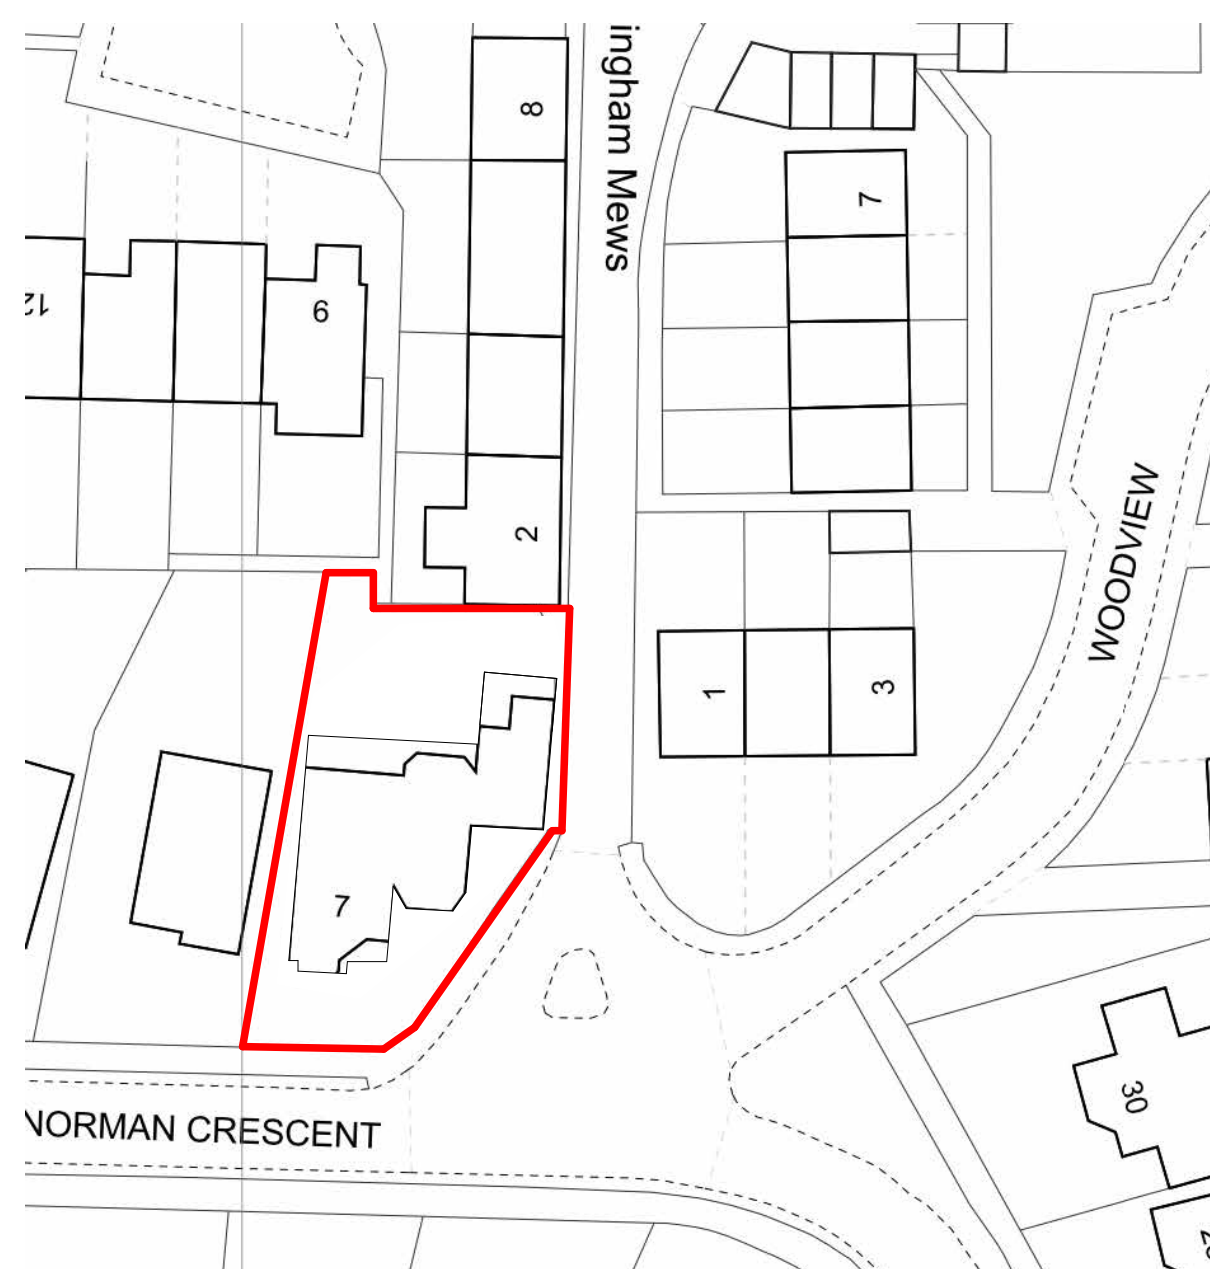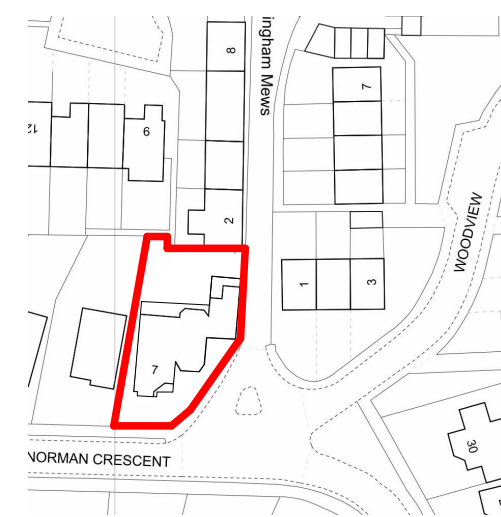

Revisions

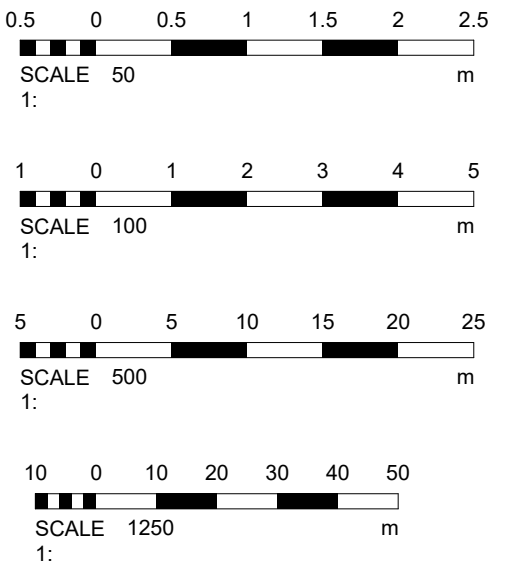

Materials

Drawing Number 2026/171 Sheet 1 of 1

Size A1 Scale 1:50, 1:100, 1:500, 1:1250

Project
As built
September 2026

Job Title
7 Norman Crescent
Shoreham by sea
BN43 6AH

Do Not scale from this drawing except for planning as photocopies will be subject to distortion
Drawings to be read in conjunction with all other Designers and structural engineers contract drawings and specifications:
Any discrepancies must be brought to the attention of the Designer immediately.
The contractor must verify all dimensions by site measurement before ordering materials or manufacturing components
Substitute materials and products to those named will be acceptable if proven to be of equal or higher performance and not in conflict with other elements

M.J.Humphrey
Ltd



Mel Humphrey MRICS, MBEng
9 Aldsworth Avenue
Goring By Sea
West Sussex
BN12 4XQ
Adam Humphrey
4 Thalassa Road
Worthing
West Sussex
BN11 2HH

Mel@mjhumphrey.co.uk 07701055182 Adam@mjhumphrey.co.uk 07812419142