




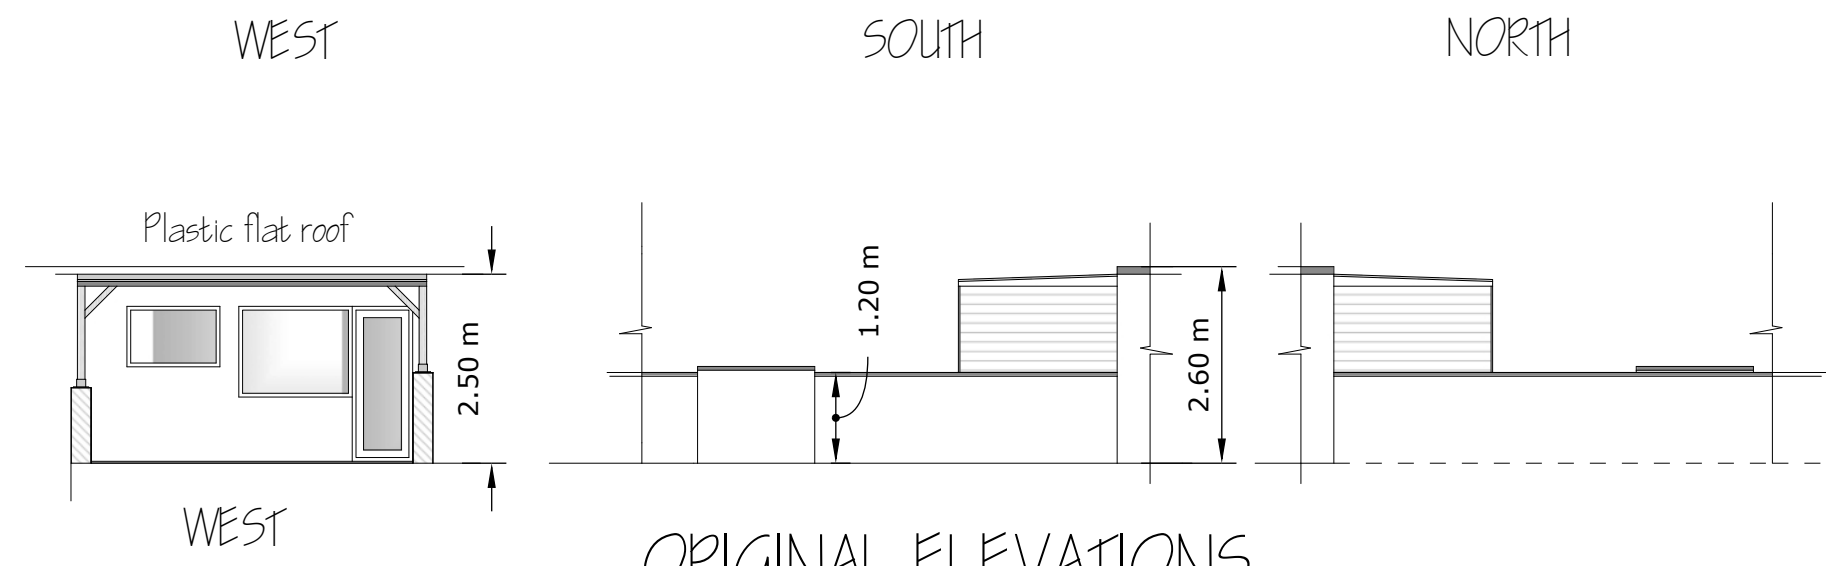


ORIGINAL ELEVATIONS

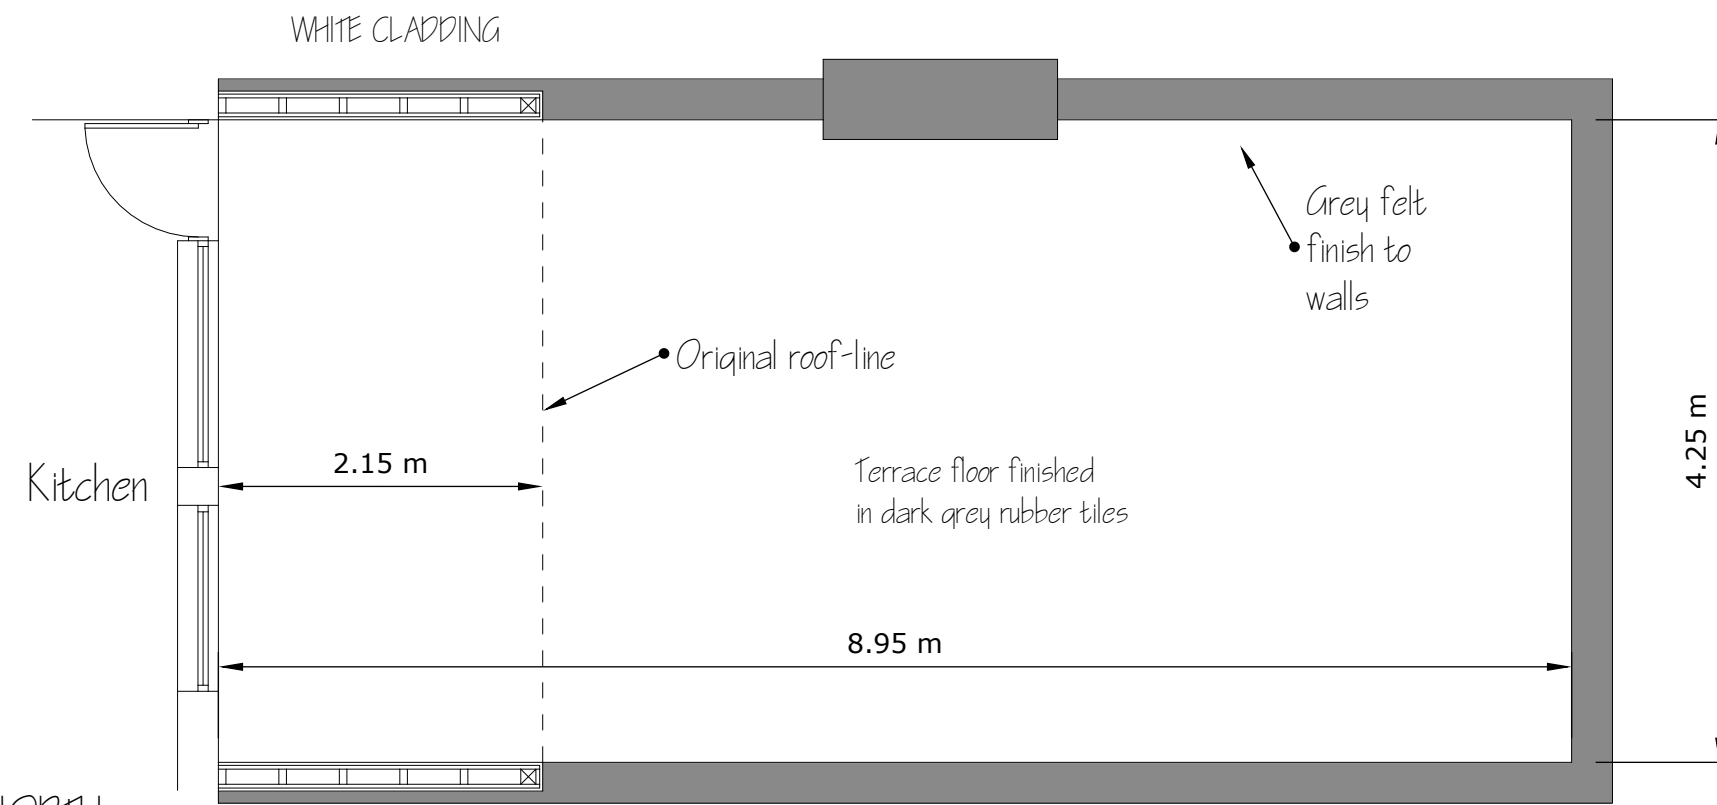


ORIGINAL PLAN VIEW

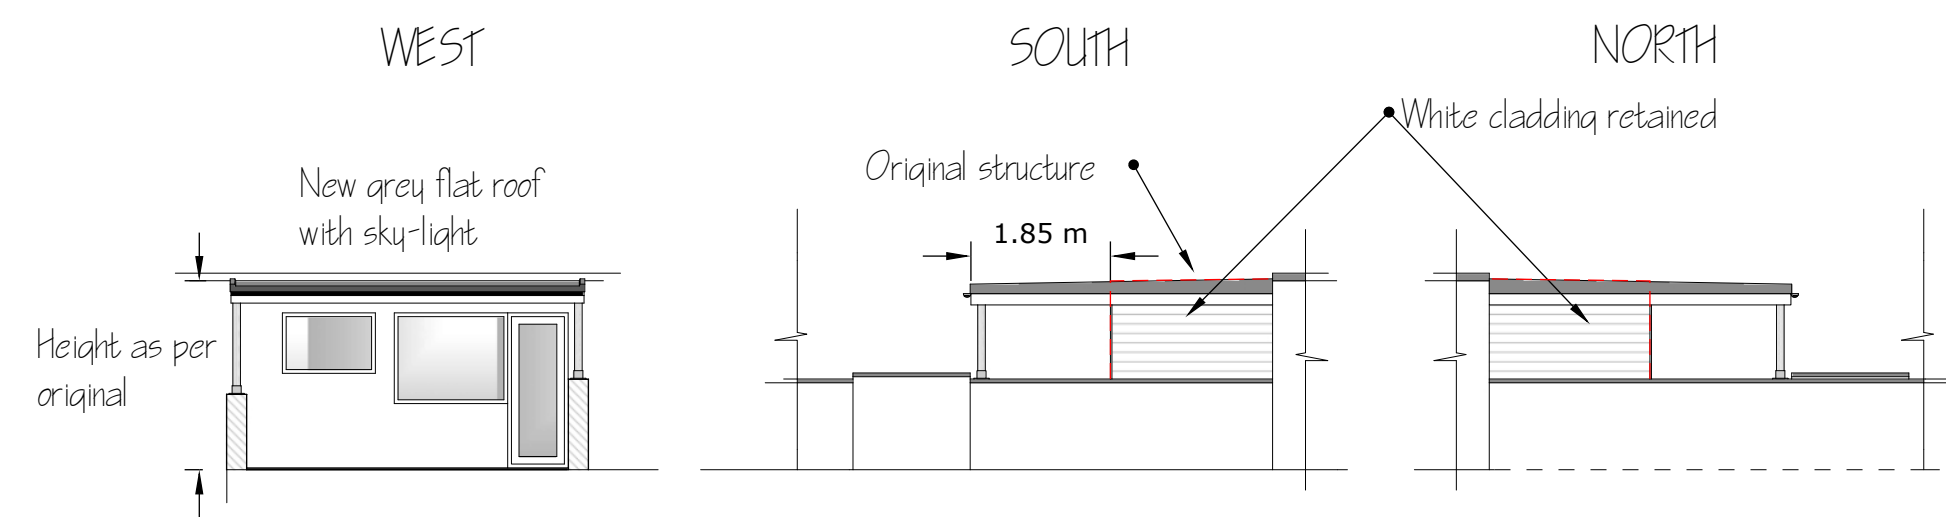






AS-BUILT ELEVATIONS

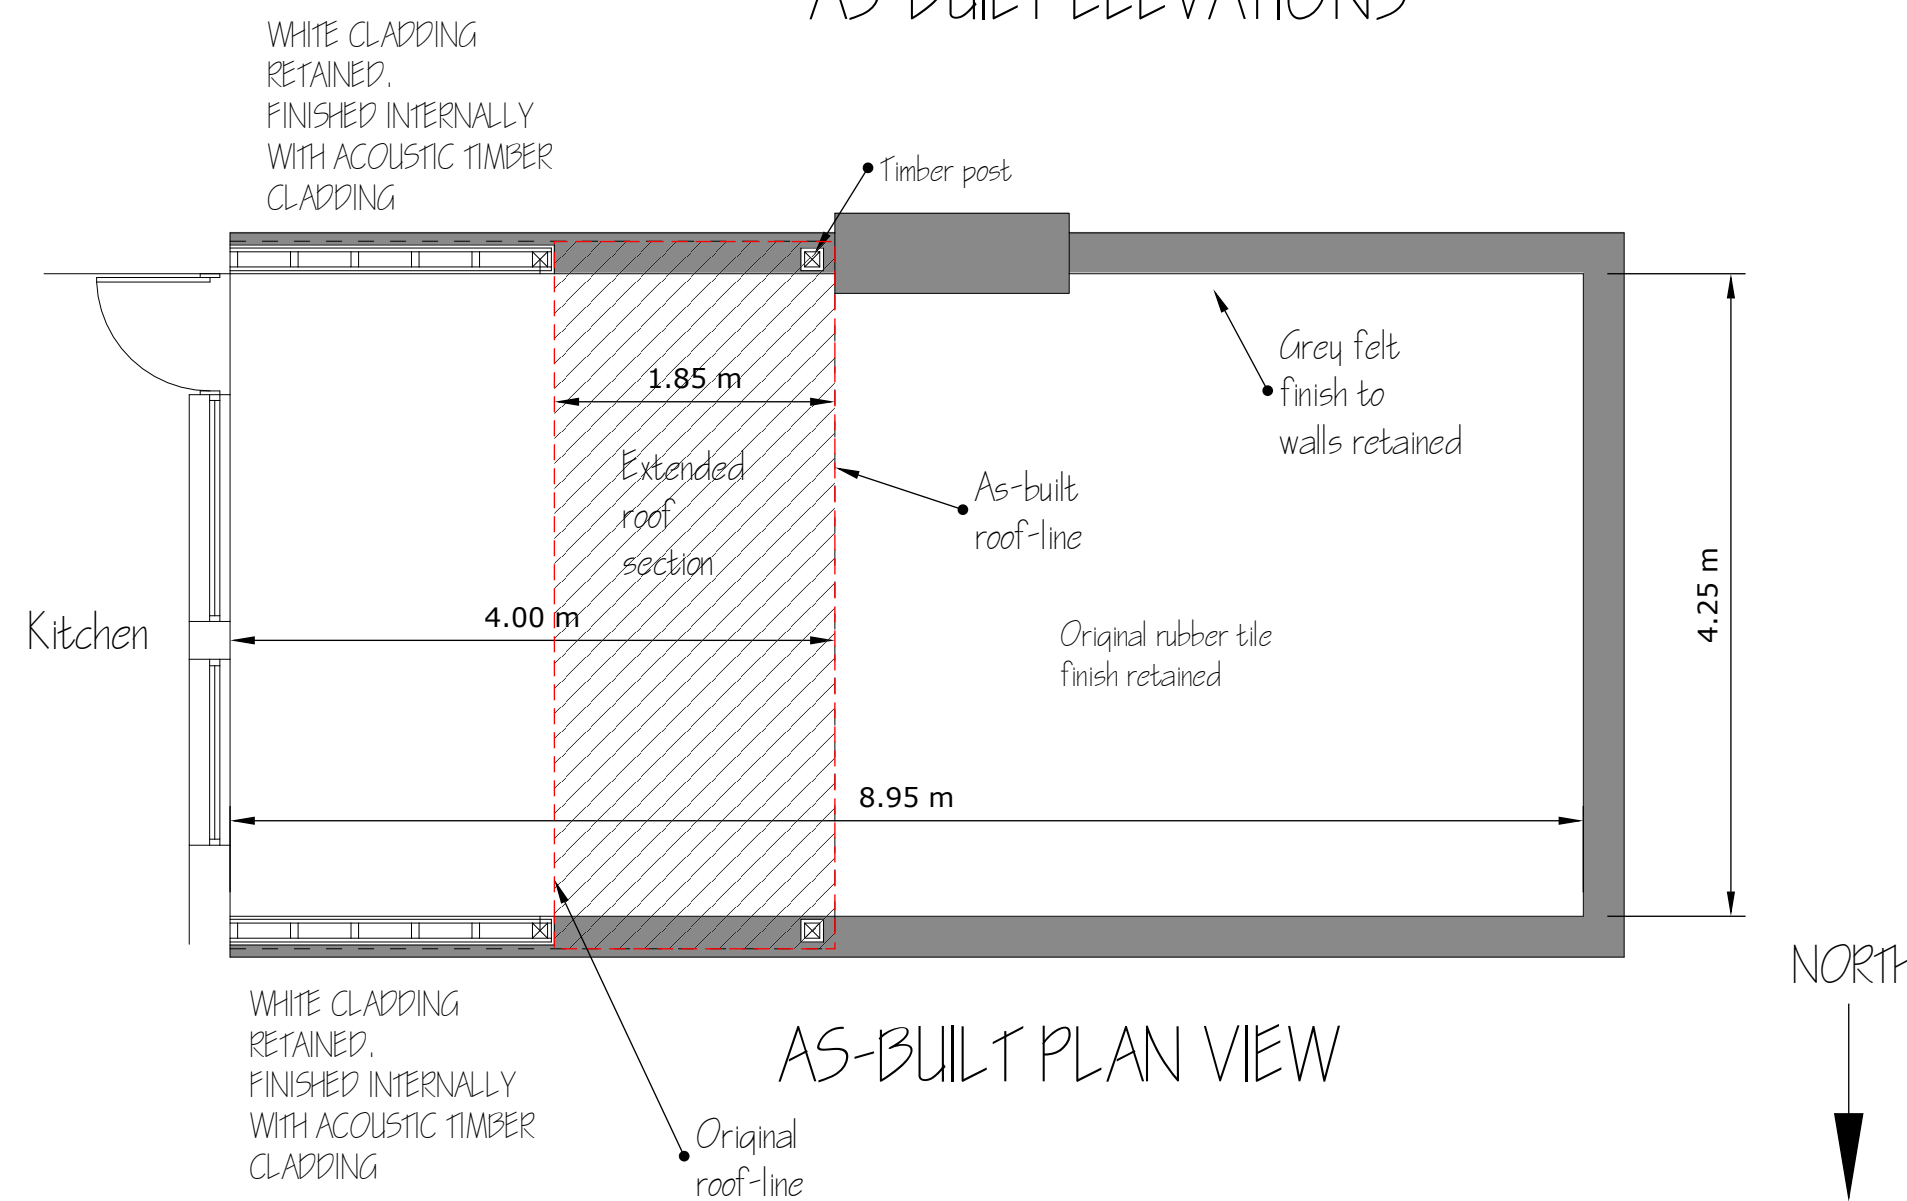

AS-BUILT PLAN VIEW

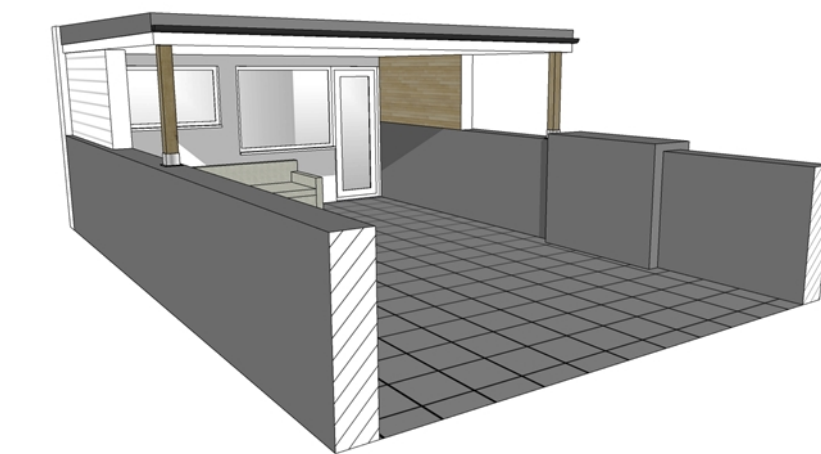

3D VISUALS - AS-BUILT

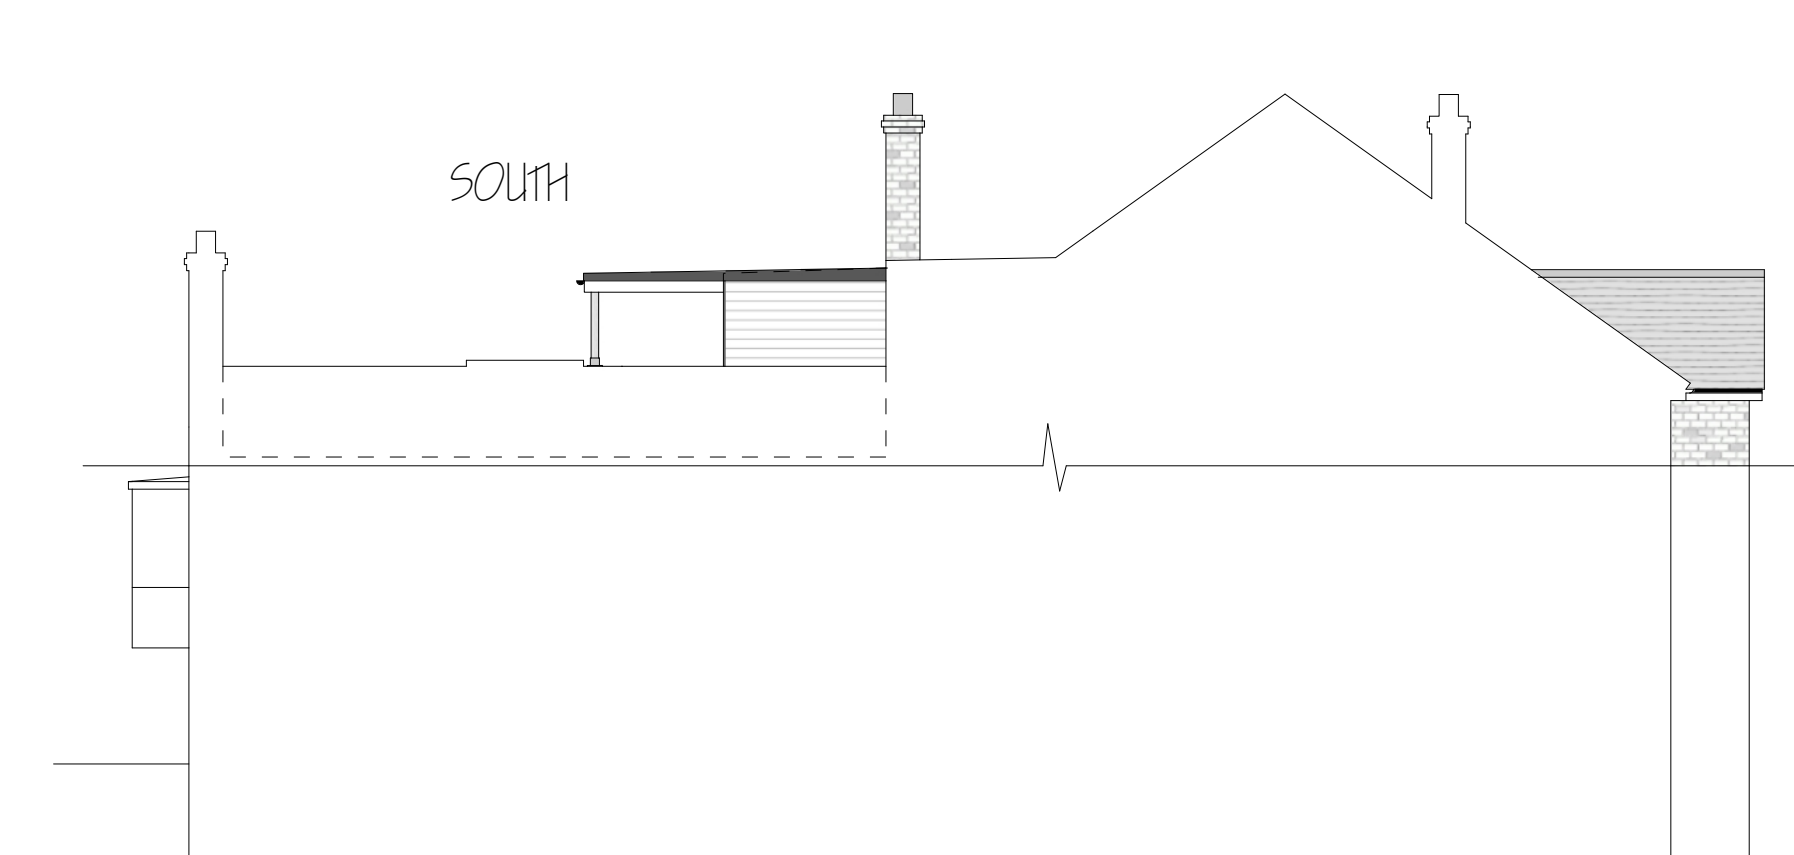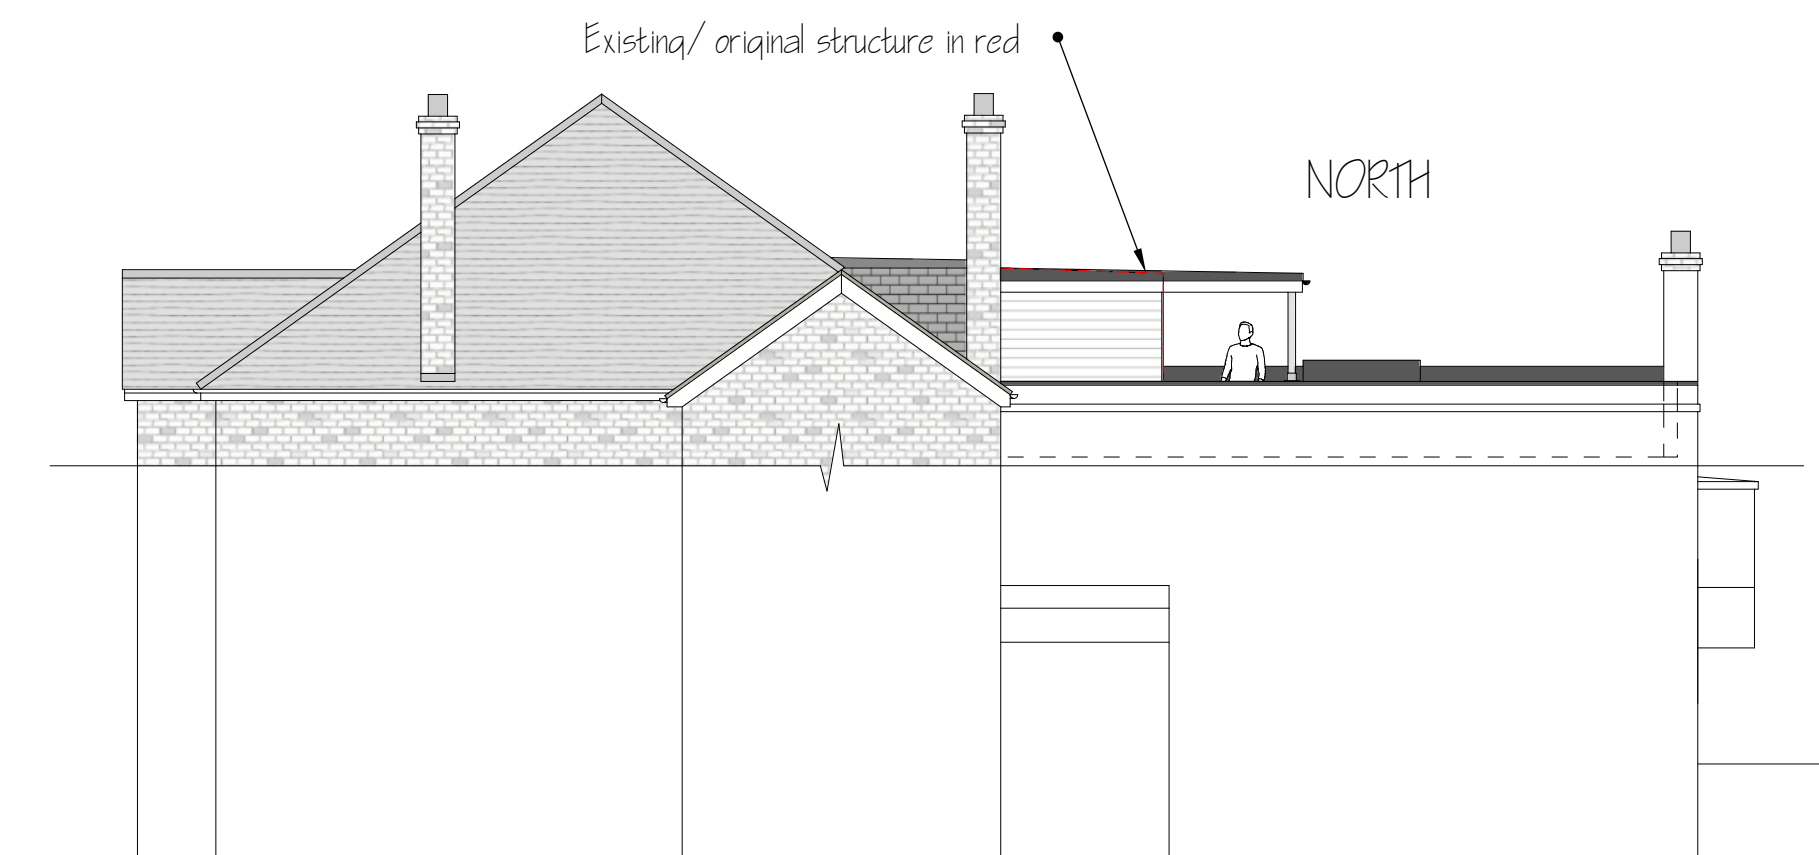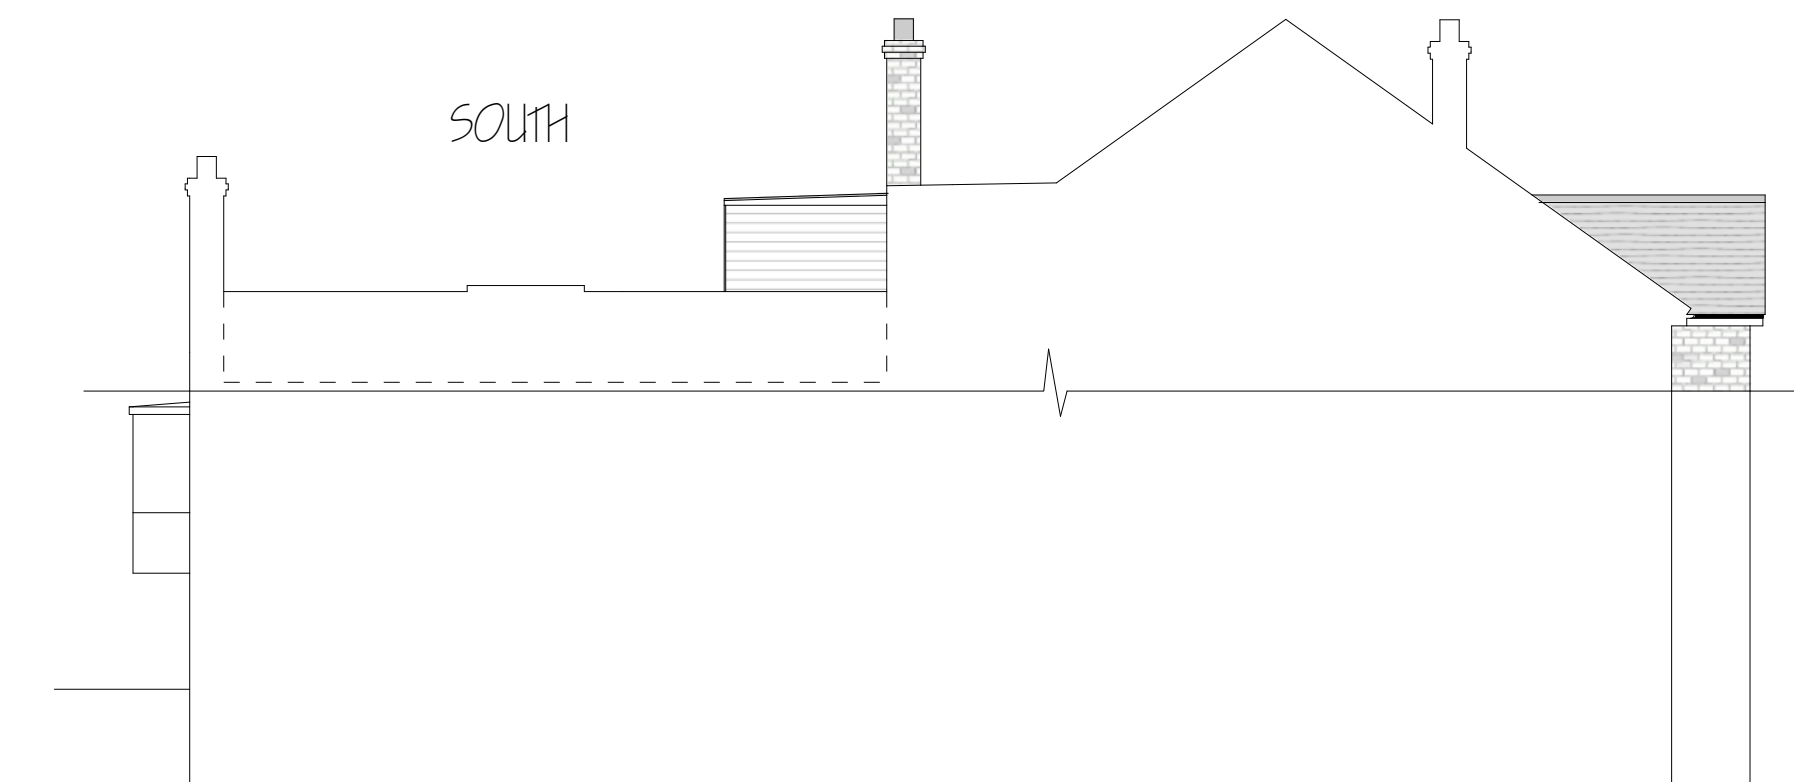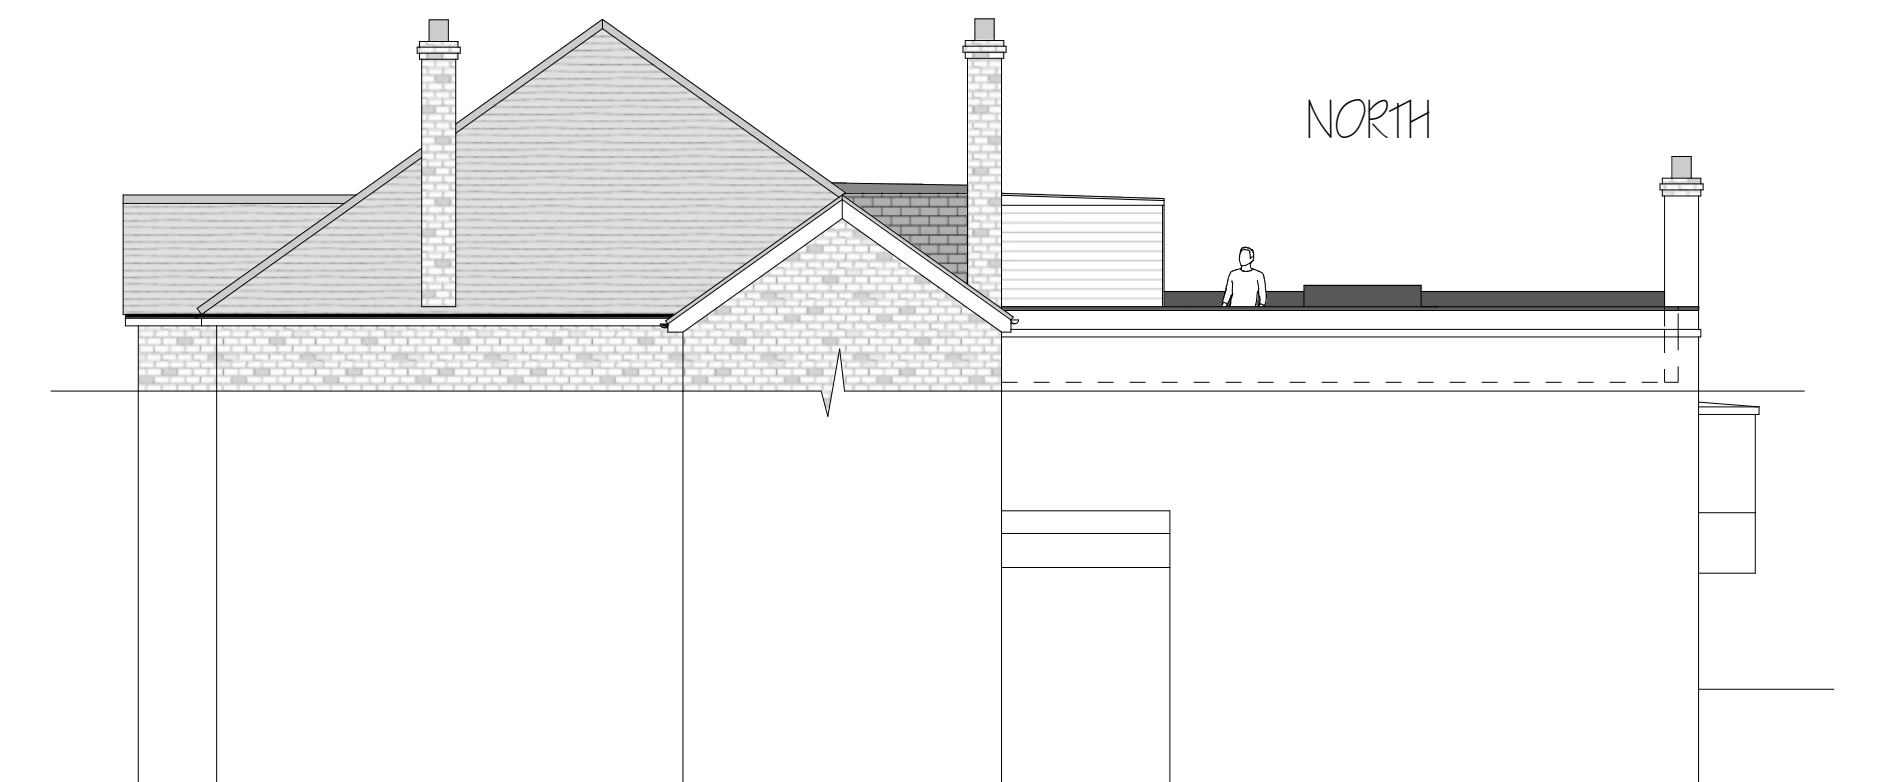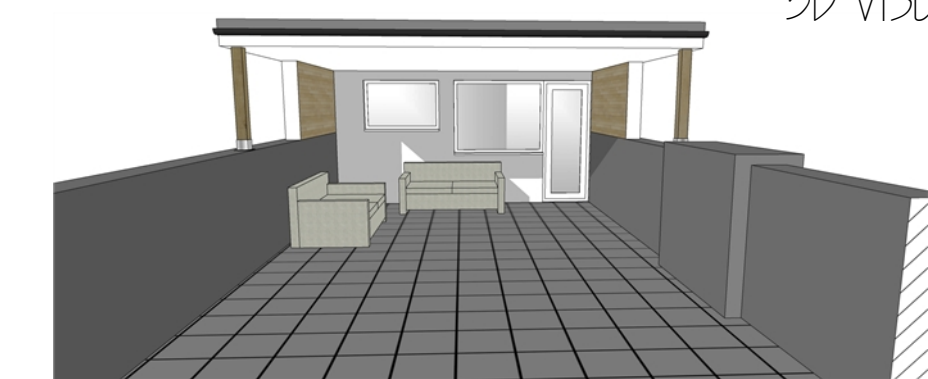

NOTES:
Application is for retrospective consent for the extension of the original roof structure as per drawings on this sheet.

Works included the upgrading and structural improvement of the roof and internal lining of the existing side panels.

Original structure has been in place and used since approx 2014



EXTENSION TO ROOF OF EXISTING ROOF TERRACE STRUCTURE: FLAT 4, 69 DOWNVIEW ROAD, WORTHING, WEST SUSSEX, BN11 4QY

ORIGINAL AND 'AS-BUILT' PLANS AND ELEVATIONS , 3D VISUALS , PHOTOS

SCALE: AS MARKED , DRWG No: DS/PERRY/OI , DATE: 05/07/2025

1:50 @ A2 paper size 0 1 2 3m
1:100 @ A2 paper size 0 1 2 3 4 5m