



NOTES

DO NOT SCALE OFF THIS DRAWING.
CHECK ALL DIMENSIONS ON SITE BEFORE ANY WORK IS
COMMENCED.
ALL WORKS MUST COMPLY WITH THE LATEST
CURRENT BUILDING REGULATIONS, BRITISH STANDARDS AND CODES
OF PRACTICE.

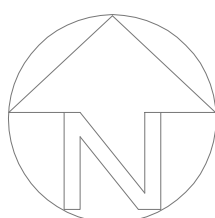

REV	DATE	BY	AMENDMENT
-----	------	----	-----------

A	15.12.2025		PROPOSED RESTAURATION CHANGES SHOWN IN RED
B	08.06.2026		PROPOSED FENESTRATION CHANGES SHOWN IN GREY & BLACK

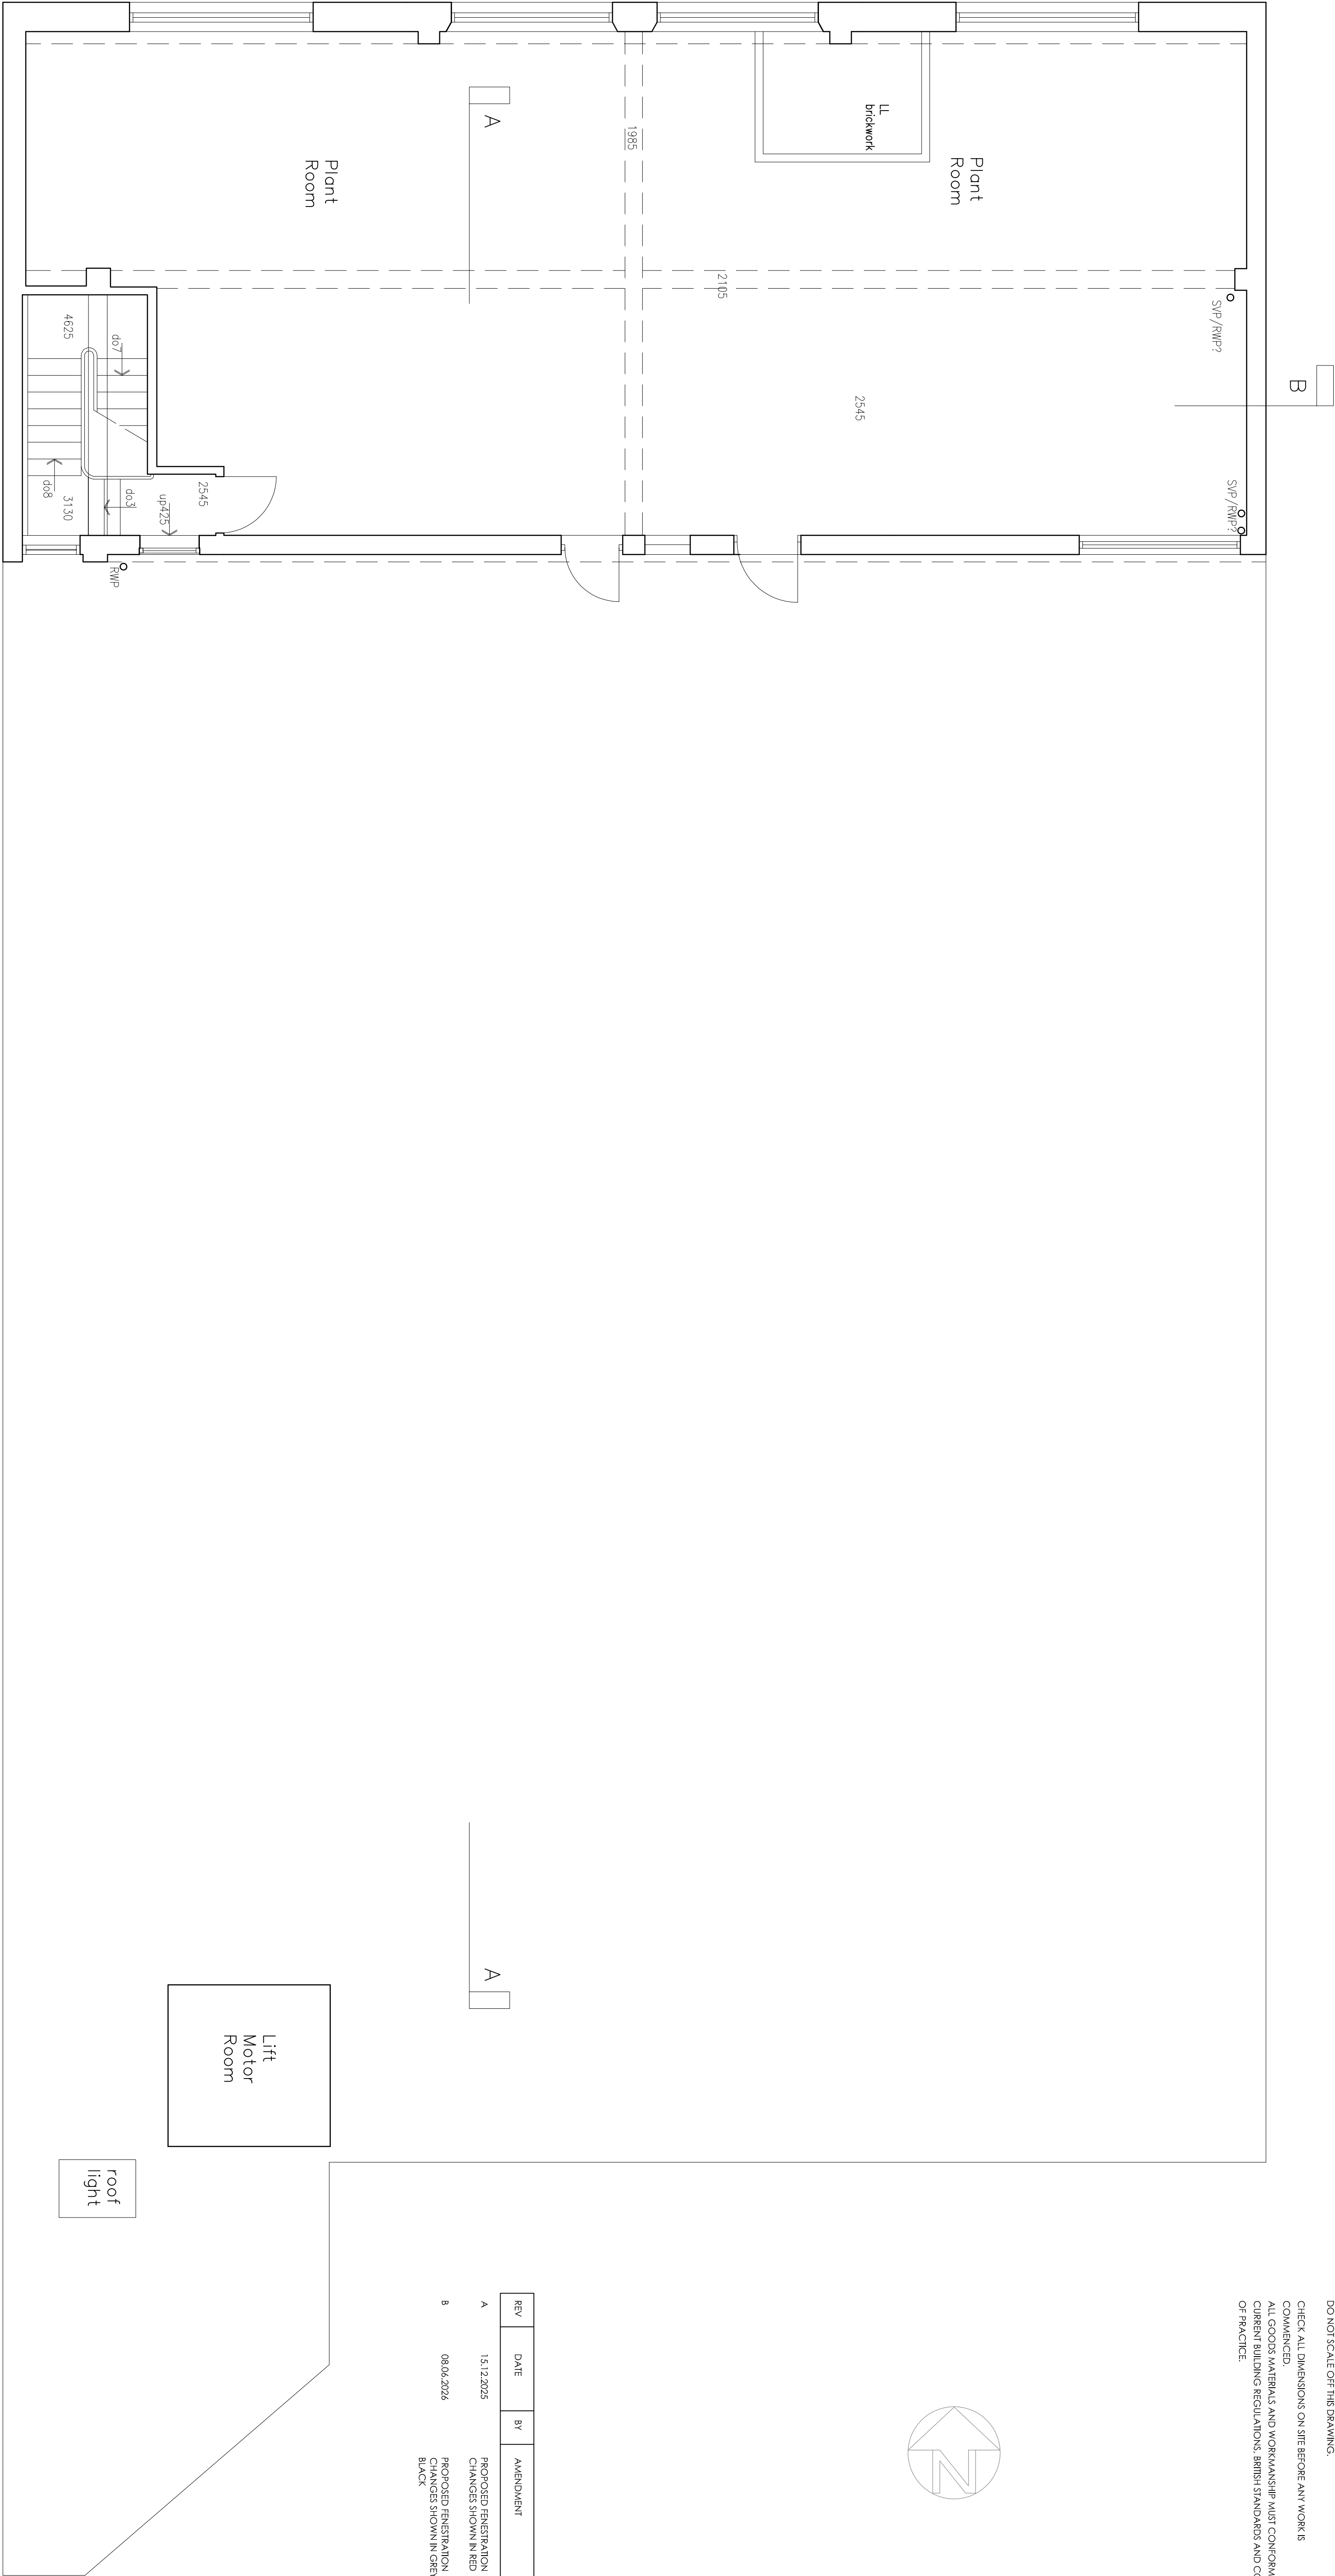

CLIENT *

JOB TITLE
105-109 Montague Street Worthing West Sussex BN11 3BP

DRAWING TITLE
Second/Roof Floor Plan as Proposed

DATE	SCALE	DRAWN BY	CHECKED BY
June 2025	1:50@A1	jos	*

JOB NO.	DRAWING NO.	REVISION
*	02	B

Second Floor/Roof Plan as Proposed