
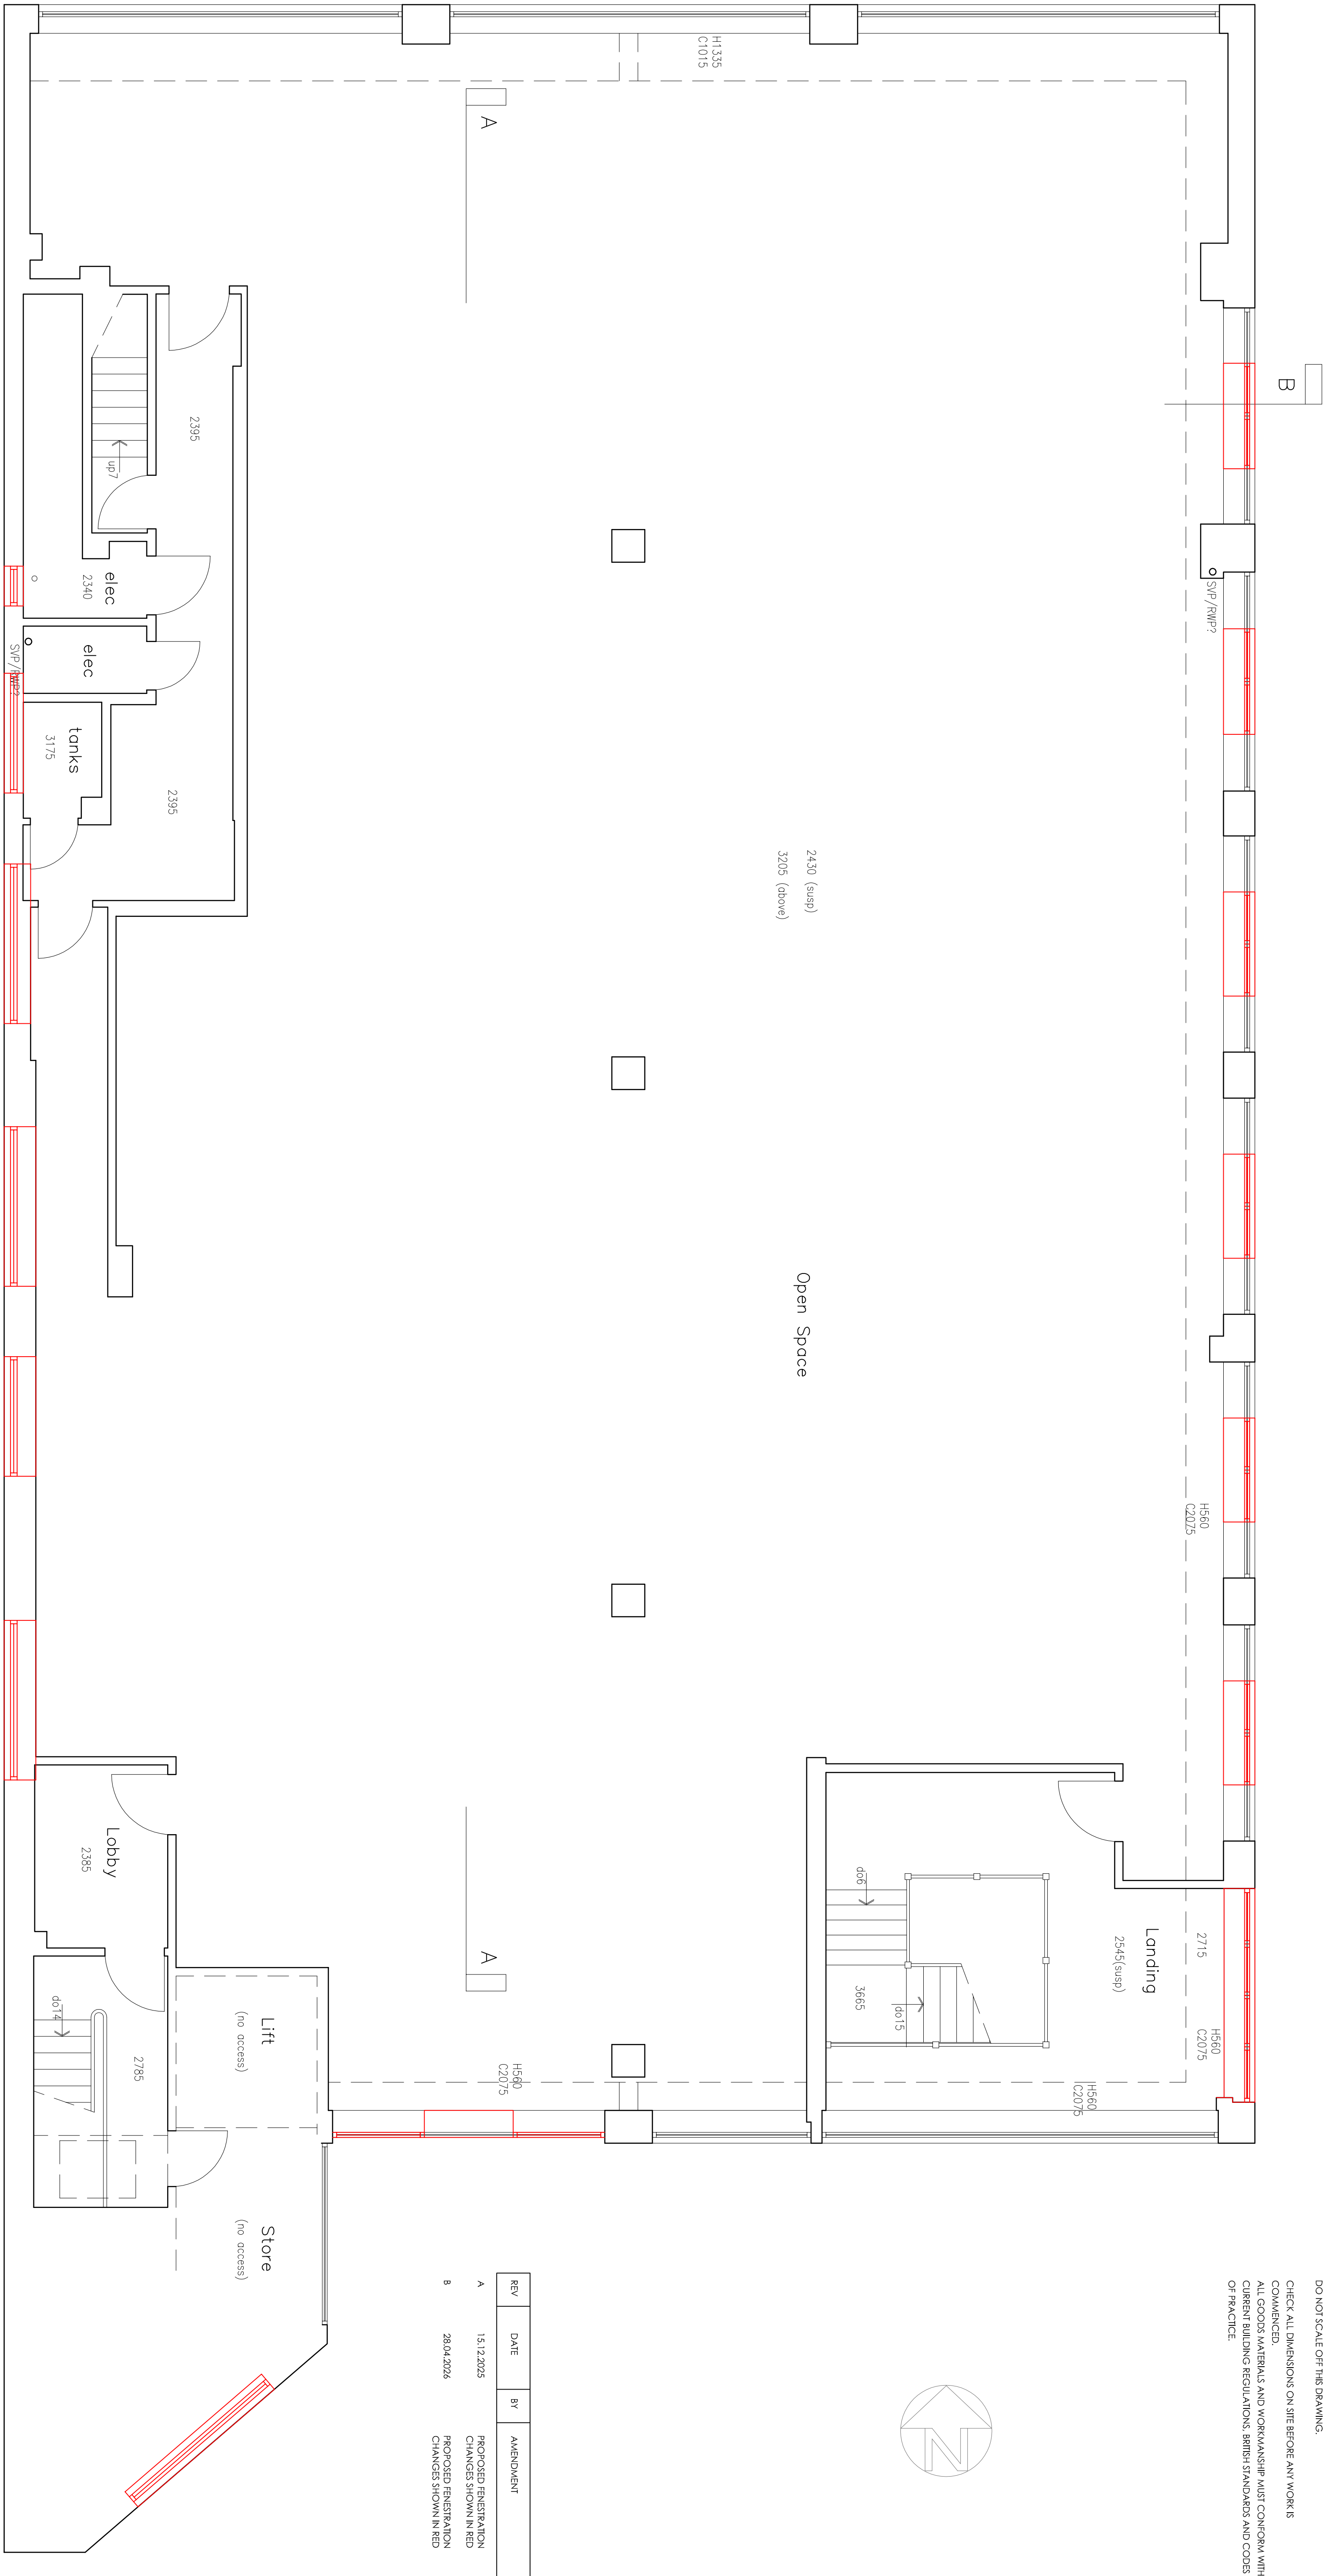


NOTES

DO NOT SCALE OFF THIS DRAWING.
CHECK ALL DIMENSIONS ON SITE BEFORE ANY WORK IS COMMENCED.
ALL GOODS MATERIALS AND WORKMANSHIP MUST CONFORM WITH CURRENT BUILDING REGULATIONS, BRITISH STANDARDS AND CODES OF PRACTICE.

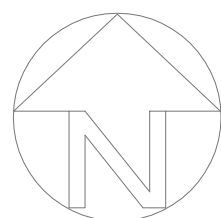

REV	DATE	BY	AMENDMENT
A	15.12.2025		PROPOSED FENESTRATION CHANGES SHOWN IN RED
B	28.04.2026		PROPOSED FENESTRATION CHANGES SHOWN IN RED

CLIENT *

JOB TITLE
105-109 Montague Street Worthing West Sussex BN11 3BP

DRAWING TITLE
First Floor Plan as Proposed

DATE	SCALE	DRAWN BY	CHECKED BY
June 2025	1:50@A1	JOS	*

JOB NO.	DRAWING NO.	REVISION
*	01	B

First Floor Plan as Proposed