
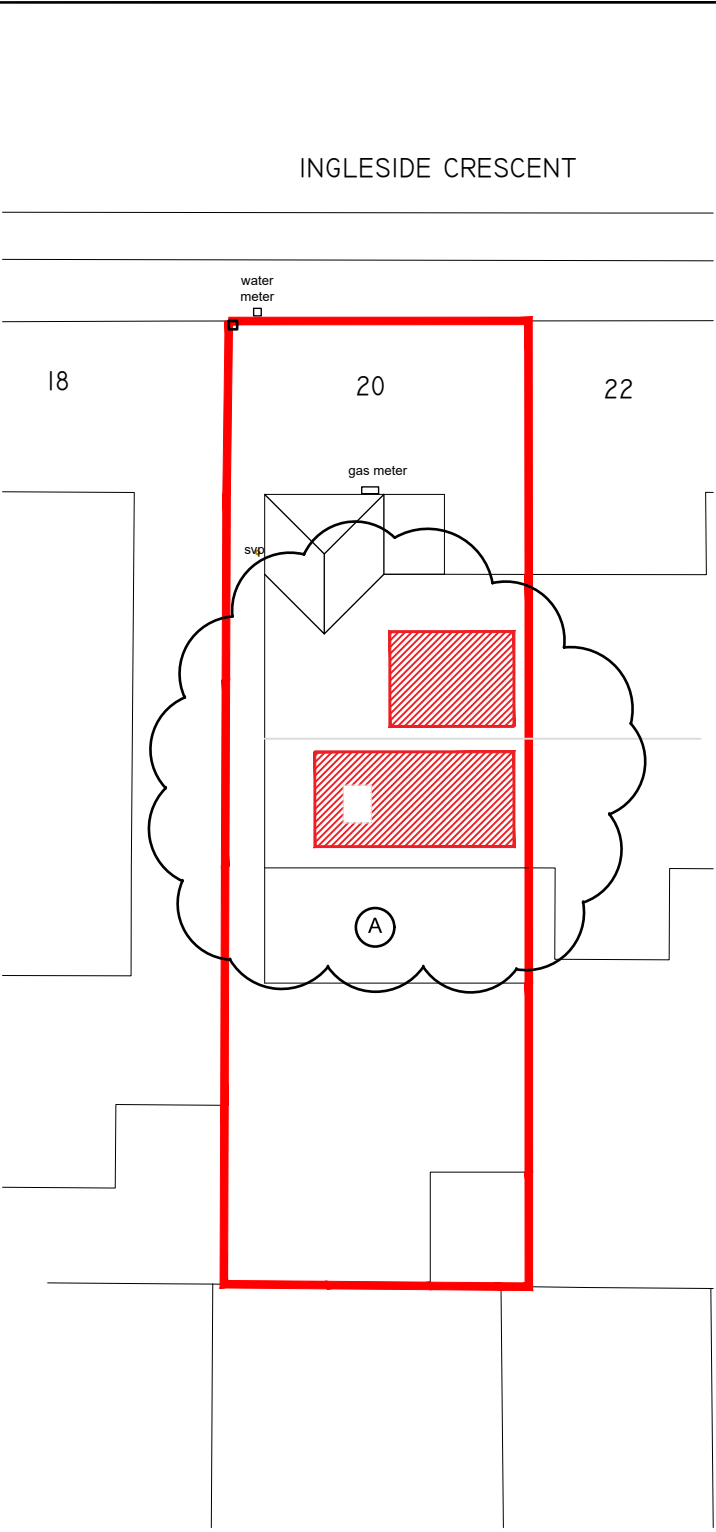


BLOCK PLAN
SCALE 1:200 @ A3

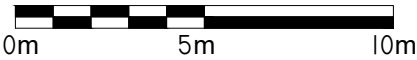

THIS DRAWING IS COPYRIGHT AND MUST NOT BE REISSUED, LOANED OR COPIED WITHOUT THE WRITTEN CONSENT OF PAUL WILLIAMS.

ALL DIMENSIONS MUST BE CHECKED ON SITE BEFORE PROCEEDING AND ANY DISCREPANCIES NOTIFIED IMMEDIATELY.

ALL SETTING OUT ON SITE IS THE RESPONSIBILITY OF THE CONTRACTOR

Notes:

AS BUILT
CONSTRUCTION
TENDER
BUILDING CONTROL
PLANNING
X DESIGN

B	07.02.26	Amended Site Plan front facing Dorma roof size
A	29.11.25	Amended Site Location Plan Scale Bar, Block Plan to highlight the proposed Dorma roofs and corrected tile block

Rev:	Date:	Amendment:
------	-------	------------



PAUL RICHARD WILLIAMS
DESIGN AND BUILD
CONSULTANCY

42 Mill Green Road
Haywards Heath
West Sussex
RH16 1XQ

0773 245 1708

Client
Ryan Trigwell

Project Address:
20
Ingleside
Lancing
WEST SUSSEX
BN15 8EN

Project Title:
HSE TRIGWELL
Loft Conversion

Drawing Title:
SITE LOCATIONPLAN AND
BLOCK PLAN

Drawing Ref:
PL 001

Scale	: AS SHOWN @ A3
Date	: Nov 2025
Rev	: B
Drawn By	: PRW