




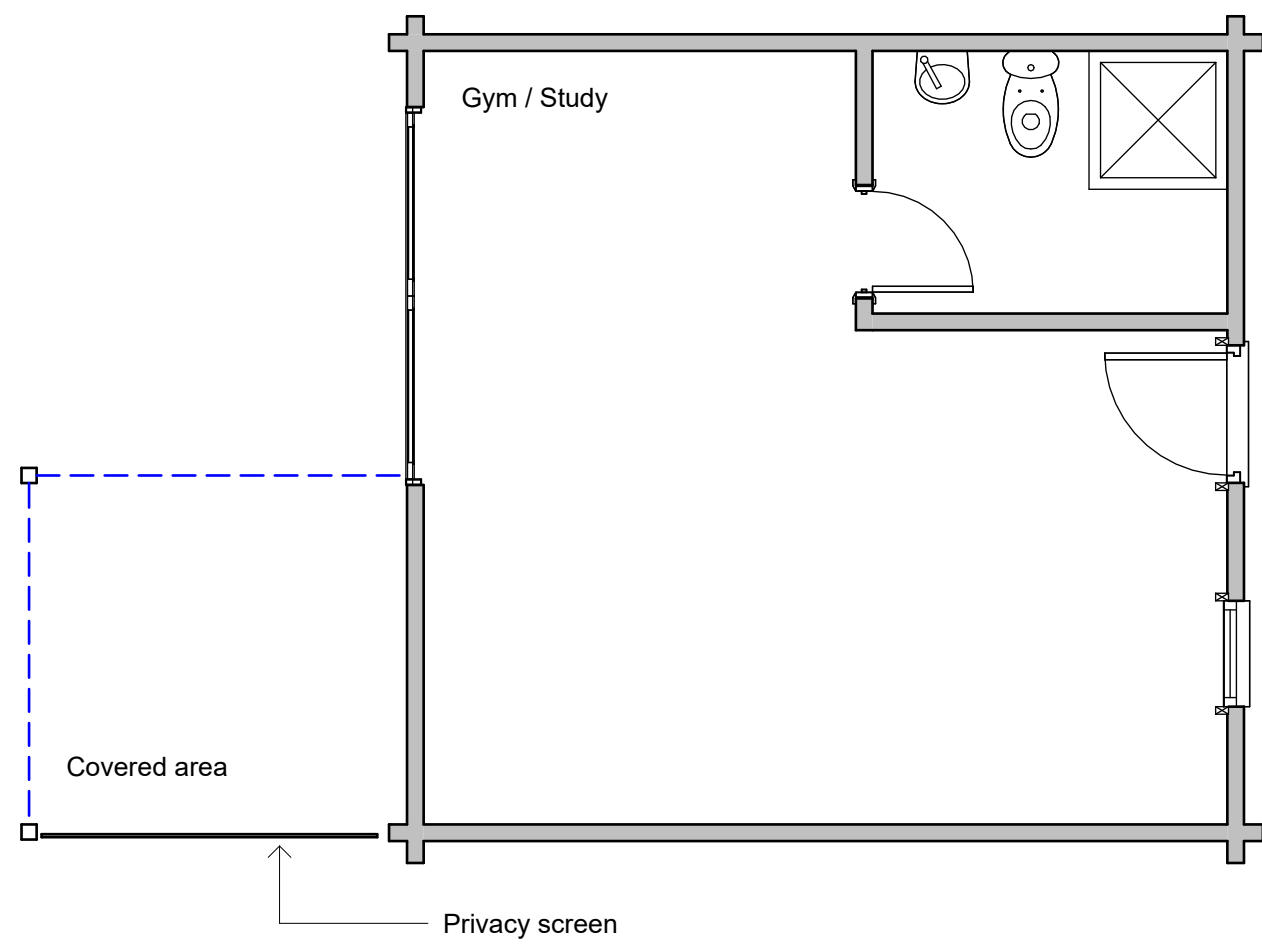


Ground floor 1:50

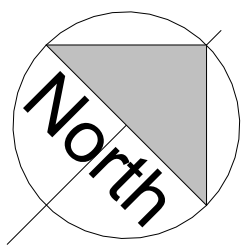

Roof plan 1:50

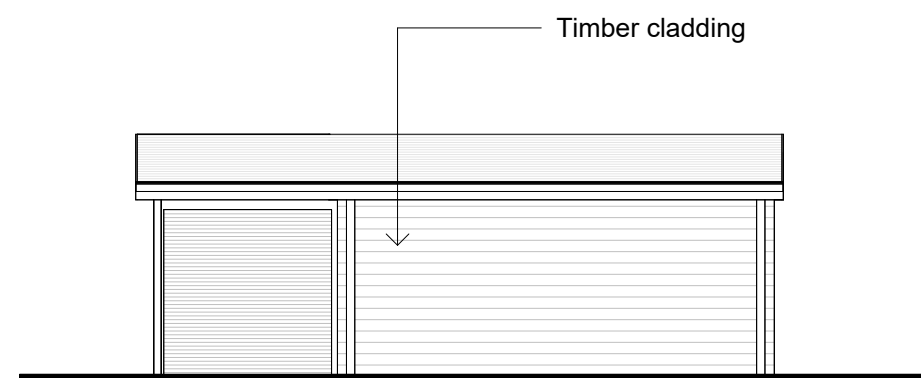


Side Elevation 1:100
South

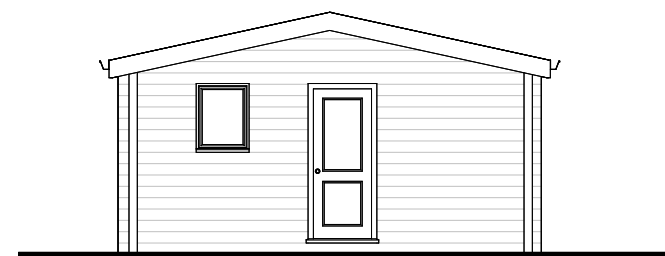


Front Elevation
East



Side Elevation
North


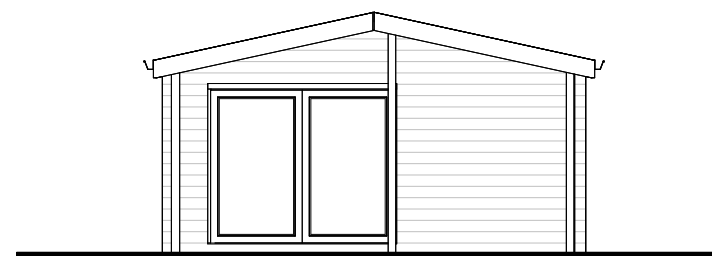


Rear Elevation
West

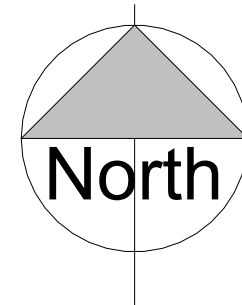


Site Plan 1:500

Site Plan 1:1250

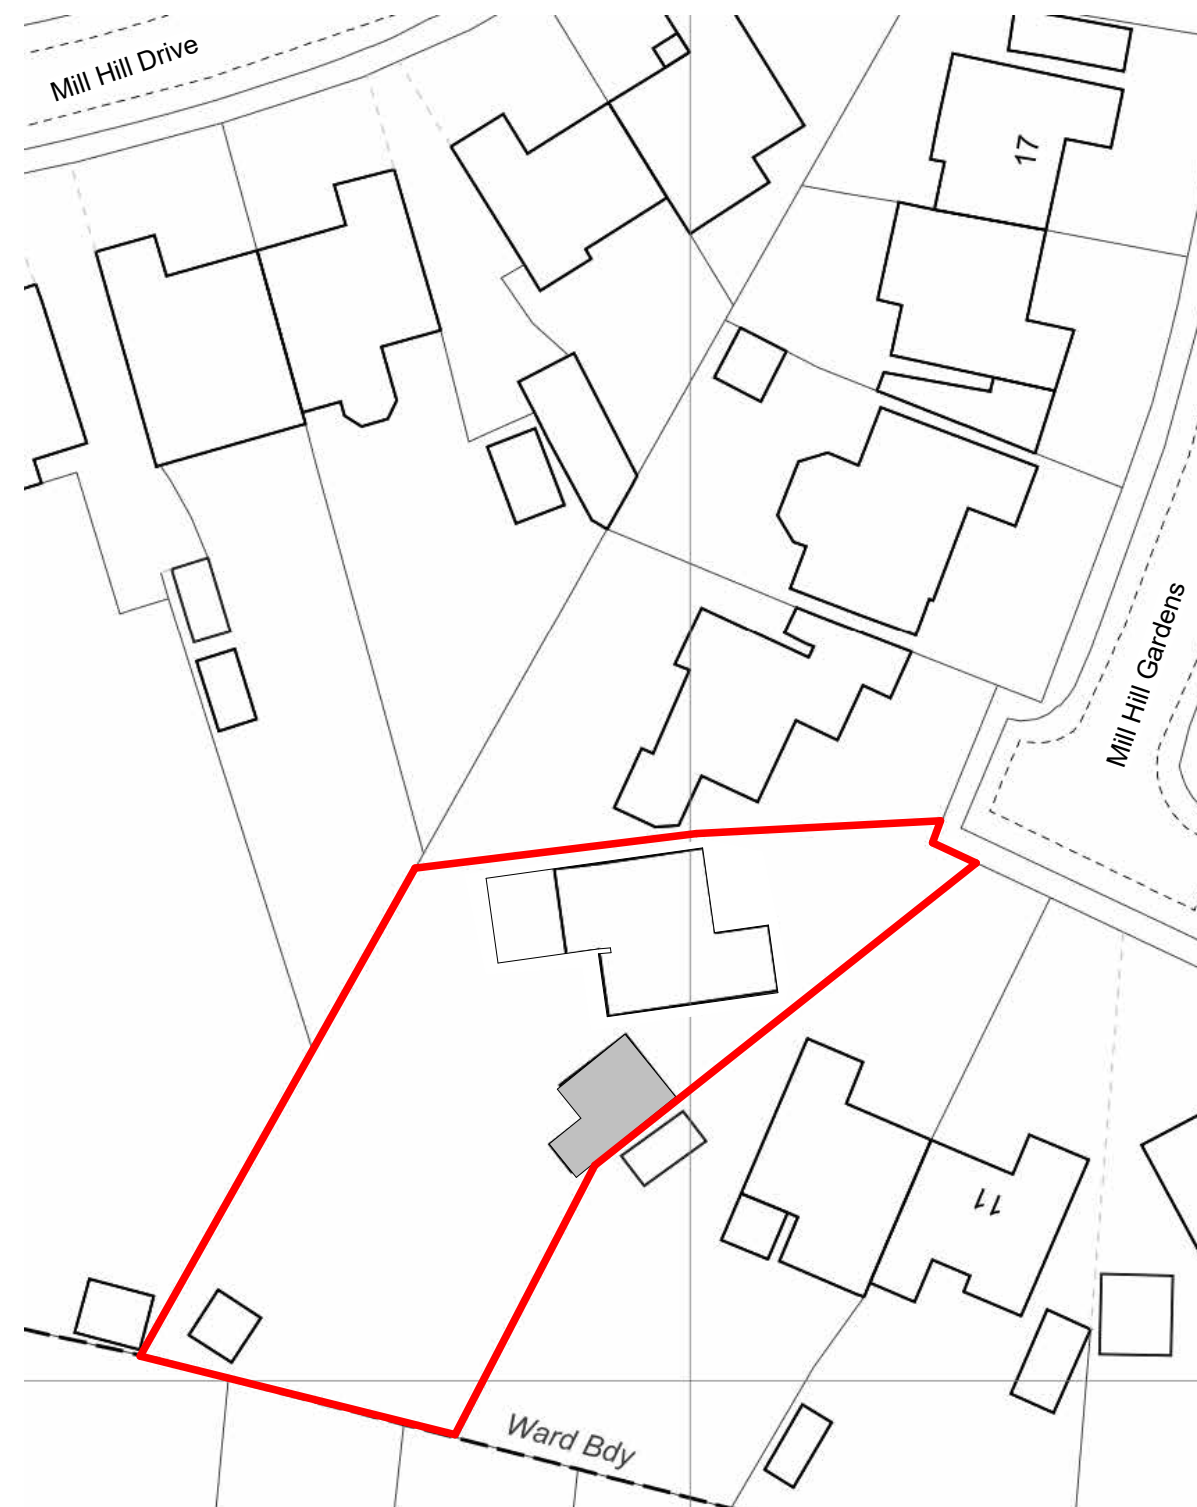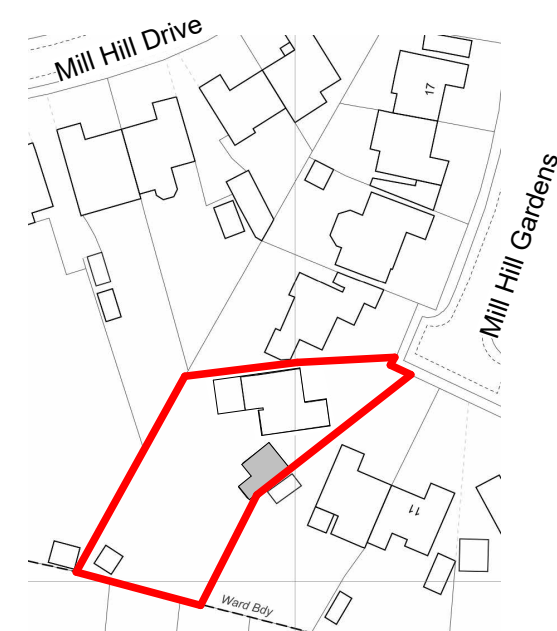

Revisions

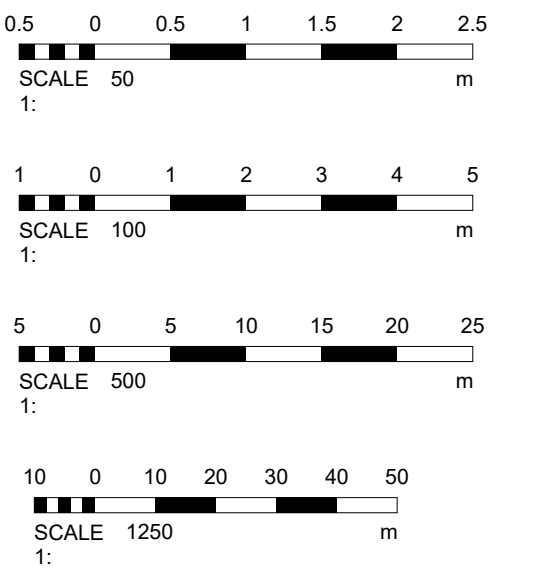

Materials

Drawing Number 2026/15 Sheet 1 of 1

Size A1 Scale 1:50, 1:100, 1:500, 1:1250

Project
As built
January 2026

Job Title
13 Mill Hill Gardens
Shoreham By Sea
West Sussex
BN43 5TN

Do Not scale from this drawing except for planning as photocopies will be subject to distortion
Drawings to be read in conjunction with all other Designers and structural engineers contract drawings and specifications:
Any discrepancies must be brought to the attention of the Designer immediately.
The contractor must verify all dimensions by site measurement before ordering materials or manufacturing components
Substitute materials and products to those named will be acceptable if proven to be of equal or higher performance and not in conflict with other elements

M.J.Humphrey
Ltd



Mel Humphrey MRICS 9 Aldsworth Avenue Goring By Sea West Sussex BN12 4XQ
Adam Humphrey MCIOB 21 Pendine Avenue Worthing West Sussex BN11 2NA

Mel@mjhumphrey.co.uk 07701055182
Adam@mjhumphrey.co.uk 07812419142