


Notes:

1. THE COPYRIGHT OF THIS DRAWING IS VESTED IN ARCHEVOLVE AND IT MAY NOT BE REPRODUCED IN WHOLE OR PART OR USED FOR THE MANUFACTURE OF ANY ARTICLE WITHOUT THE EXPRESS PERMISSION OF THE COPYRIGHT HOLDERS.
2. WORK TO FIGURED DIMENSIONS ONLY.
3. THIS DRAWING IS TO BE READ IN CONJUNCTION WITH ALL RELEVANT ARCHITECT'S, SERVICE ENGINEER'S AND ARCHEVOLVE AND SPECIFICATIONS.

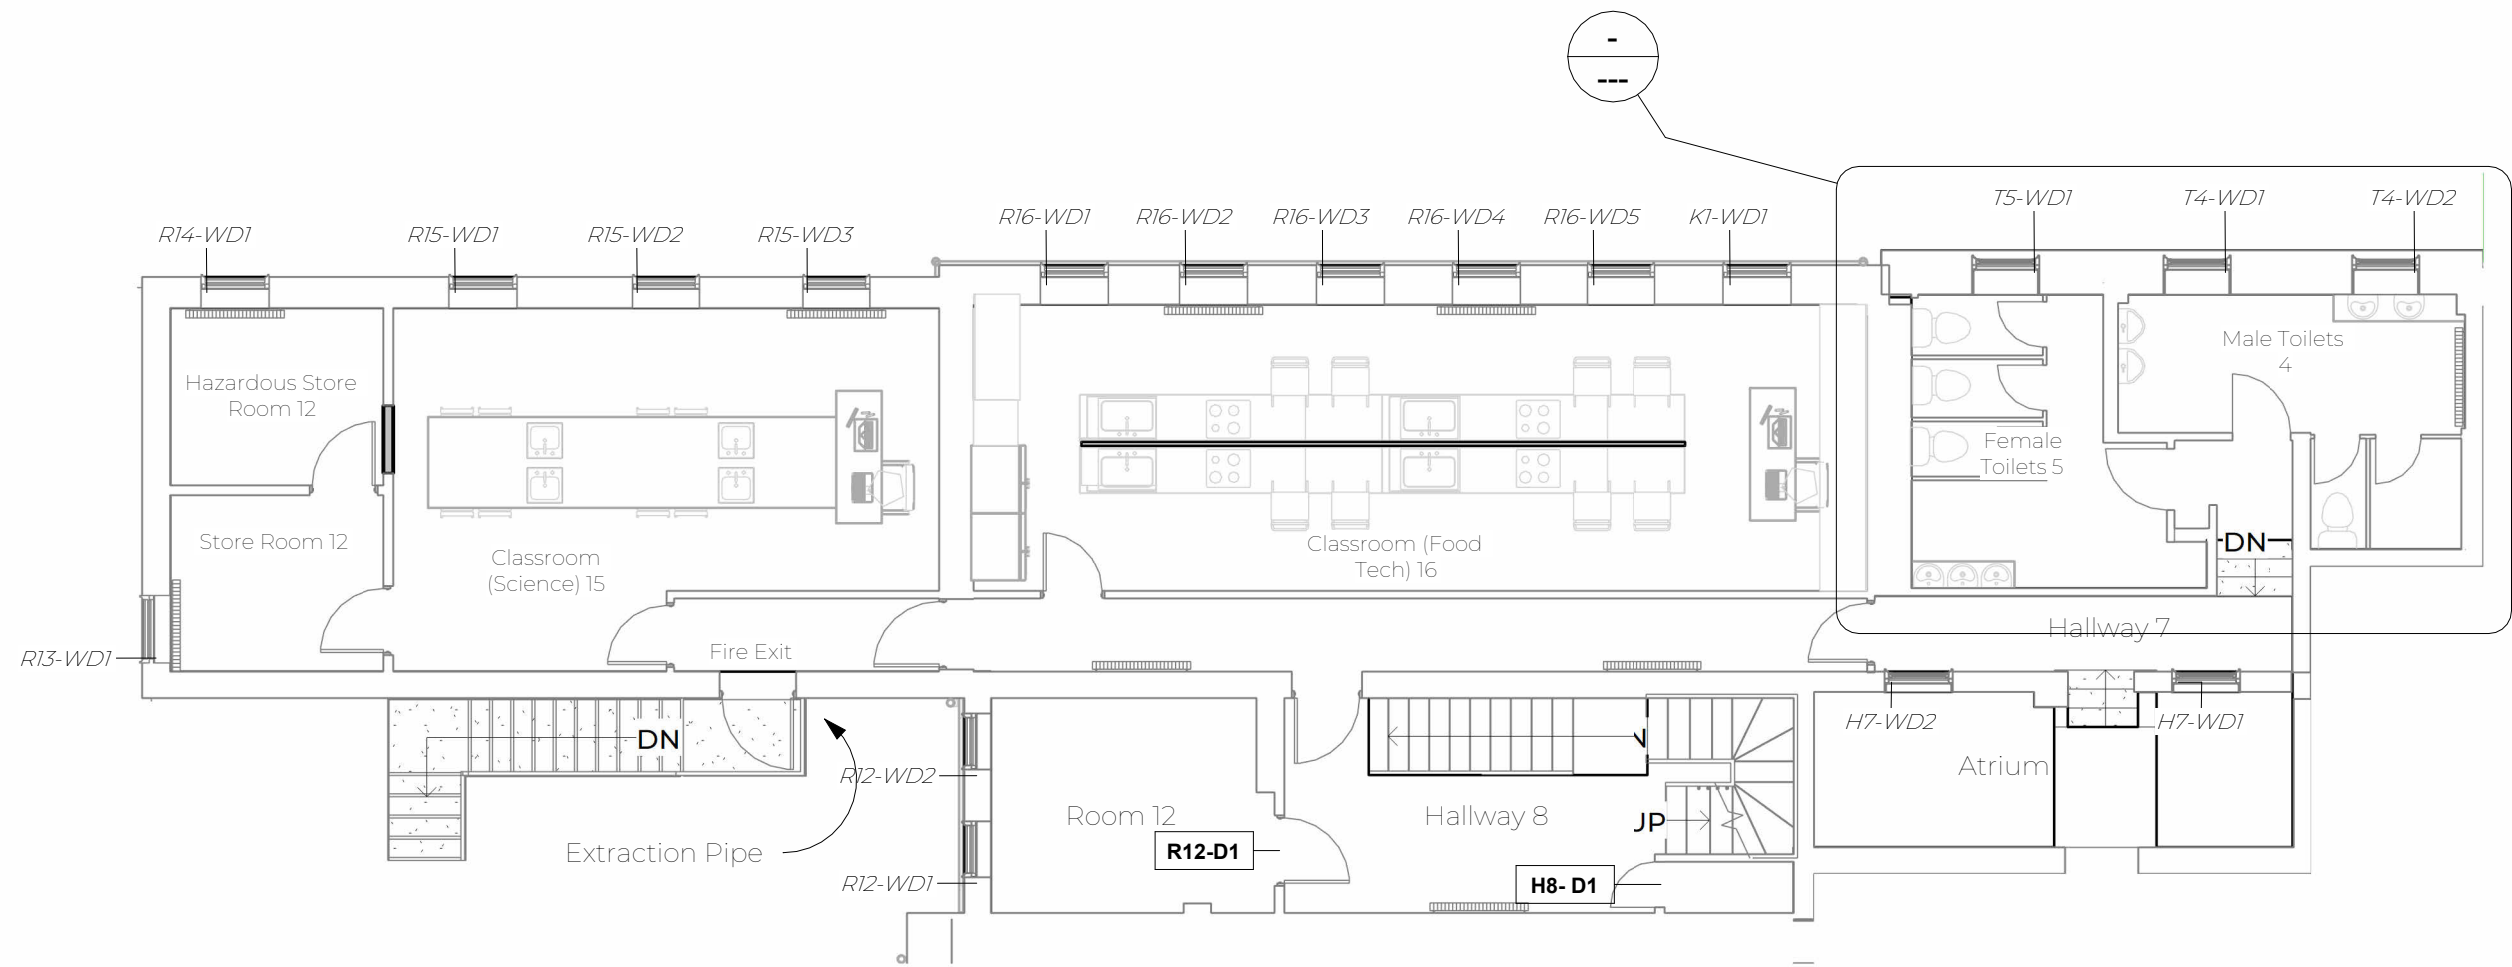


Mezzanine
1 : 100

Rev_A	Updated Plans for Validation	AP	01/07/26
Revision Number	Revision Description	Issued by	Revision Date

DATE:	STATUS:	SHEET SIZE:
02/12/26	PLANNING ISSUE	

SCALE:	DRAWN:	CHECKED:
As indicated	AP	

CLIENT:	SITE ADDRESS:
Courtlands	

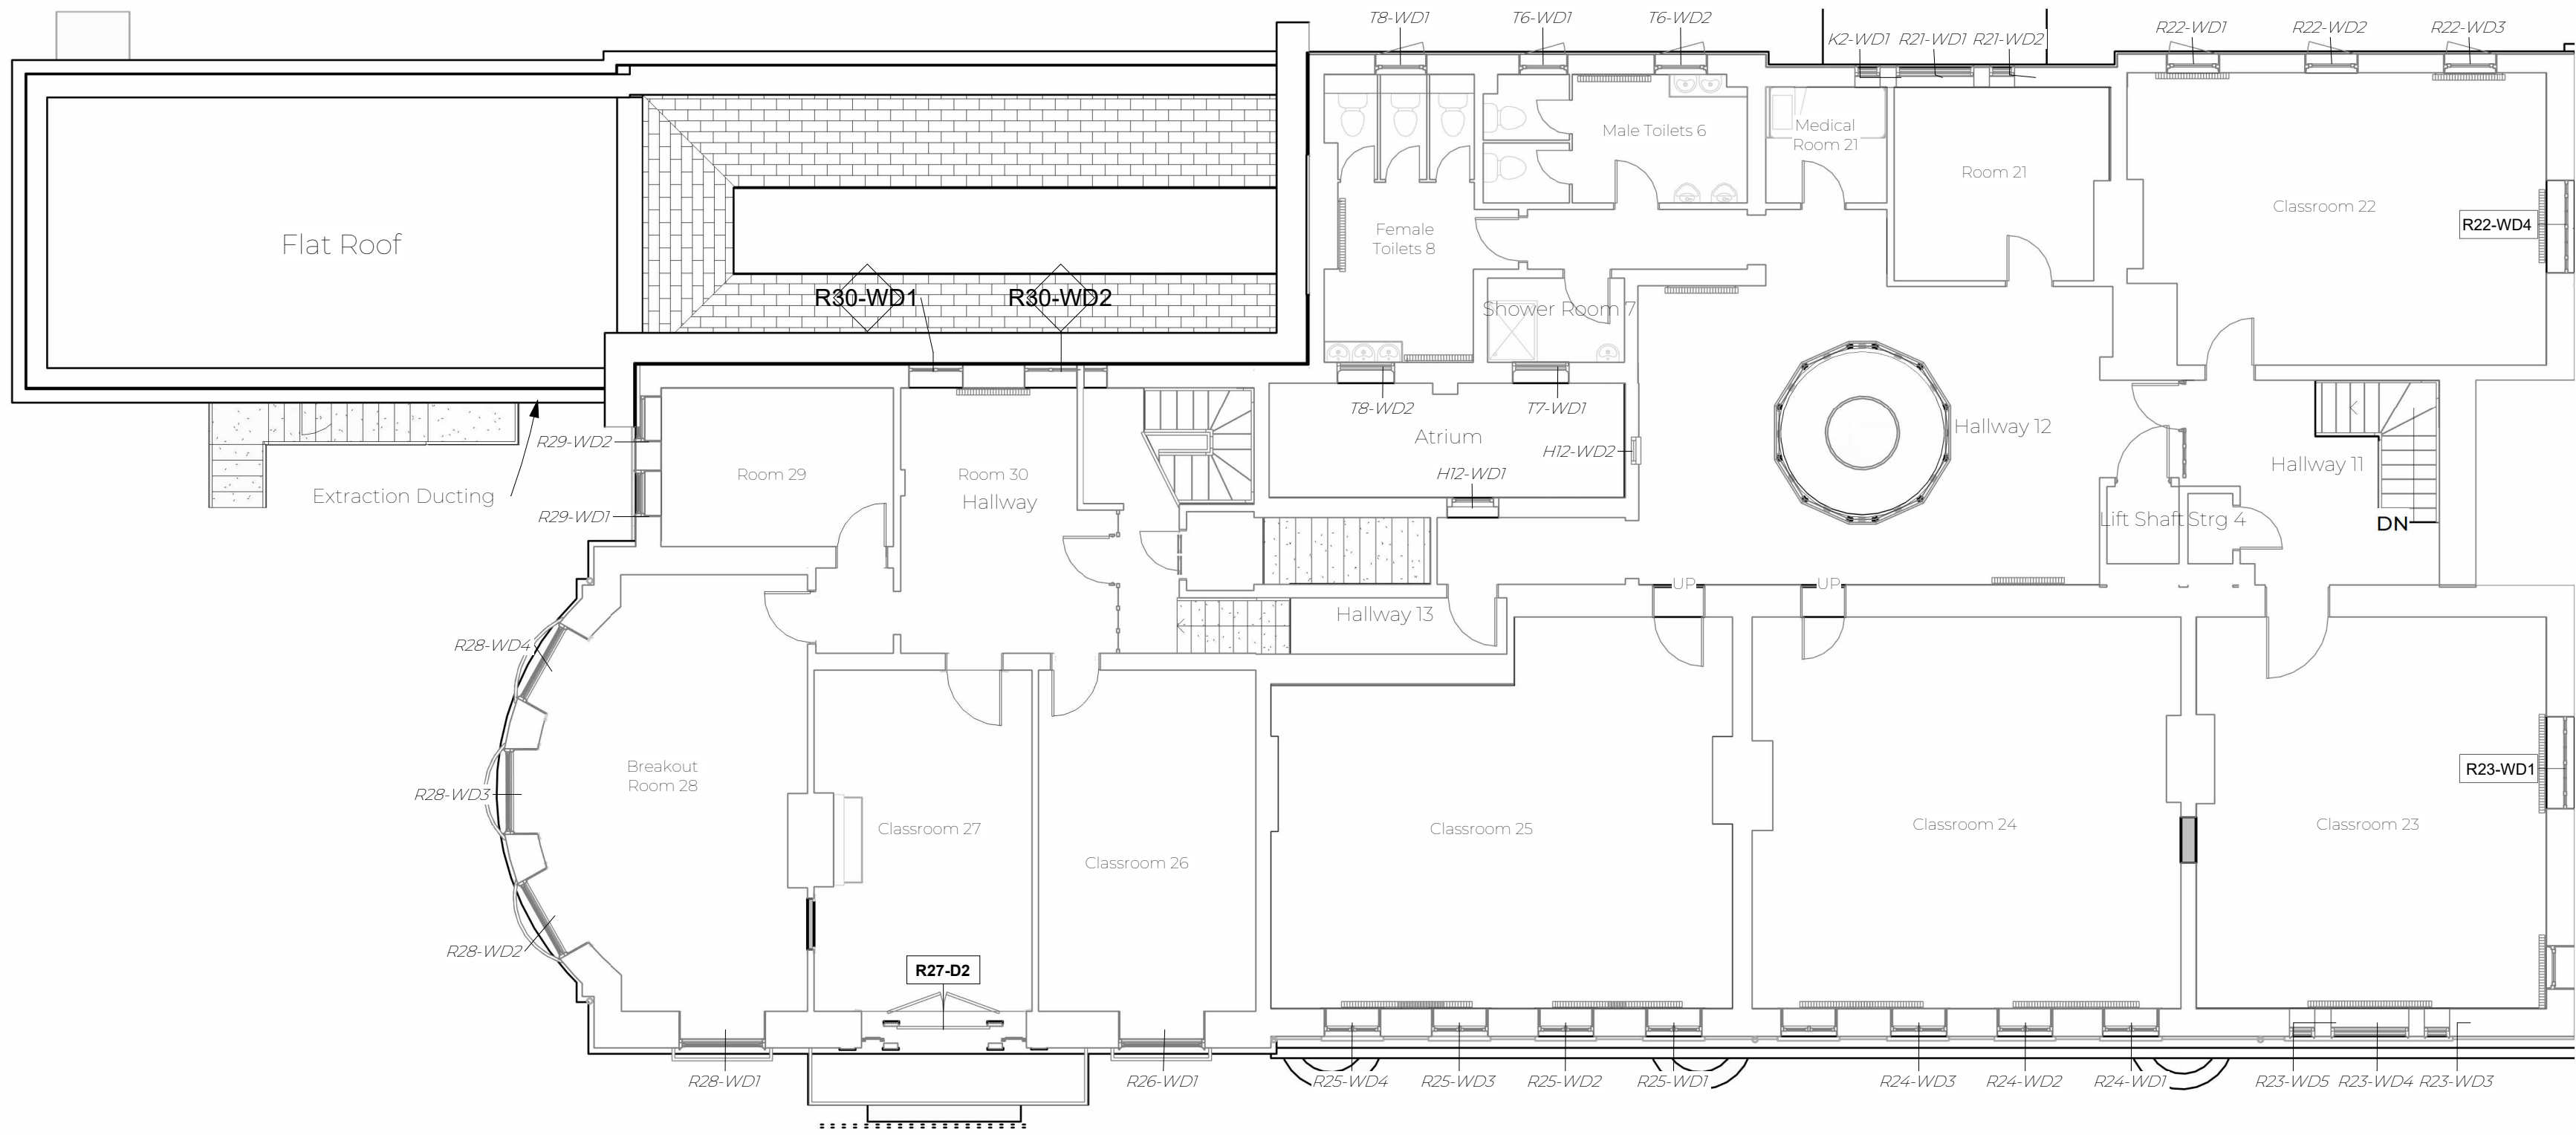

Second Floor
1 : 100

Wall Legend	
	Existing Walls
	Walls to be Removed
	Walls to be Added

DRAWING:

Change of Use

TITLE:

As Built Floor Plans 2
of 2

PROJECT NO:

Courtlands

DRAWING NO:

ARC/012/ 26/21

REVISION:

Rev_A



ARCHEVOLVE

✉ // design @archevolve.co.uk

WEB // www. archevolve.co.uk

☎ // 01798 879894



0m 2m 4m 6m 8m 10m

VISUAL SCALE 1:100 @ A1