


Indicates the structural grillage zone


Indicates outline of Lomax approved elevations




PROPOSED ELEVATION (EAST)
scale 1:200

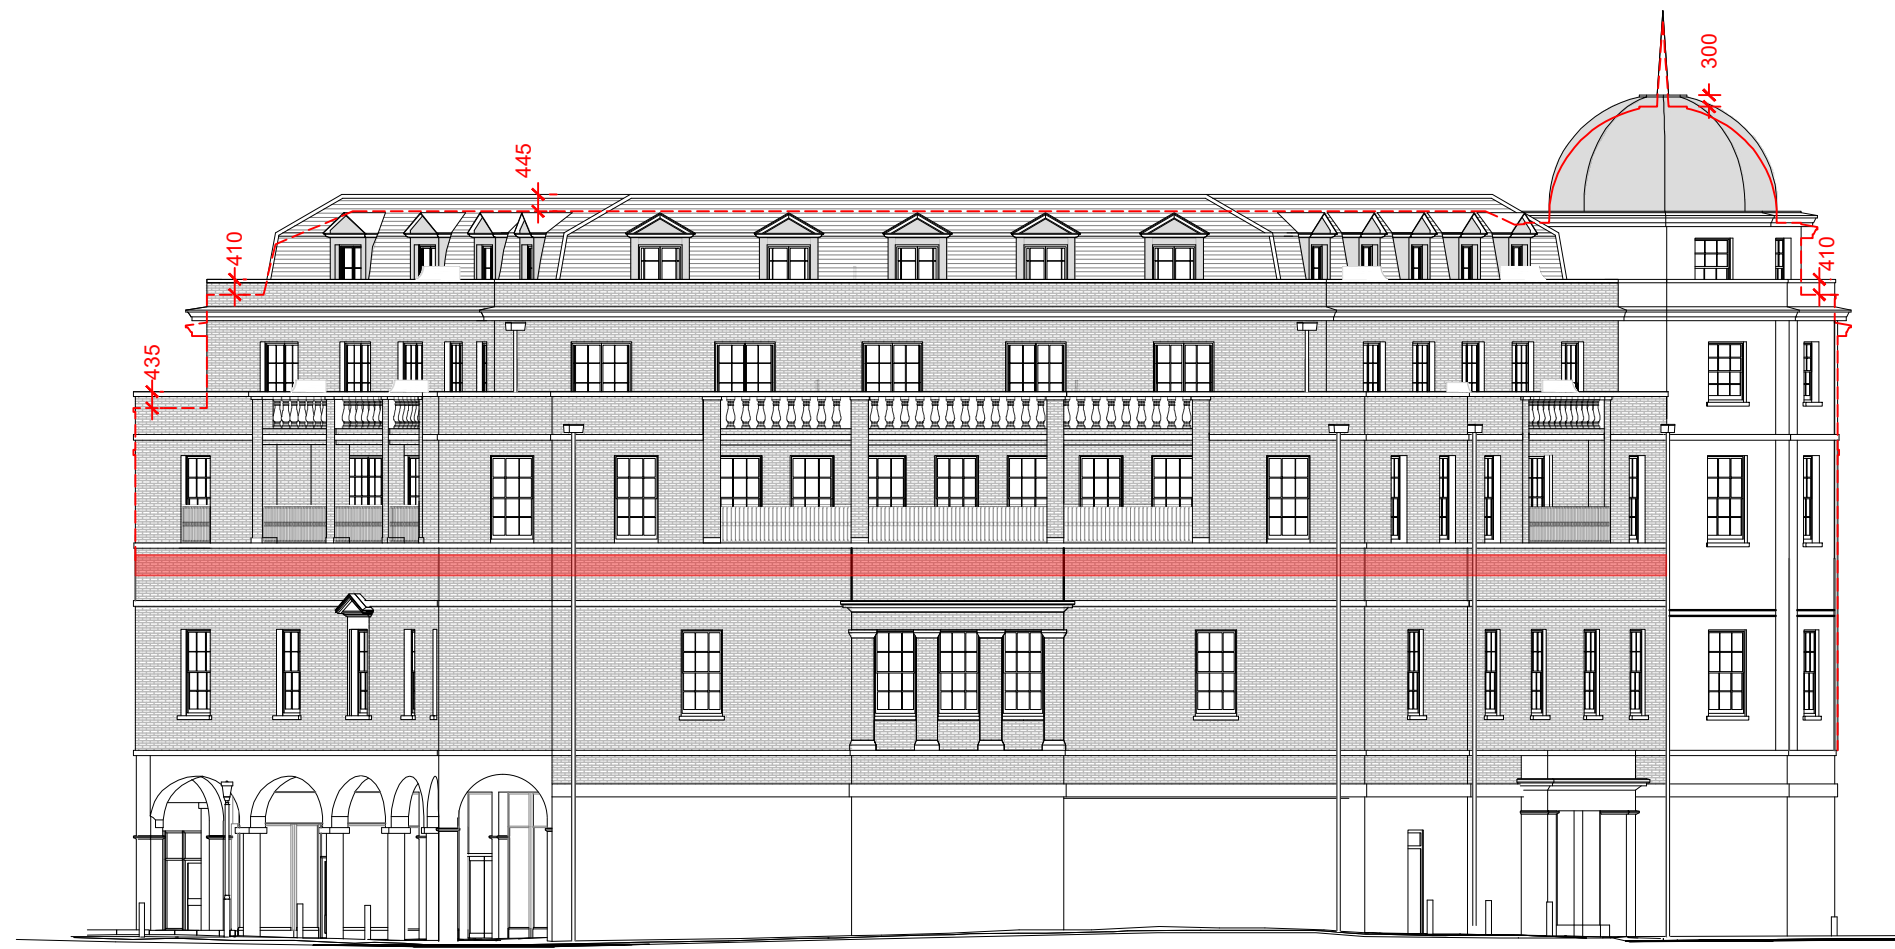

PROPOSED ELEVATION (NORTHEAST)
scale 1:200

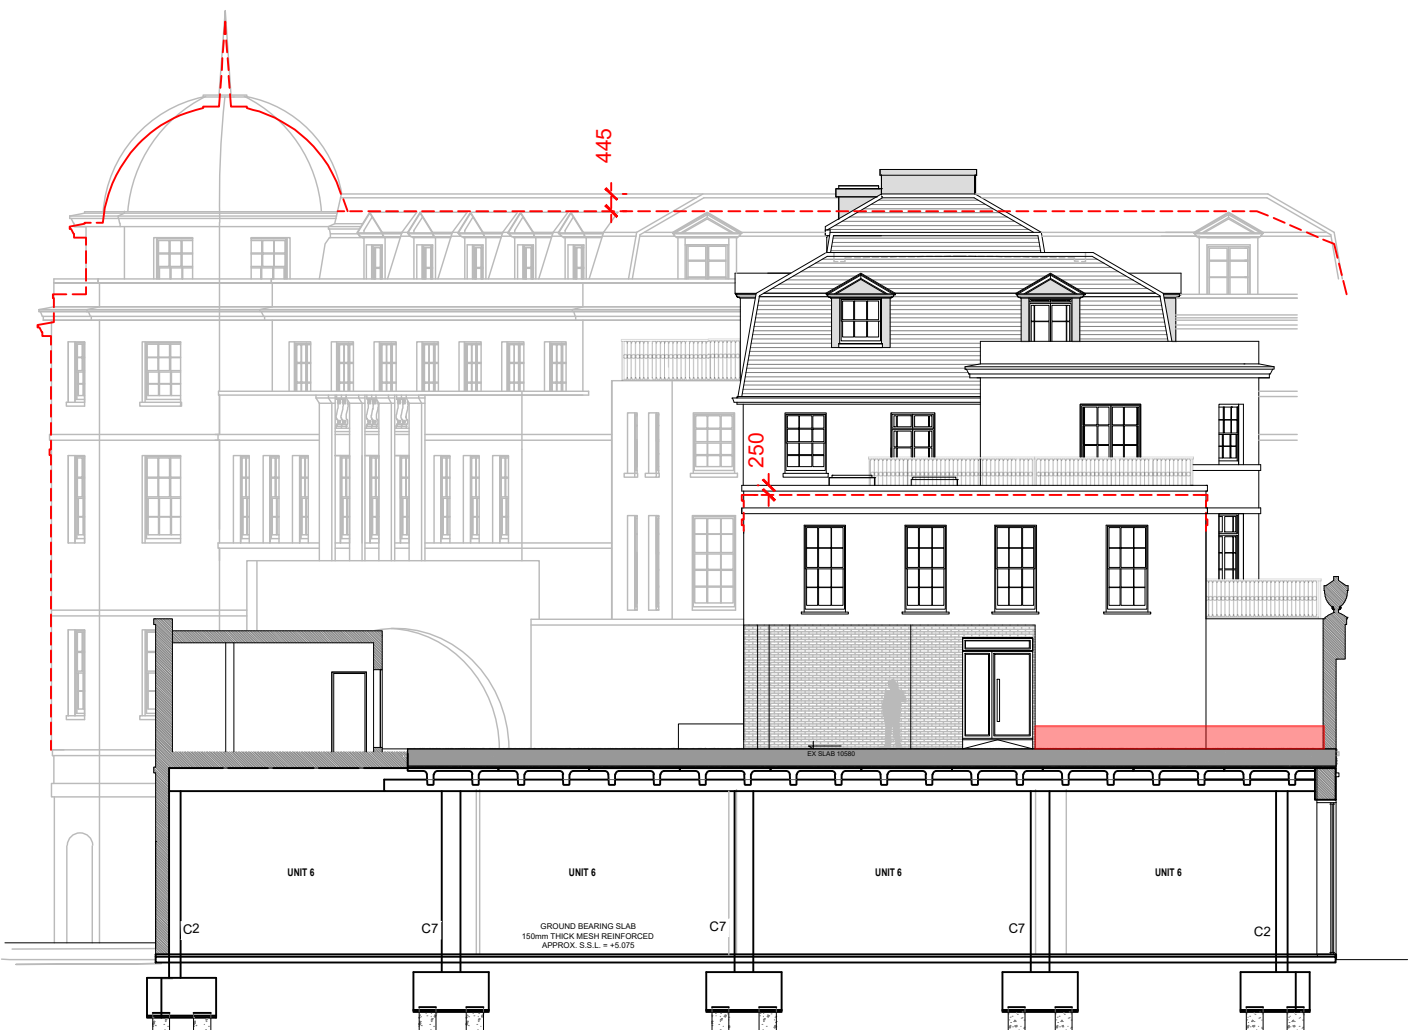

PROPOSED ELEVATION (SOUTH)
scale 1:200

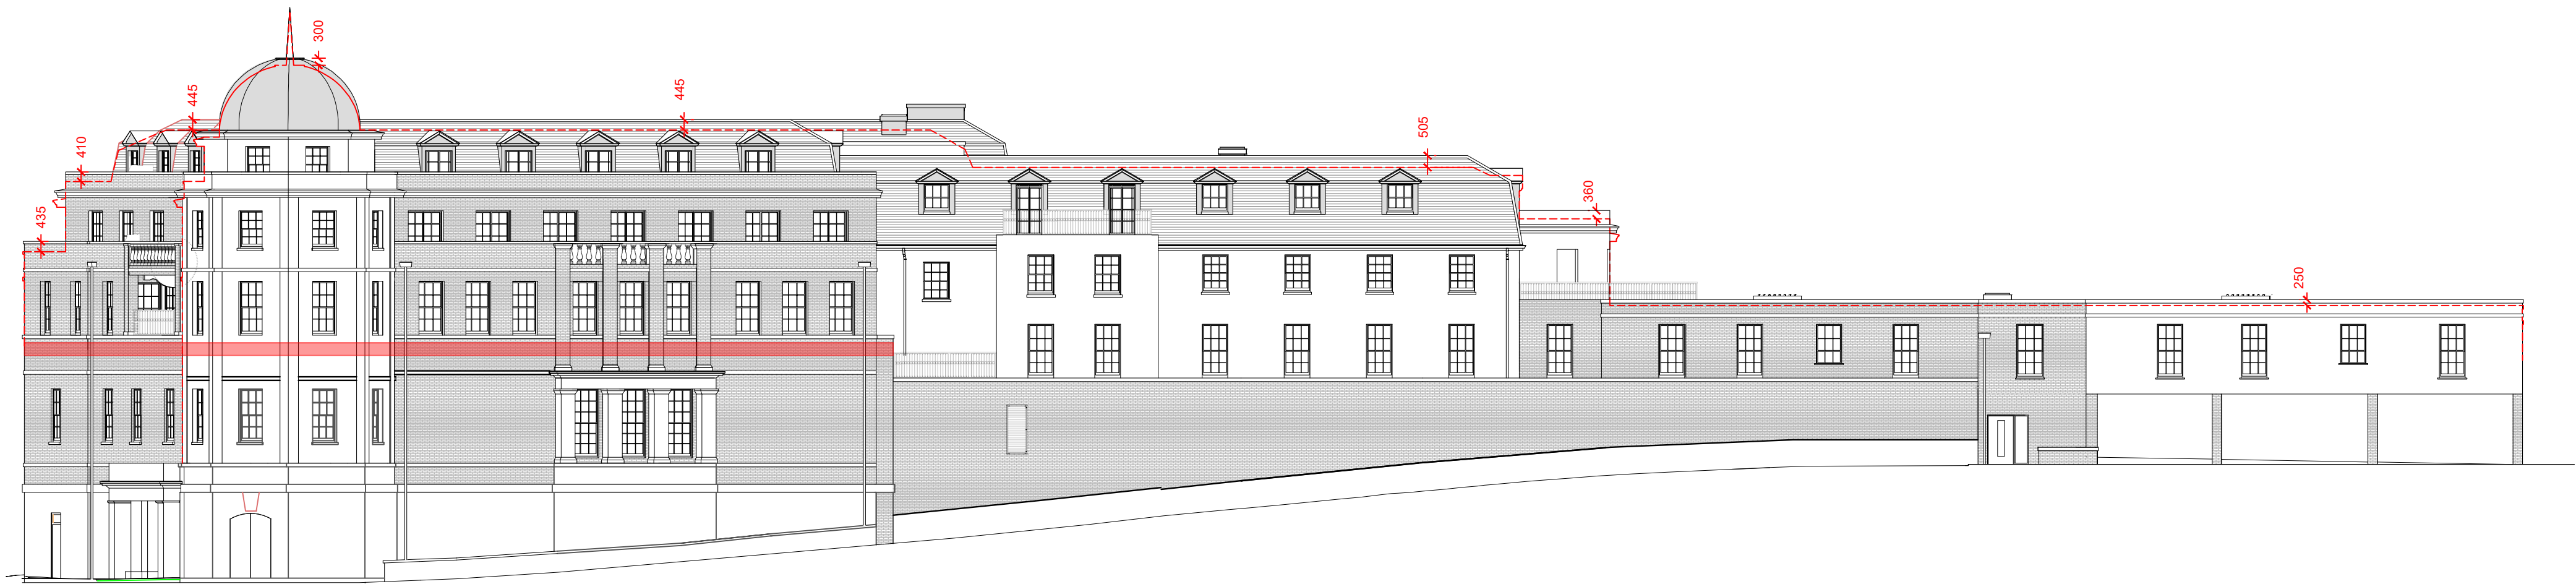

PROPOSED ELEVATION (WEST)
scale 1:200

0 2 4 6 8 10 12 14 16 18 20m 1:200 LINEAR SCALE

E	03.08.26	Addition of a plain band on first floor south
D	16.07.16	Changes to 1st floor windows height
C	03.07.26	General amendments
B	23.06.26	Note omitted
A	07.04.26	Scale bar added/Red lines around windows removed
-	20.05.25	First issue
Rev	Date	Description
ACCEL CONSULTING LTD		
23 Southwick Street		
Southwick, B84 4TB		
Tel: 01273 934921		
www.accelconsulting.co.uk		
Client		
CAYUGA 013 LLP		
Project	No.	
MONTAGUE QUARTER, WORTHING	1983	
Drawing Title		
PROPOSED ELEVATIONS WITH CHANGES MARKED		
Drawing No.	Rev	Scale
573-305	E	03 Aug 2026 1:200@A1

PLANNING ISSUE

ACCEL Consulting Ltd