




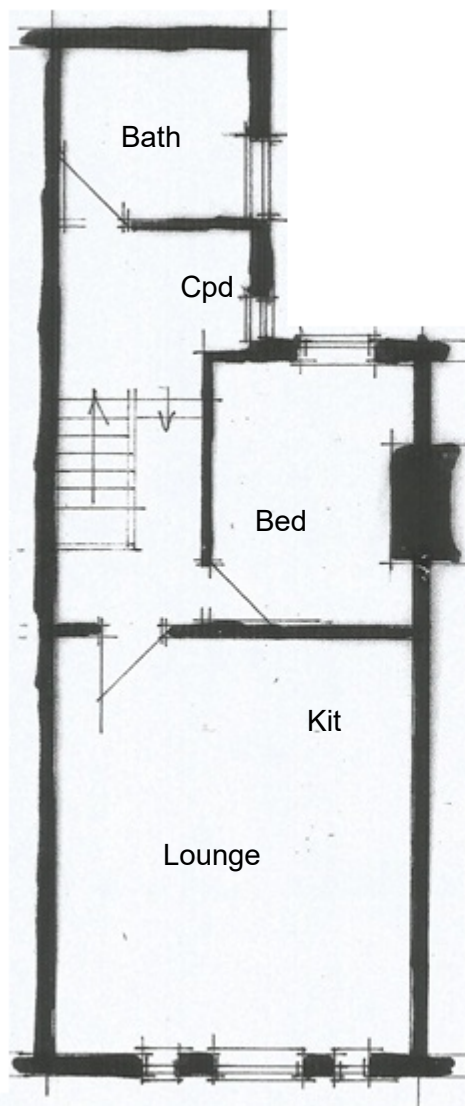

Plan as approved 1:100
(AWDM/1892/21)

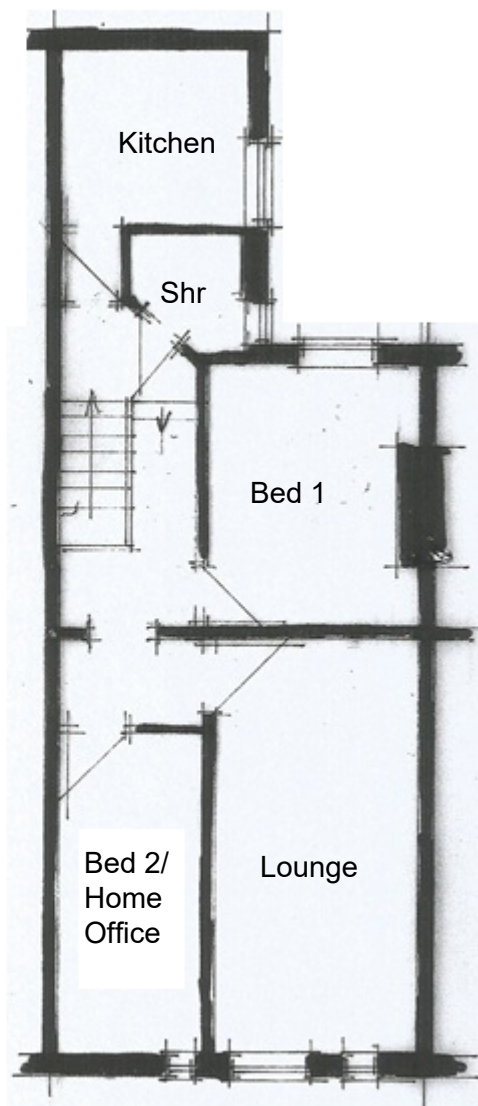


Plan as built 1:100

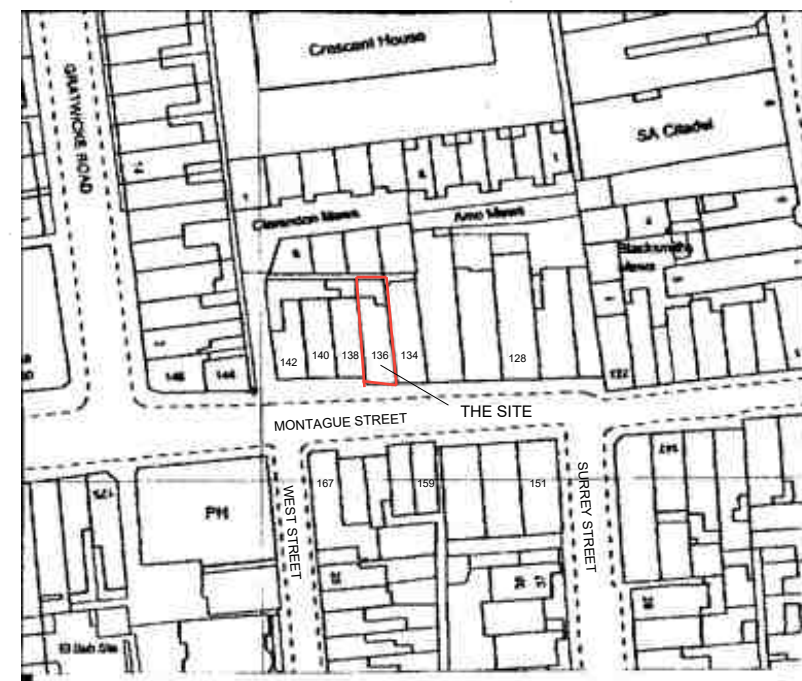

Site plan 1:1250



Block plan 1:500

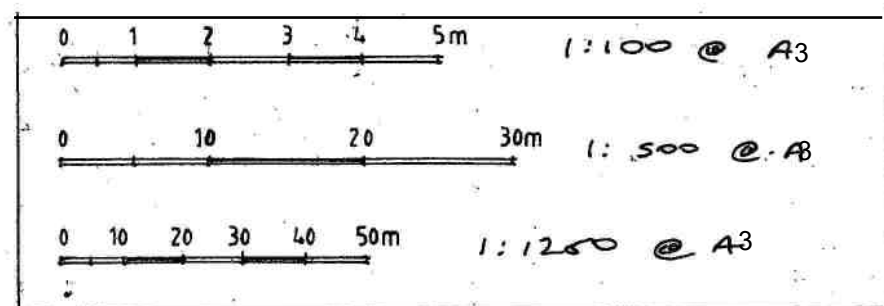

AJ SALTER & SON
Architectural Technicians
and Surveyors
50 WINDSOR ROAD, WORTHING,
WEST SUSSEX, BN11 2LY
Tel/Fax: (01903 209496)
E-mail: ajsalterandson@hotmail.com

C			
B	Room description changed	Apr 26	IS
A	Plans altered	Jan 26	IS
Client K. Gopalan Esq			
Address First Floor Flat : 136 Montague Street : Worthing			
Drawing Alterations to layout			No. 0226 :1b
Scale 1:100 1:500 1:1250		Drawn IS	Date Jan 26