





ORIGINAL ROOF PLAN. SCALE 1:100

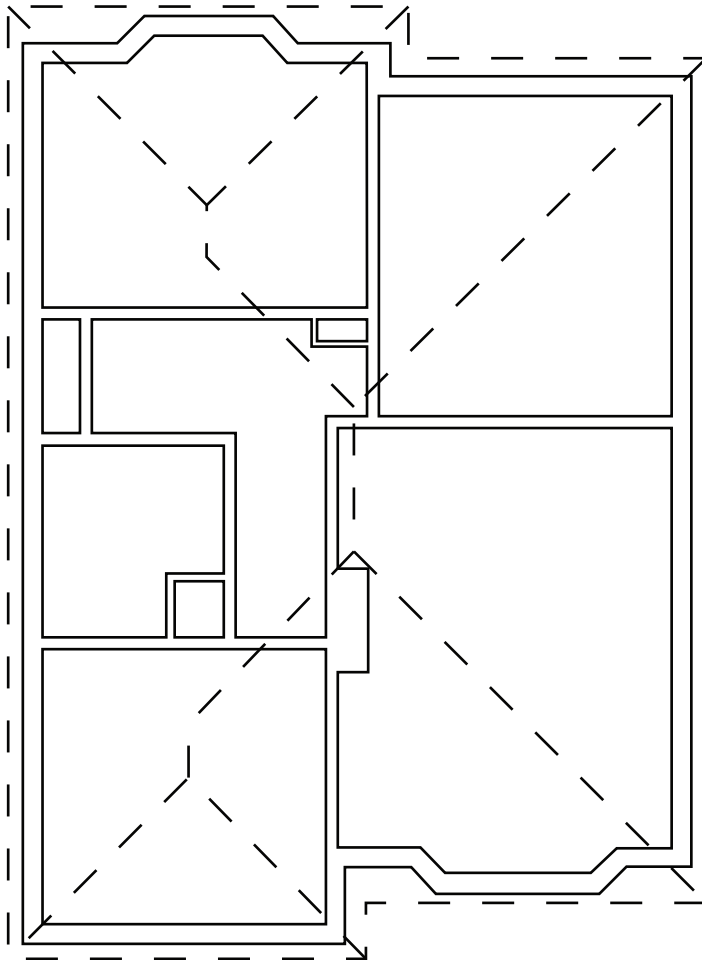

ROOF PLAN. SCALE 1:100

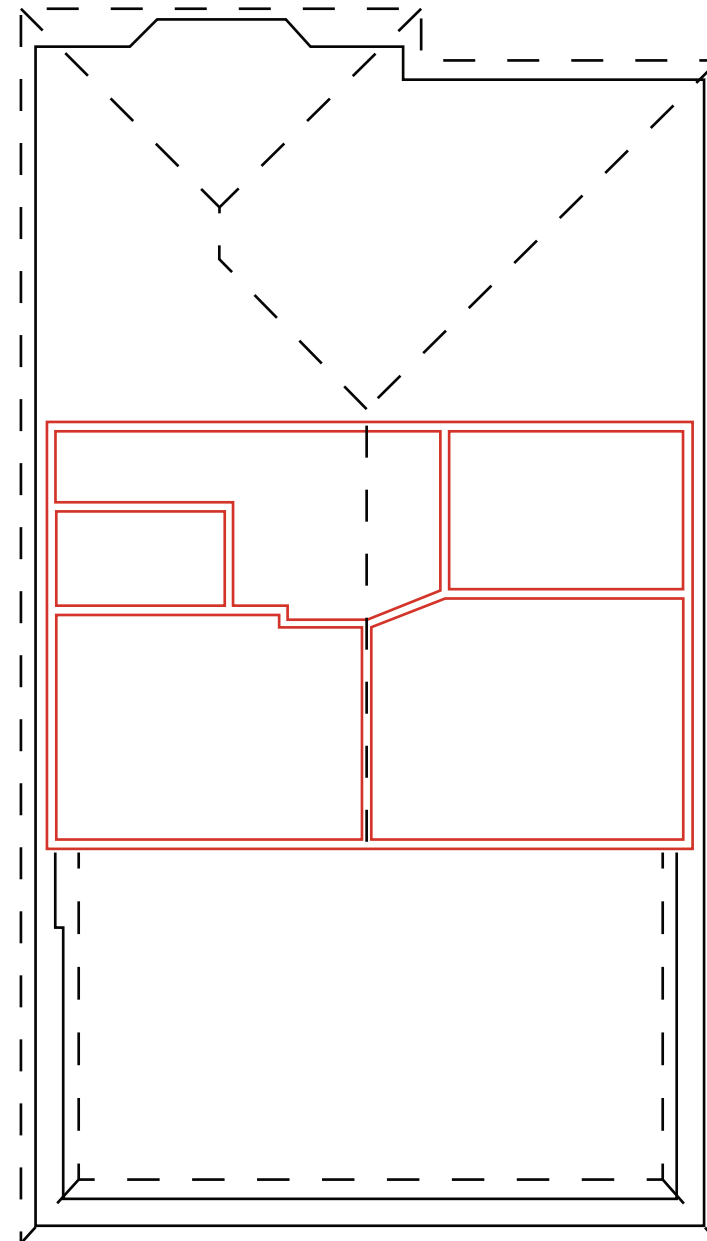

ROOF PLAN AS BUILT. SCALE 1:100