

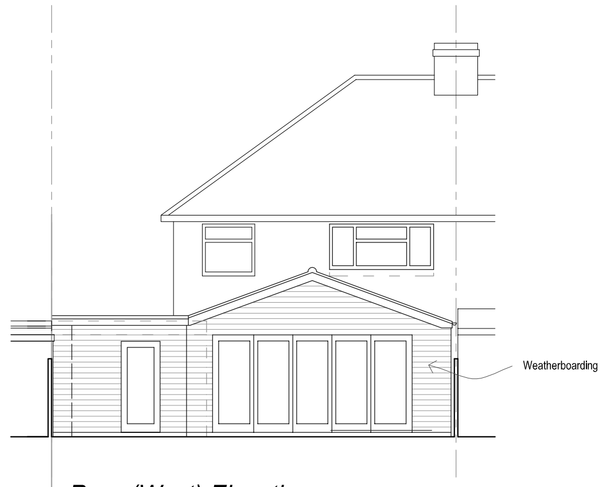


Rear (West) Elevation @ 1:100

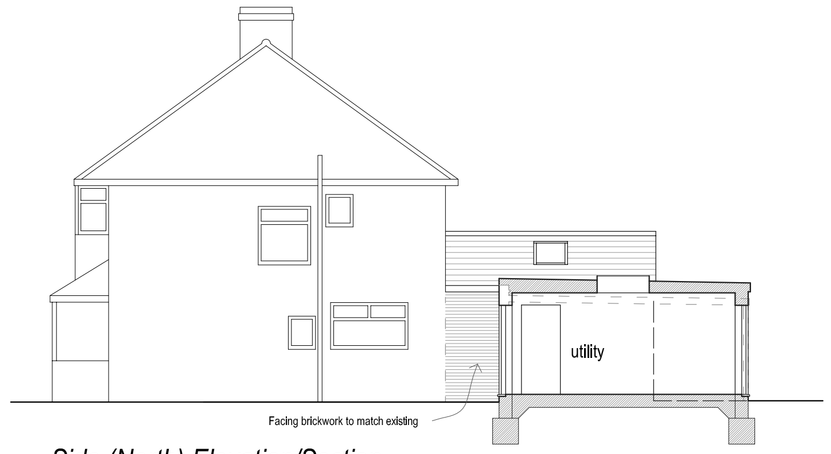


Side (North) Elevation/Section @ 1:100

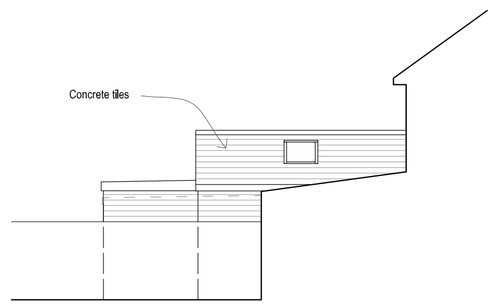


Side (South) Elevation @ 1:100

Looking from 15 The Crescent

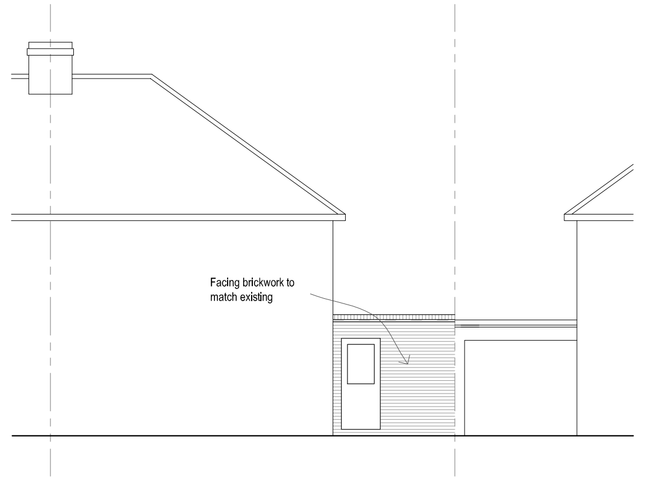



Front (East) Elevation @ 1:100

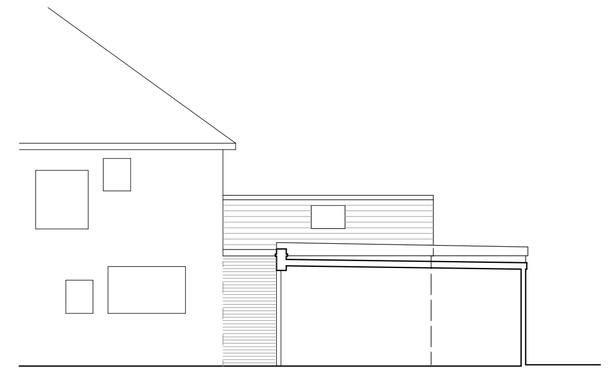


Side (North) Elevation @ 1:100

Looking from 19 The Crescent

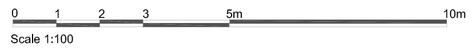


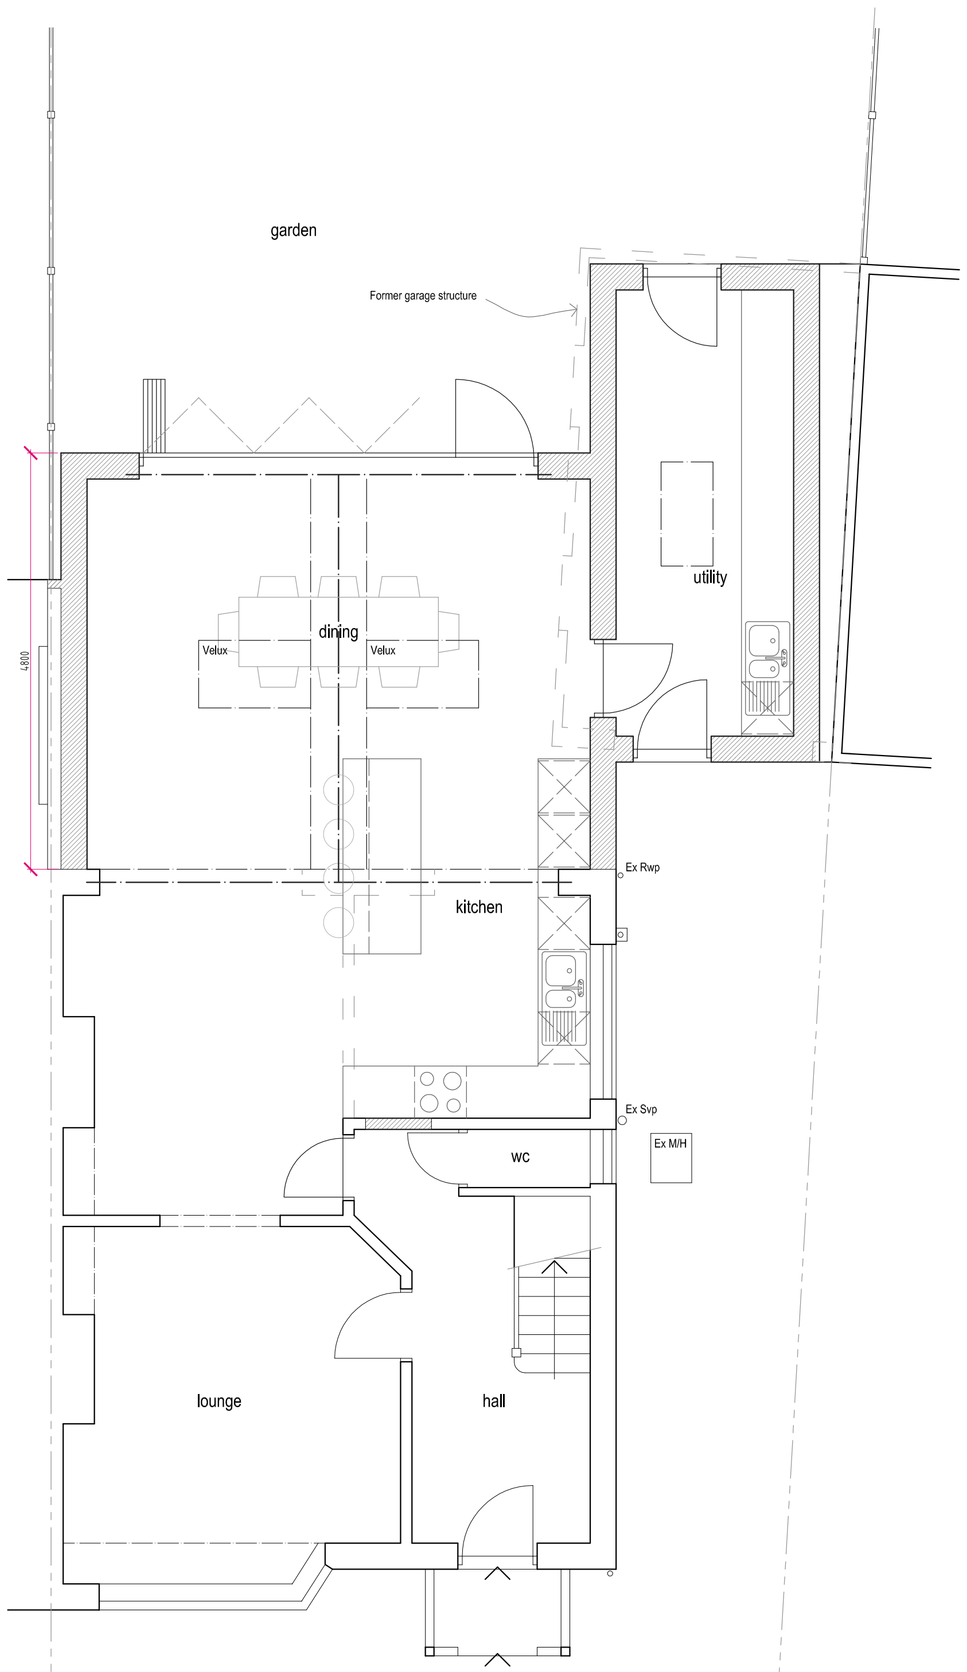


Ground Floor Plan @ 1:50

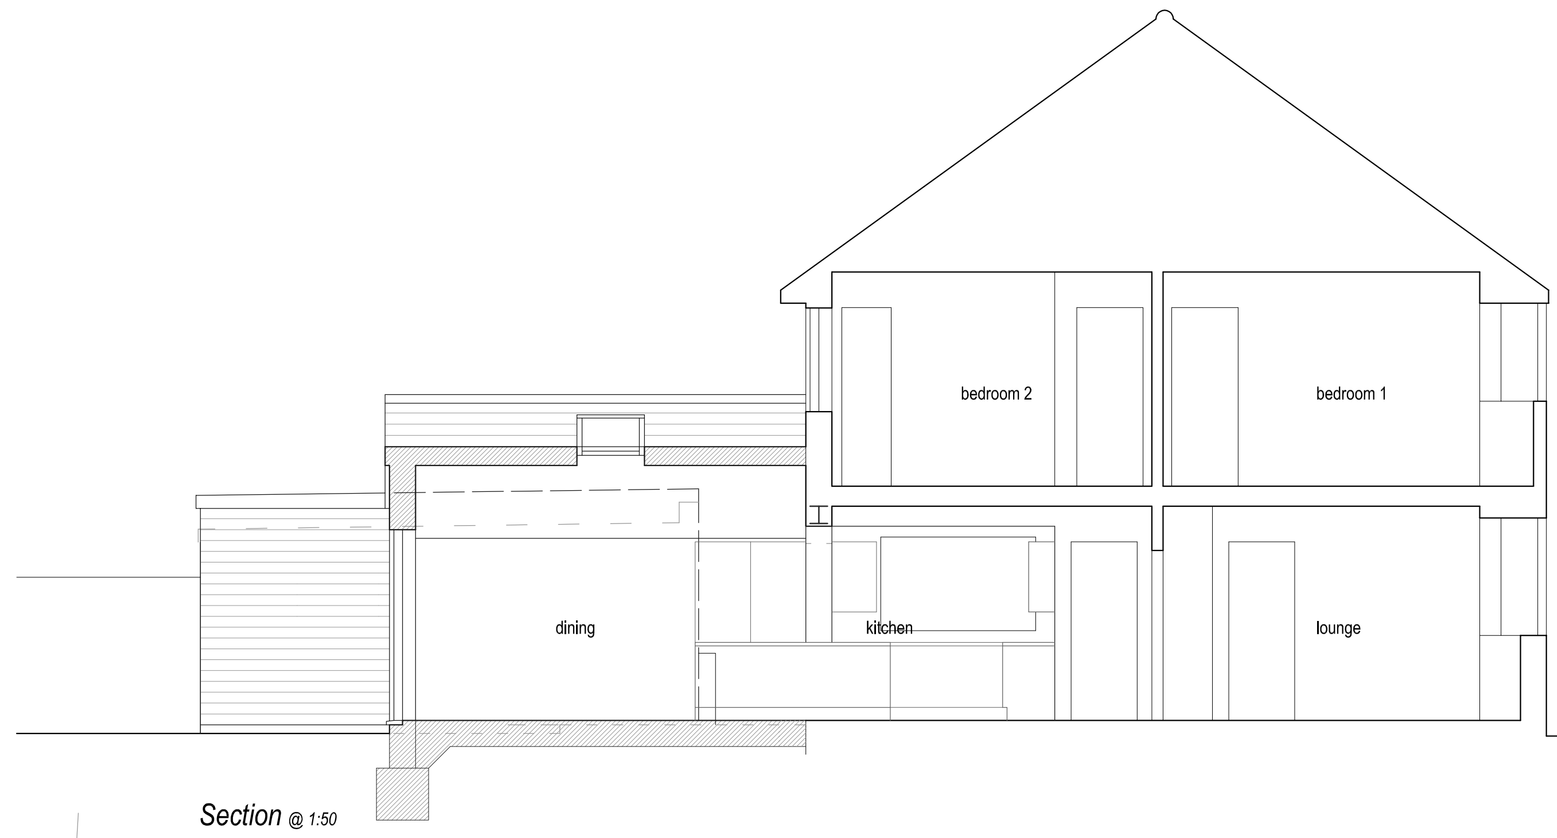


Section @ 1:50

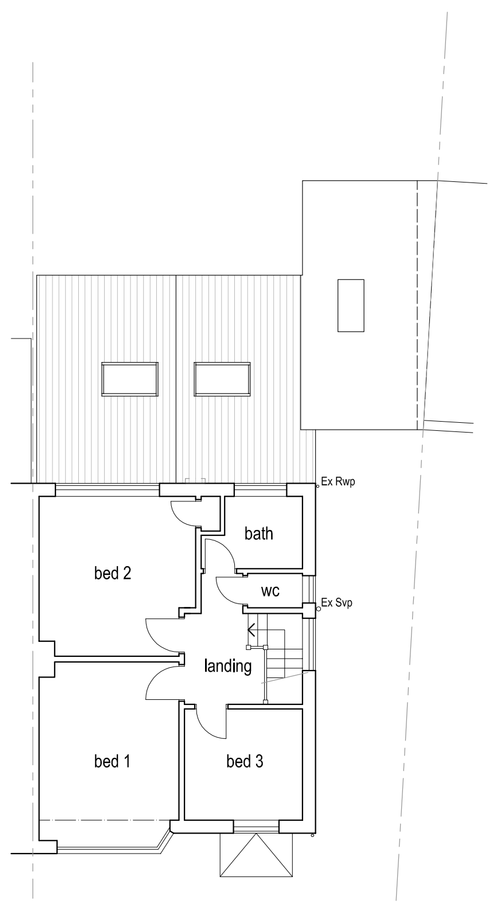

First Floor Plan @ 1:100

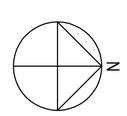

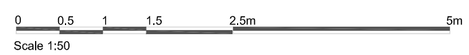

Rev	Description	Date
C	Elevations relabelled	02.07.19
B	Amended as built	20.06.19
A	Utility room lengthened	22.05.18

Job Reference	Client
Rear Extension 17 The Crescent Southwick	Mr Cranston
Drawing Title	**Drawing No** / **Rev**
Proposal	ADC1108/01 C

Date	Scale	Dwg Size	Plot Style	Drawn	Checked
30.04.18	1:50/100	A1	ADCgreyscale	AD	TCG

~~All dimensions to be checked on site and do not scale from this drawing.~~ This drawing should be approved by Local Authority Building Control or other appropriate checking authority prior to commencement of work. This drawing should not be reproduced without the prior consent of the author.

ADC Alistair Dodd Consulting
Architectural Services
72a Beaconsfield Road . Brighton . East Sussex . BN1 6DD
Tel: 01273 669466
Email: info@adcbrighton.co.uk
WWw.adcbrighton.com