


REVISIONS:
REV: DATE: BY: RVW:

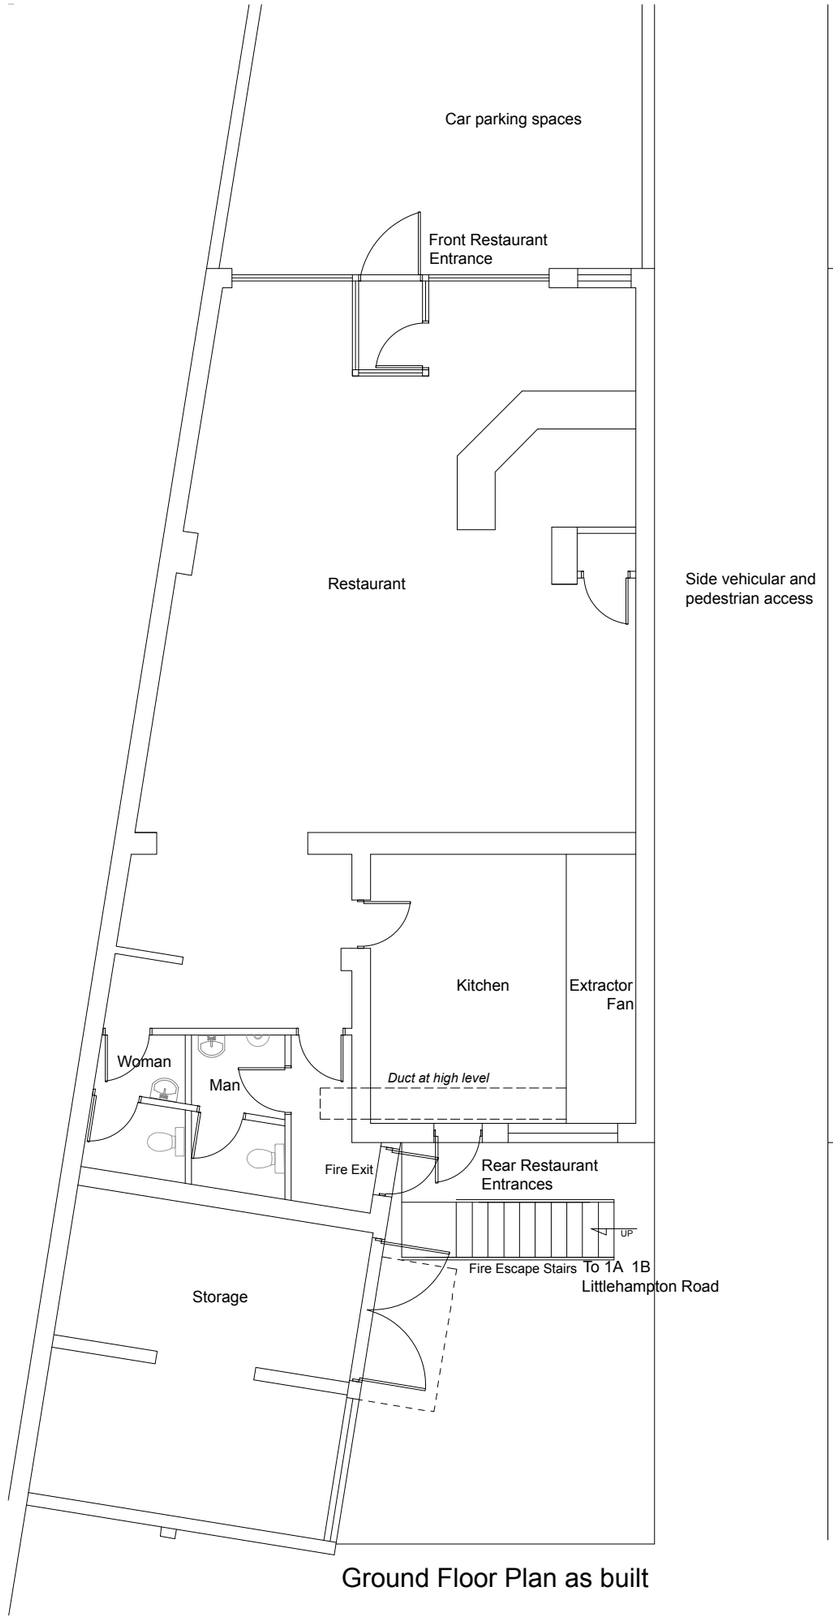

Ground Floor Plan as built

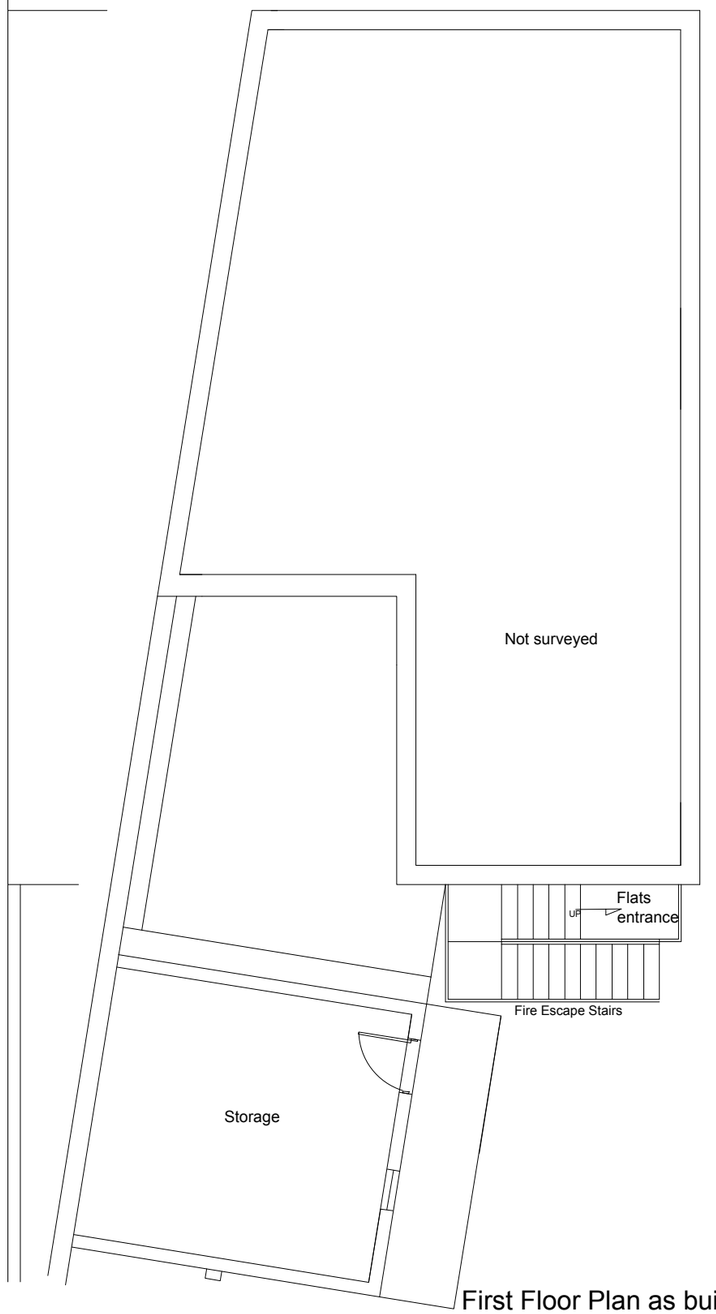

First Floor Plan as built

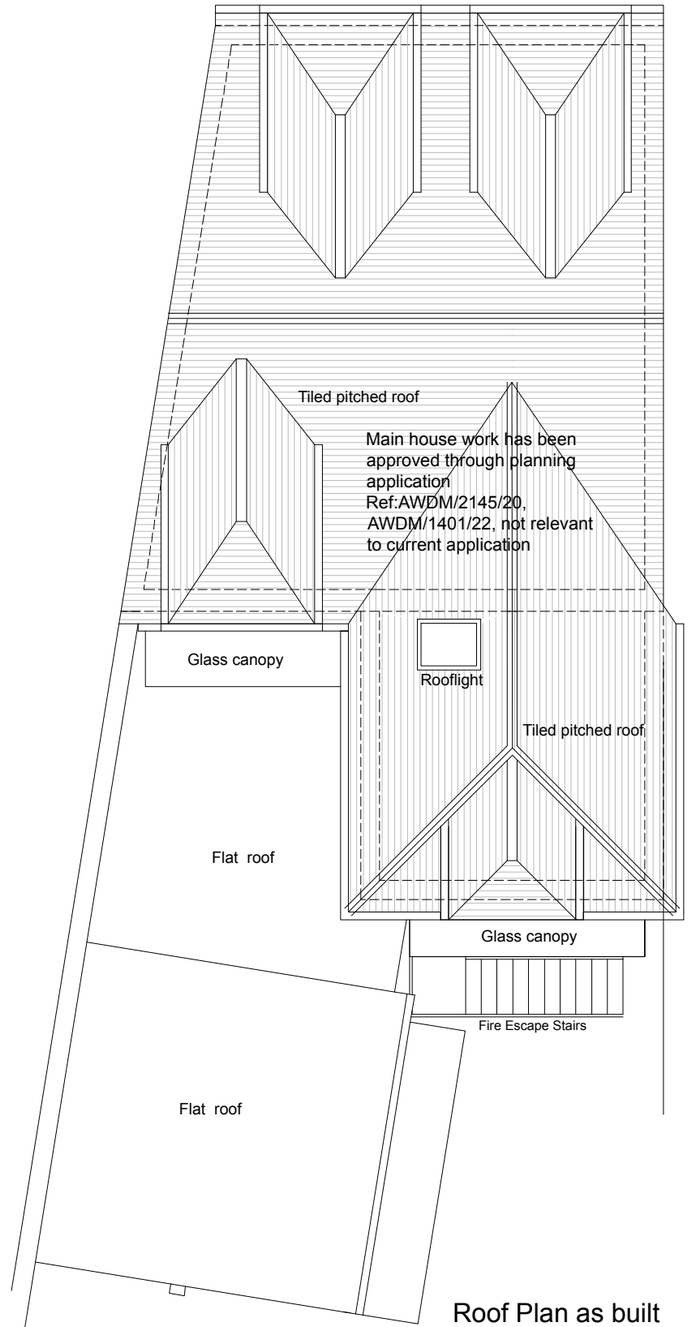

Roof Plan as built

N

Scale 1:100

0 1 5m 10m

This drawing is for Planning Permission purpose only. All dimensions to be confirmed on site.

© This drawing is the sole copyright of Wang Dao Architecture Ltd.

Any discrepancies between this drawing & other information shall be reported to the Architect. MODIFICATIONS to be made solely on ORIGINAL MAGNETIC MEDIA.

CLIENT
Mr Xian

PROJECT
1 Littlehampton Road
Worthing
BN13 1PY

TITLE
Extension over storage
Plans as built

STATUS
Planning

DATE
February 2025

SCALE @ A3
1:100

DRAWN BY
Edward

REVIEWED BY

DRAWING NUMBER
WDA PL2 102

CTB file:
XREF'S:
LTscale: