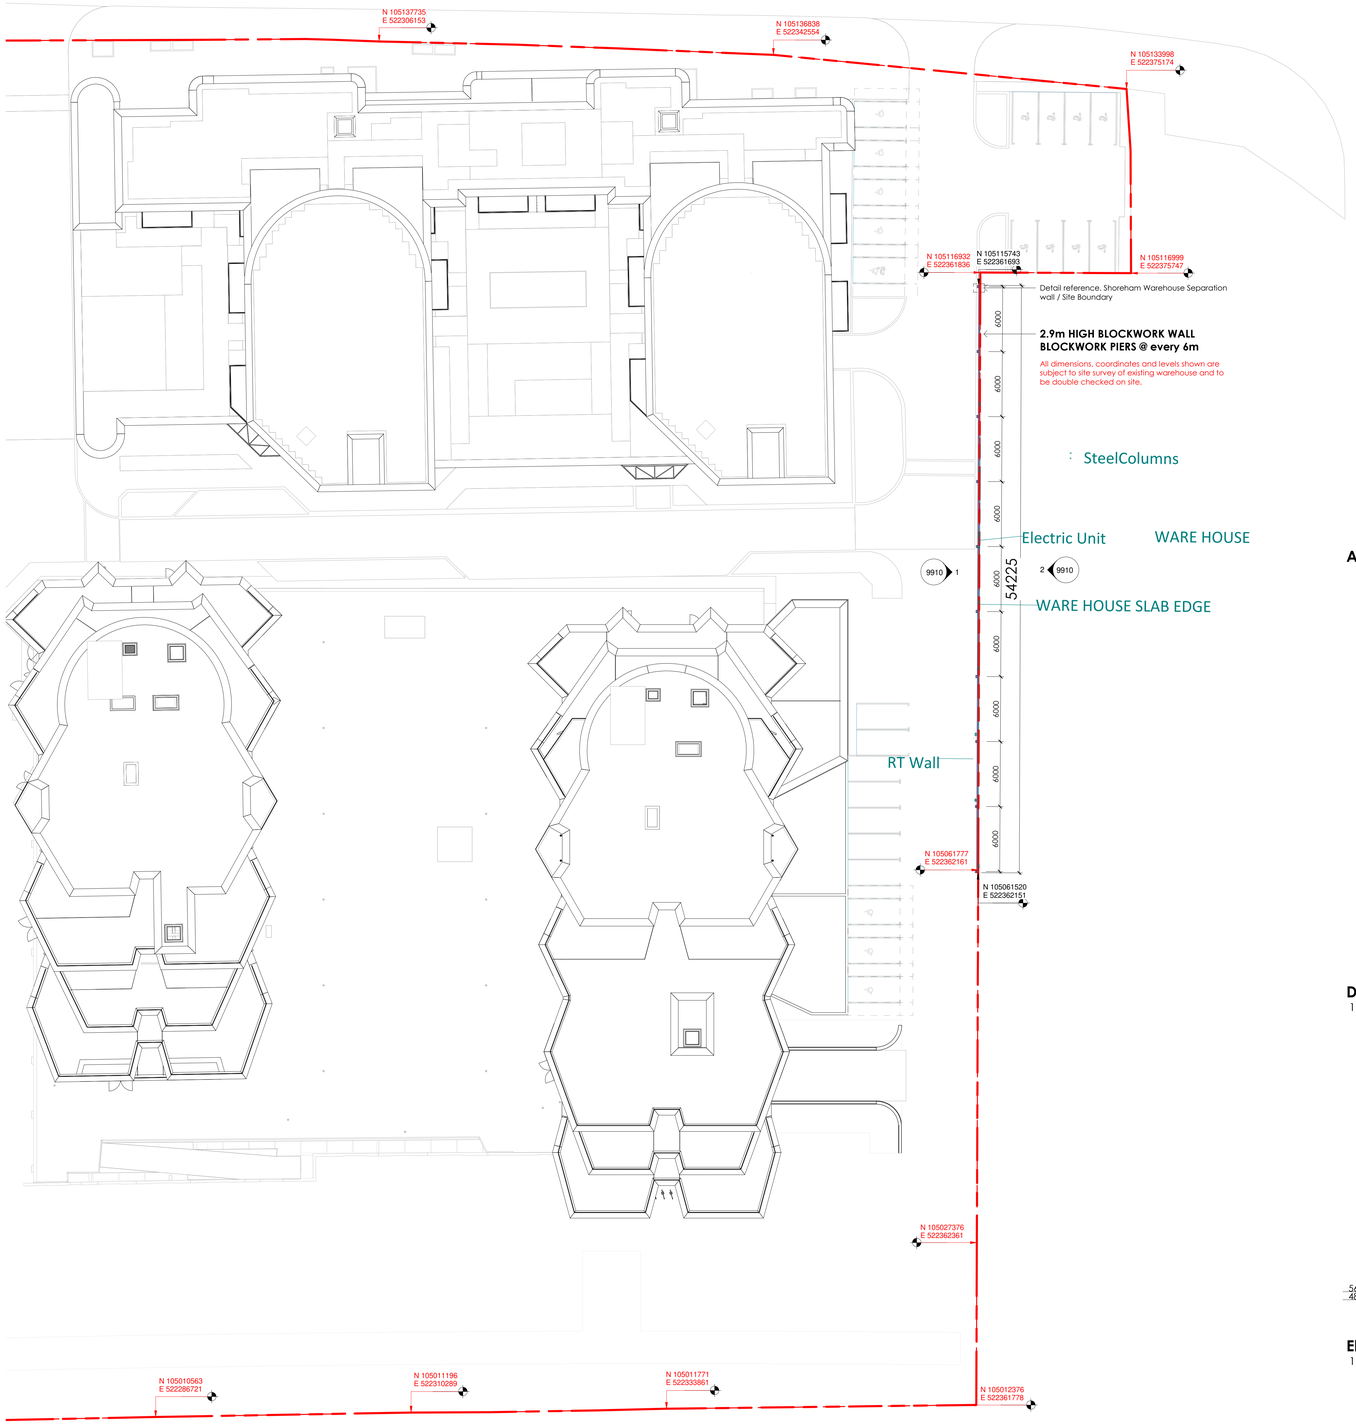

Plan. Shoreham Warehouse Survey overlay
1 : 200

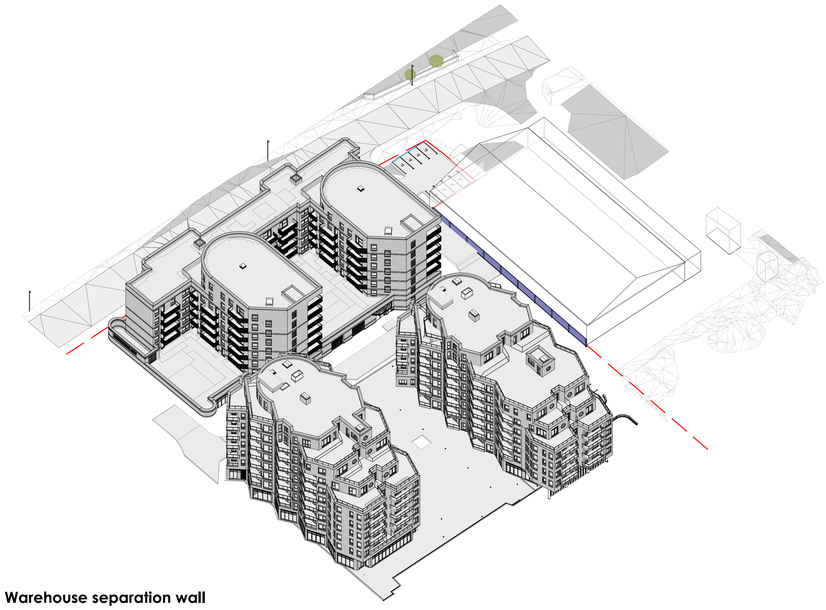

Axo. Warehouse separation wall

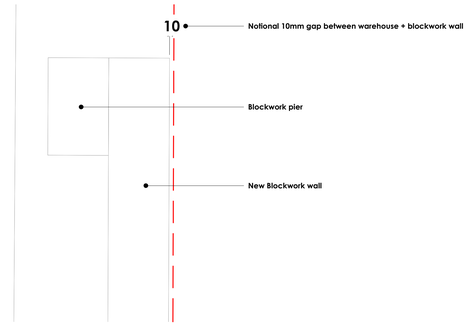

Detail. Shoreham Warehouse Separation wall / Site Boundary
1 : 5

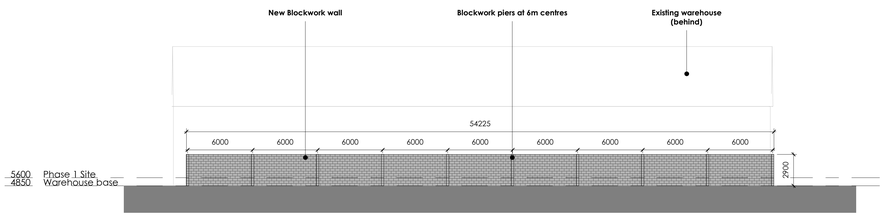

Elevation 1. Warehouse separation wall - West
1 : 200

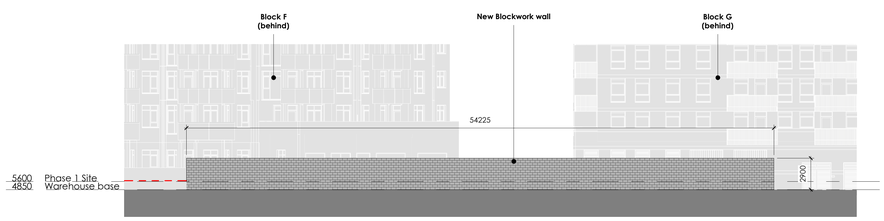

Elevation 2. Warehouse separation wall - East
1 : 200

HG CONSTRUCTION
aca studios
address : 88 Union Street London SE1 0NW **phone** : 020 7593 1000
email : mail@acastudios.co.uk **web** : www.acastudios.co.uk

job: Free Wharf Shoreham-by-Sea	**drawn:** HK	**date:** 01/25
drawing: General Arrangement Warehouse Survey overlay	**scale:** 1 : 200 @ A0 1 : 400 @ A2	**job number:** 3117
drawing number: 3117-ACA-ZZ-ZZ-DR-A-9910		SK03

SKETCH

note: all dimensions to be checked on site before commencement of the work. If this drawing exceeds the quantities in any way the architects are to be informed before work is commenced. this drawing is copyright.

revisions (most recent listed below, refer to DIS for all revisions)

rev	date	description	drawn	check
SK01	10.01.25	Issued as sketch as requested by HGC	HK	DrB
SK02	12.02.25	Axo and Elevation views added to sheet	HK	DrB
SK03	12.02.25	Site boundary line adjusted and detail callout added	HK	DrB

WAREHOUSE SEPARATION SKETCH PLAN

Based on:

HGC sketch received 10.01.25: 'Warehouse Block work scope mark up - 20mm gap between block work wall & internal cladding wall not 100mm.'

Blockwork wall - 2.9m high
- assumed base level +4.85 based on drawings contained within Party Wall award 'SF _ Served Award (Jul 2020)' dated 02.07.19

HGC survey: 'Shoreham Warehouse Survey' dated 10.12.24

Site boundary line
Based on CZWG drawings: 2052-00-DR-0010-T10 - 2052-00-DR-0015)

All dimensions, coordinates and levels shown are subject to site survey of existing warehouse and to be double checked on site.

LOCATION PLAN **SCALE 1:2500**

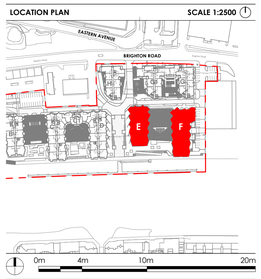

Warehouse Survey overlay
not for construction