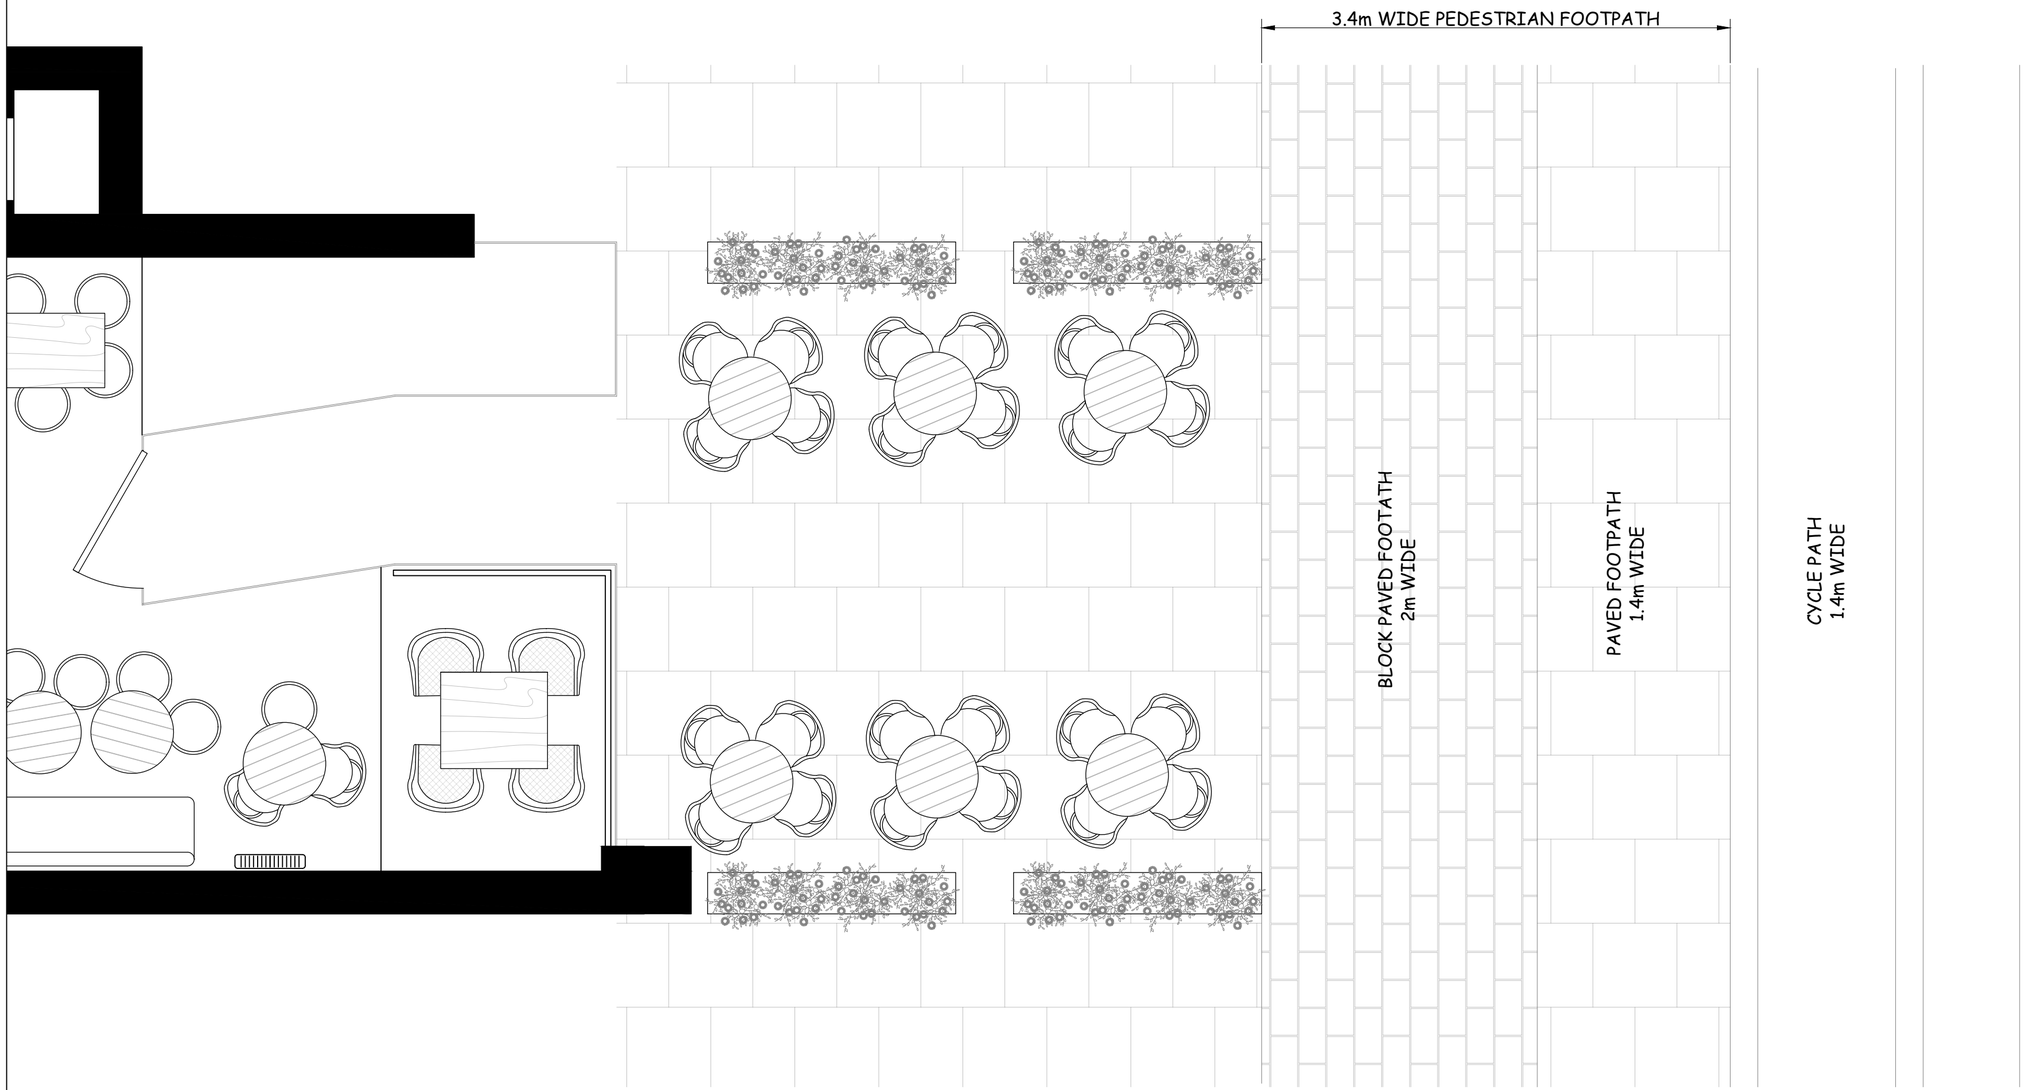


NOTES:

1. ALL DIMENSIONS IN mm

Rev	Detail	By	Auth	Date

Revisions

Client

THE FYNN

Project

THE FYNN
54 GORING RD
WORTHING
BN12 4AD

Drawing Title

OUTSIDE AREA
SHOWING FOOTPATH
AND CYCLE PATH

Drawing Status

AS BUILT

Project No.	Discipline	Drawing No.
GVA		002

Scale	Sheet Size	Revision
1:50	A1	

Date	Drawn	Checked	Auth
13.08.25	DS		