TPO 12/92


FIRST SCHEDULE

Amended 5th October 19

No. on Plan	Species	Situation
T1	Lime	Grassed area, western side of Worthing Hospital, adjacent to Park Road
T2	Horse Chestnut	Grassed area, western side of Worthing Hospital, adjacent to Park Road
T3	Horse Chestnut	Grassed area, western side of Worthing Hospital, adjacent to Park Road
T4	Purple Beech	Grassed area, western side of Worthing Hospital, adjacent to Park Road
T5	Lime	Grassed area, western side of Worthing Hospital, adjacent to Park Road
T6	Silver Birch	Grassed area, north-west of Worthing Hospital, adjacent to driveway
T7	Leyland Cypress	North-western part of grounds of Worthing Hospital, adjacent to Homefield Park
T8	Ash	North-western part of grounds of Worthing Hospital, adjacent to Homefield Park
T9	Sweet Chestnut	North-western part of grounds of Worthing Hospital, adjacent to Homefield Park
T10	Ash	Northern part of grounds of Worthing Hospital, adjacent to Homefield Park
T11	Silver Birch	Northern part of grounds of Worthing Hospital, adjacent to driveway from Park Avenue
T12	Variegated False Acacia (Robinia Frisia)	North-eastern side of Worthing Hospital, adjacent to driveway
T13	Ash	Eastern side of grounds of Worthing Hospital (rear of 29-31 Park Avenue)
T14	~~Lime~~ Plane	Eastern side of Park Avenue (outside Nos.2/4)
T15	~~Lime~~ Plane	Eastern side of Park Avenue (outside No.12)

No. on Plan	Species	Situation
T16	~~Lime~~ Plane	Western side of Park Avenue (outside Hospital)
T17	~~Lime~~ Plane	Western side of Park Avenue (outside Hospital)
T18	~~Lime~~ Plane	Western side of Park Avenue (outside Hospital)
T19	~~Lime~~	Western side of Park Avenue (outside Hospital)
T20	Ash	North-western corner of rear garden of 31 Park Avenue
~~T21~~	~~Ash~~	~~Northern part of rear garden of 47 Park Avenue, adjacent to Homefield Park~~
T22	Hawthorn	Northern part of rear garden of 59-61 Park Avenue, adjacent to Homefield Park
T23	Yew	North-eastern corner of front garden, 53 Homefield Road
T24	Bay	Front garden of 49 Homefield Road
T25	Tree of Heaven	Rear garden of 33 Homefield Road
T26	Sycamore	Adjacent to western boundary of 'Homefield', Homefield Road
T27	Sycamore	Adjacent to western boundary of 'Homefield', Homefield Road
T28	Purple Beech	South-eastern corner of grounds of 'Homefield', Homefield Road/ Lyndhurst Road
T29	Monterey Cypress	Southern side of grounds of 'Homefield', adjacent to Lyndhurst Road
T30	Irish Yew	Southern side of grounds of 'Homefield', adjacent to Lyndhurst Road
T31	Sycamore	Southern side of grounds of 'Homefield', adjacent to Lyndhurst Road
T32	Purple Beech	Southern side of grounds of 'Homefield', adjacent to Lyndhurst Road

No. on Plan	Species	Situation
G1	Group consisting of 2 Scots Pine and 1 Lime	Western side of Worthing Hospital, (south of transformer station)
G2	Group of 2 Ash	Western side of Worthing Hospital, within grassed area adjacent to driveway to Park Road
G3	Group of 3 Lime	Northern part of grounds of Worthing Hospital, adjacent to Homefield Park
G4	Group of 2 Sycamore and 1 Leyland Cypress	Rear garden of No.37 Park Avenue, adjacent to Homefield Park
G5	Group of 2 Sycamore, 2 Holm Oak, 1 Common Yew and 1 Leyland Cypress	North-eastern side of grounds of 'Homefield', adjacent to Homefield Road

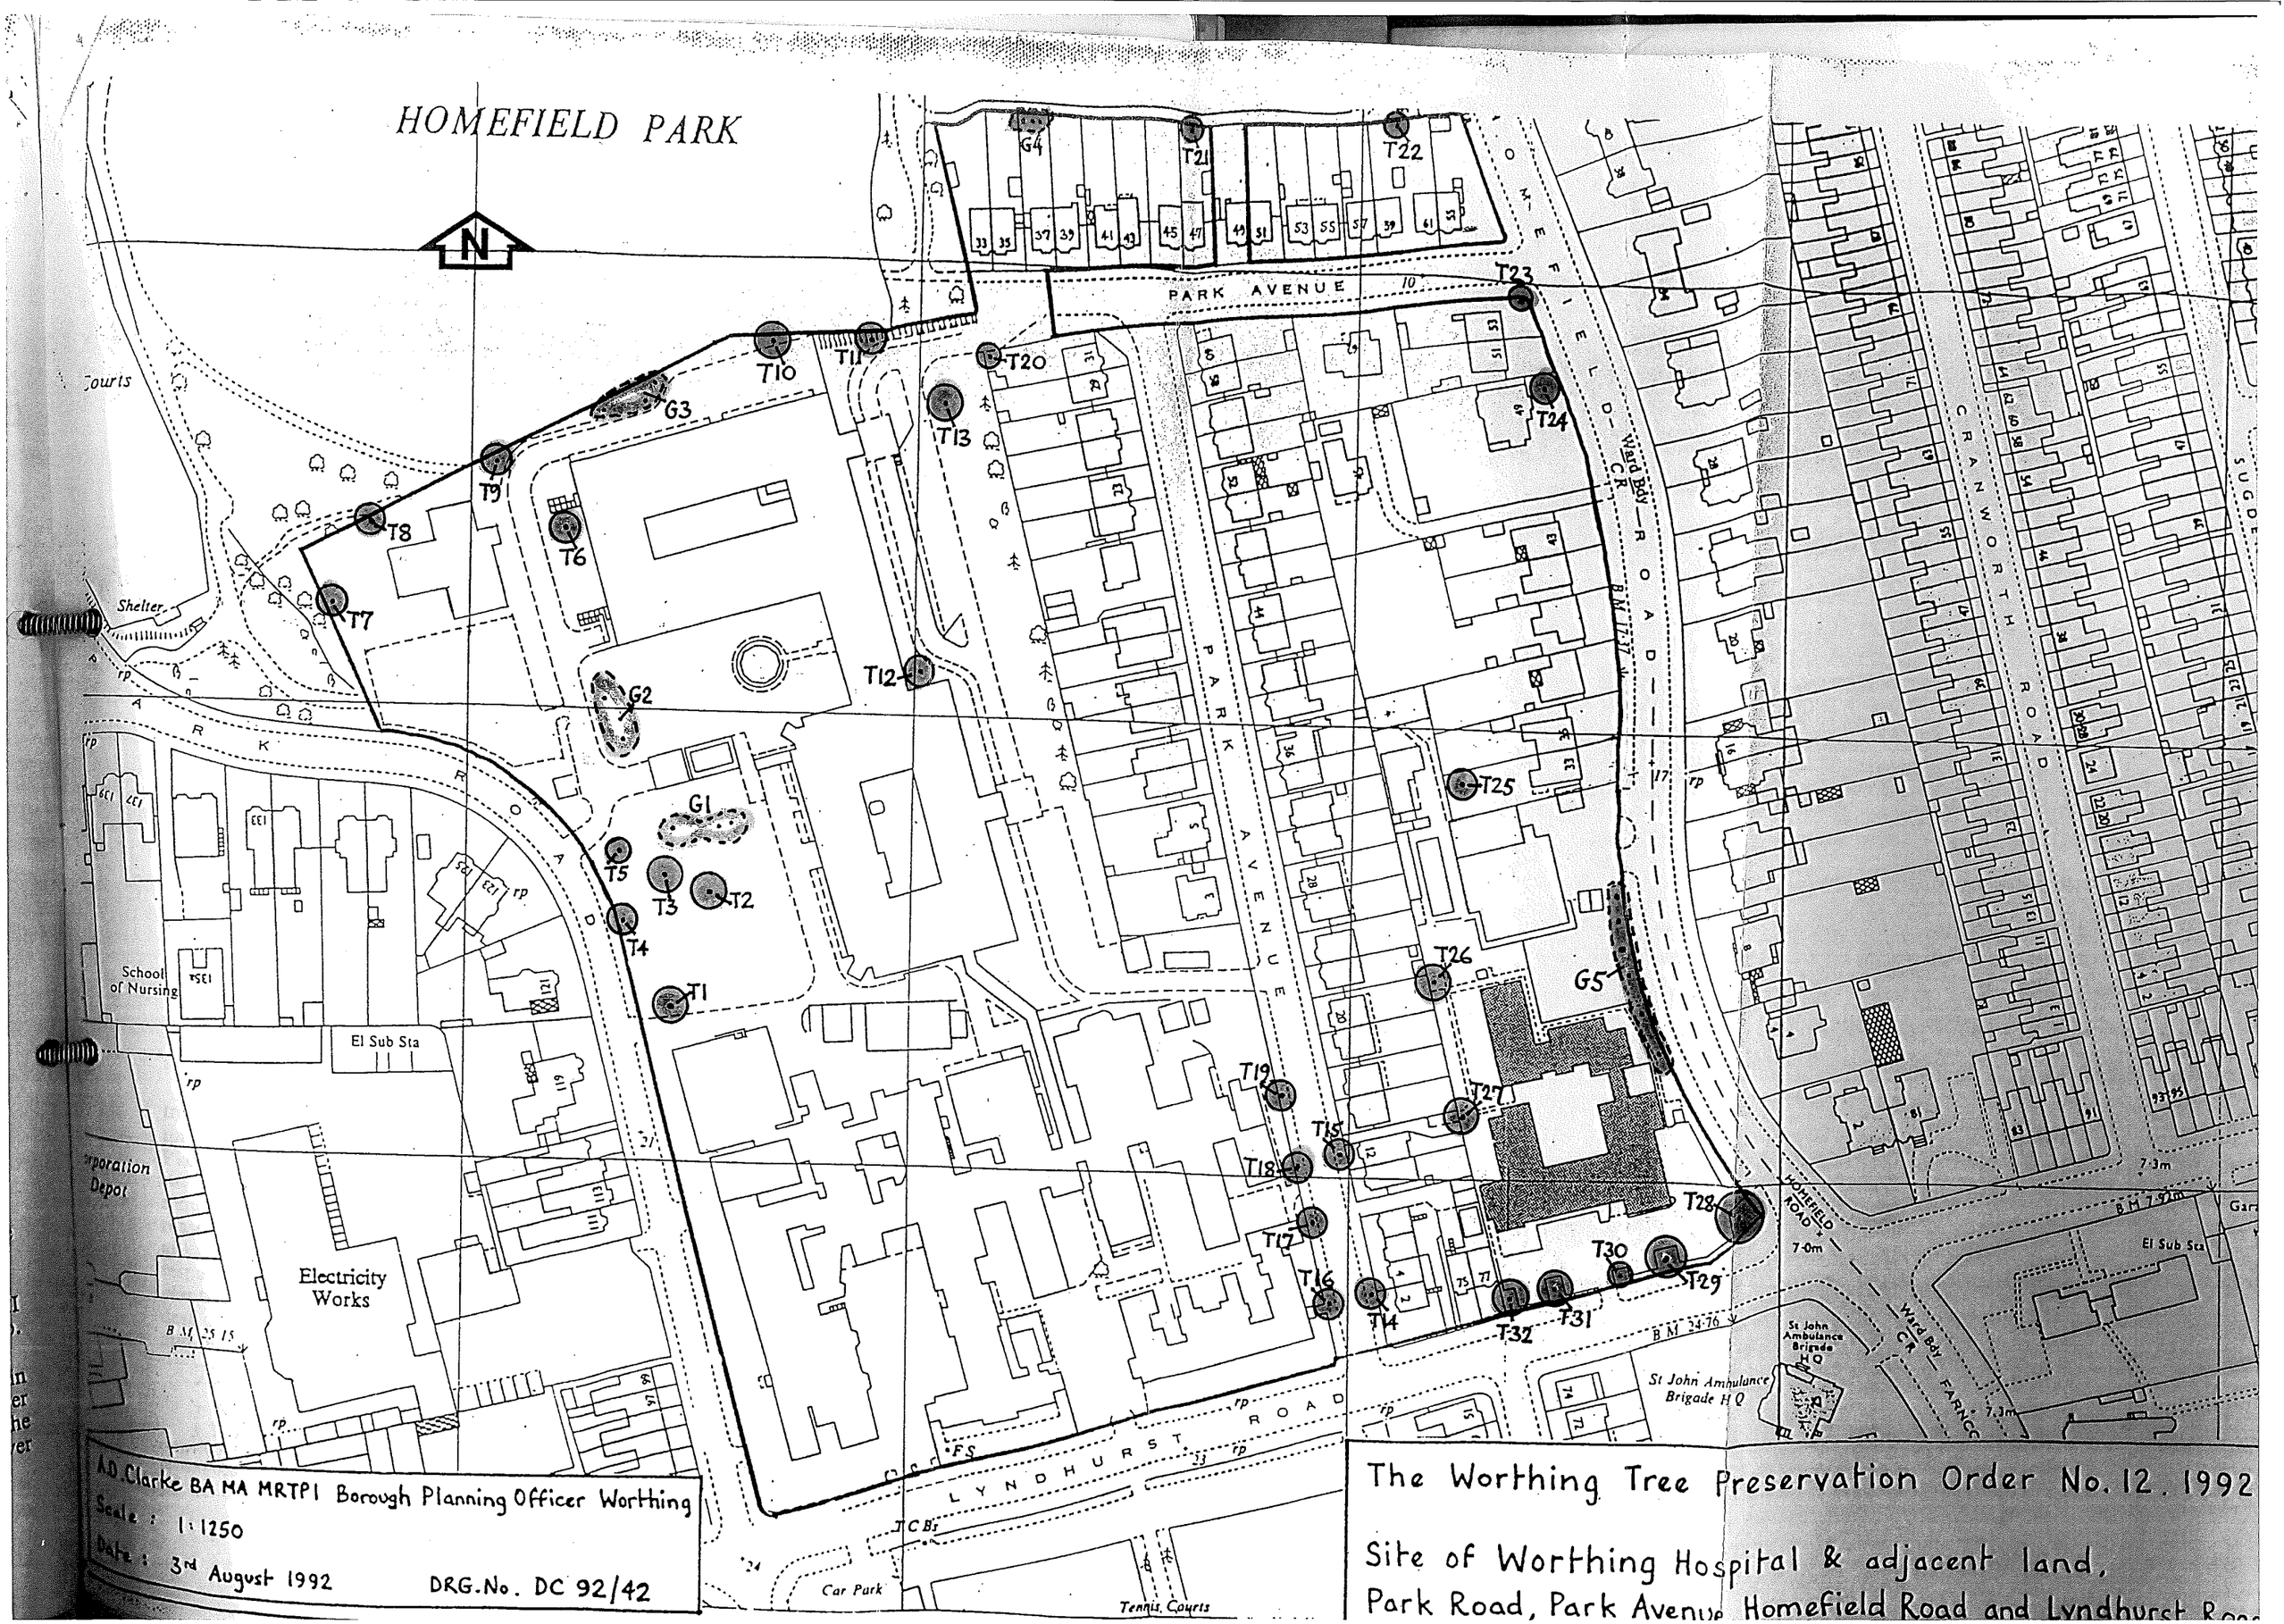

A.D. Clarke BA MA MRTPI Borough Planning Officer Worthing

Scale : 1:1250

Date : 3rd August 1992 DRG.No. DC 92/42

The Worthing Tree Preservation Order No. 12. 1992

Site of Worthing Hospital & adjacent land, Park Road, Park Avenue, Homefield Road and Lyndhurst Road