



SITE LOCATION PLAN
1:1250 SCALE

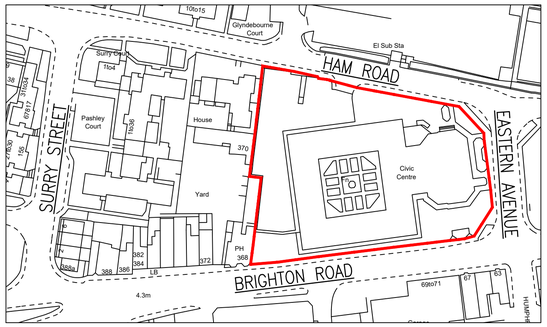

'ROAD' PLAN
1:500 SCALE

DENOTES 'ROAD'

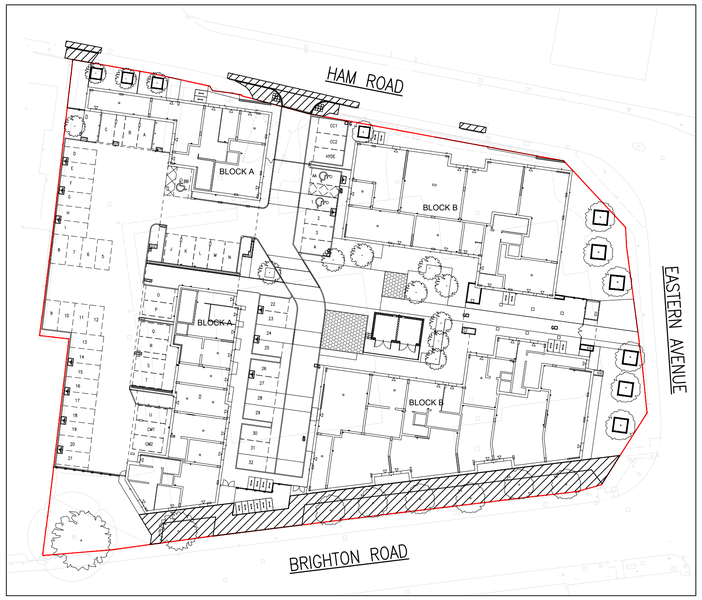

ROAD NOTES & LEGEND

- S278 CARRIAGEWAY – DETAIL A1
- S278 FOOTWAY – DETAIL A2
- S38 FOOTWAY – DETAIL A3
- S38 VERGE – DETAIL A4
- SOFT LANDSCAPE. REFER TO LANDSCAPE ARCHITECTS DETAILS.
- TACTILE PAVING (SEE WSCC DRAWING NO. S278/38/04 & 08)
- PRIVATE SURFACE WATER DRAINAGE.
- HIGHWAY BOUNDARY

NOTES

1 NO WORK SHALL COMMENCE WITHIN EXISTING PUBLIC HIGHWAY UNTIL AGREEMENT IS SIGNED.

2 ANY SOFT SPOTS WITHIN THE PROPOSED HIGHWAY SHALL BE DUG OUT AND THE VOID BACKFILLED IN LAYERS UP TO FORMATION LEVEL WITH SELECTED GRANULAR MATERIAL AS DIRECTED AND TO THE SATISFACTION OF THE THE HIGHWAYS INSPECTOR.

3 ALL FILL MATERIAL UP TO FOUNDATION LEVEL OF THE PROPOSED HIGHWAY TO BE APPROVED AND COMPACTED IN LAYERS AS DIRECTED AND TO THE SATISFACTION OF THE HIGHWAY INSPECTOR.

4 ANY DAMAGE CAUSED TO THE EXISTING HIGHWAY DURING THE COURSE OF THE WORKS TO BE REPAIRED AS DIRECTED AND TO THE SATISFACTION OF THE HIGHWAYS INSPECTOR AND/OR AREA ENGINEER.

5 CONTINUITY OF ACCESS TO OCCUPIED AREAS TO BE MAINTAINED TO SATISFACTION OF HIGHWAYS INSPECTOR, AREA OFFICE ENGINEER AND/OR LOCAL AUTHORITY.

6 ANY ABANDONED/REDUNDANT PIPES AND CHAMBERS THAT FALL WITHIN THE PROPOSED HIGHWAY SHALL BE GRUBBED UP AND THE VOID BACKFILLED IN LAYERS UP TO FORMATION LEVEL OF THE CARRIAGEWAY WITH SELECTED GRANULAR MATERIAL OR PERMANENTLY FILLED WITH CONCRETE (OR SIMILAR FILLER).

7 ALL REDUNDANT CONNECTIONS IN EXISTING MANHOLES/CHAMBERS THAT ARE AFFECTED BY THE WORKS SHALL BE SEALED AND THE BENCHING MADE GOOD AS DIRECTED AND TO THE SATISFACTION OF THE HIGHWAYS INSPECTOR AND/OR UTILITY COMPANY INVOLVED.

8 ANY EXISTING LIVE DRAINS, SEWERS, DUCTS, CABLES, ETC. THAT WILL PASS UNDER THE PROPOSED HIGHWAY SHALL BE SURVEYED, PROBED, TRACED, RODDED, JETTED, CCTV'D, ETC. TO ASCERTAIN THEIR STRUCTURAL CONDITION AND SUITABILITY TO FALL WITHIN THE NEW HIGHWAY. IF DEEMED NECESSARY, SPECIAL PROTECTION AND/OR REPLACEMENT MAY BE REQUIRED AS DIRECTED AND TO THE SATISFACTION OF THE HIGHWAYS INSPECTOR, AREA ENGINEER AND/OR UTILITY COMPANY INVOLVED. ANY EXISTING LIVE MANHOLES, CHAMBERS, BOXES, ETC. THAT WILL BE LOCATED WITHIN THE PROPOSED HIGHWAY SHALL BE SURVEYED TO ASCERTAIN THEIR STRUCTURAL CONDITION AND SUITABILITY TO FALL WITHIN THE NEW HIGHWAY. IF DEEMED NECESSARY, SPECIAL PROTECTION AND/OR REPLACEMENT MAY BE REQUIRED AS DIRECTED AND TO THE SATISFACTION OF THE HIGHWAYS INSPECTOR, AREA ENGINEER AND/OR UTILITY COMPANY INVOLVED

9 DEVELOPER/CONTRACTOR TO PROVIDE SUITABLE AND EFFECTIVE WHEEL WASHING FACILITIES TO PREVENT MUD FROM BEING CONVEYED ONTO THE PUBLIC HIGHWAY AND TO PROVIDE THE MEANS TO CLEAN THE HIGHWAY TO THE SATISFACTION OF THE HIGHWAYS INSPECTOR, AREA ENGINEER AND/OR LOCAL AUTHORITY.

10 NO CONCRETE TO BE POURED OR LAID IN TEMPERATURES BELOW 2DEG C ON A FALLING MAX/MIN THERMOMETER OR BEFORE THE TEMPERATURE REACHES 2DEG C ON A RISING MAX/MIN THERMOMETER (TO BE PROVIDED BY THE CONTRACTOR AND DISPLAYED IN A POSITION AGREED BY THE HIGHWAYS INSPECTOR).

11 ALL ROAD SIGNS AND MARKINGS TO COMPLY WITH THE TRAFFIC SIGNS MANUAL.


12 ALL ROAD MARKINGS TO BE THERMOPLASTIC.

13 CONTRACTOR TO COMPLY WITH CHAPTER 8 OF THE TRAFFIC SIGNS MANUAL 2009.

14 REFER TO WSCC 278/38 HIGHWAY AGREEMENT STANDARD DETAILS DRAWINGS 01–27 AND REVISION THEREOF.

15 HIGHWAY INSPECTOR TO APPROVE ALL KERB AND/OR EDGING LINE AND LEVEL ON SITE WITH THE MAIN CONTRACTOR PRIOR TO INSTALLMENT. THE HIGHWAY INSPECTOR WILL DIRECT THE CONTRACTOR ACCORDINGLY TO ACHIEVE A SATISFACTORY FINISH WHICH MAY DEVIATE FROM THE TECHNICALLY APPROVED DETAILED DRAWINGS. THE CONTRACTOR WILL RECORD ALL VARIANCES FOR THE 'AS–BUILT' DRAWINGS ISSUE'.

16 "ALL ADOPTABLE HIGHWAY WORKS TO BE CARRIED OUT IN ACCORDANCE WITH THE DFT SPECIFICATION OF HIGHWAY WORKS OR AS AMENDED BY THE WEST SUSSEX COUNTY COUNCIL STANDARD DETAILS – BOTH AVAILABLE ON THE INTERNET."

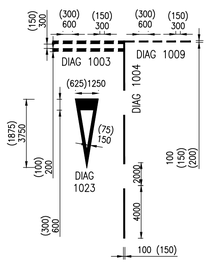

TYPICAL JUNTION GIVEWAY DETAILS
NOT TO SCALE

0 1 2 3 4 5 10 15m

AS - BUILT

rev	date	description	initials
AB1	16/09/26	REVISED TO AS-BUILT STATUS	EB

Project: ADUR CIVIC CENTRE, SHOREHAM

Client / Architect: PMC; HGP

Title: S278 & S38 AGREEMENT PLAN

REUBY & STAGG LTD.
CONSULTING CIVIL & STRUCTURAL ENGINEERS

Hampshire Office:
Dewey House, 55 High Street,
Ringwood, Hampshire BH24 1AE
Telephone: 01425 484400
Facsimile: 01425 484409
Email: admin@reuby-stagg.co.uk

date	drawn	checked	scale	size	project no.	drawing no.	revision
JAN 24	AJV	MD	1:200	A1	10721	312	AB1