This drawing is the design and copyright of Maurice Ashenden-Bax and must not be copied in part or whole without consent.

1. Do not scale off this drawing.
2. Any discrepancy in dimensions to be reported to Architect prior to carrying out the works.
3. This drawing to be read in conjunction with all engineers drawings.

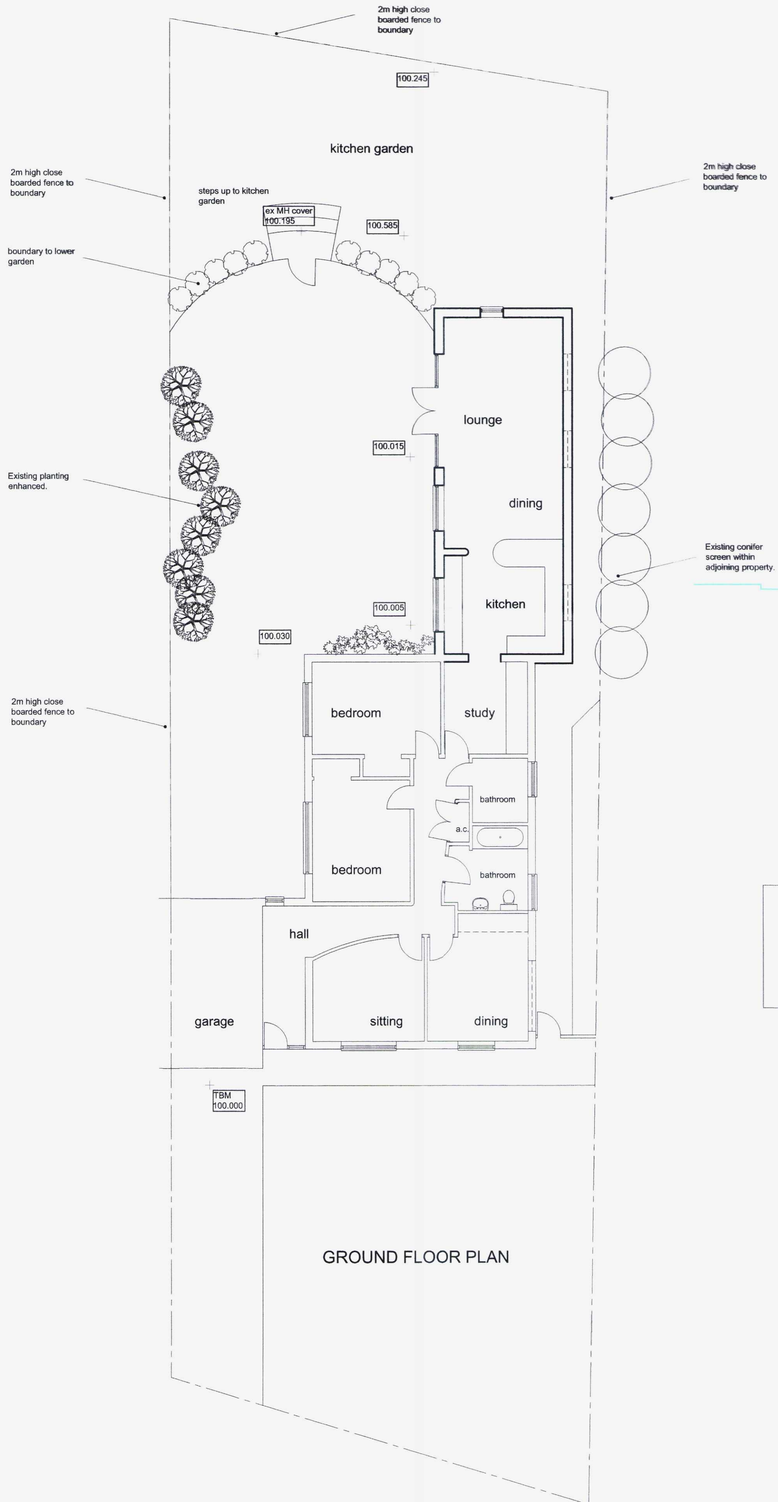

GROUND FLOOR PLAN



SOUTH ELEVATION

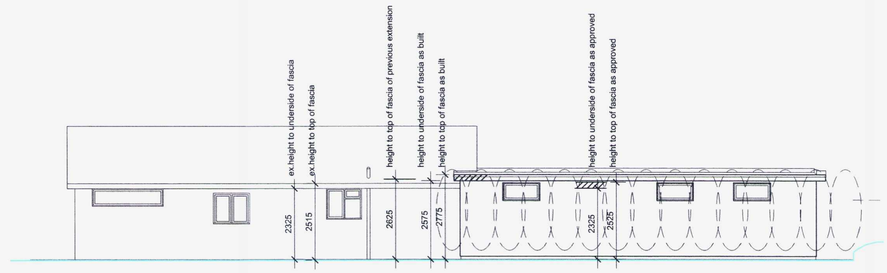

EAST ELEVATION

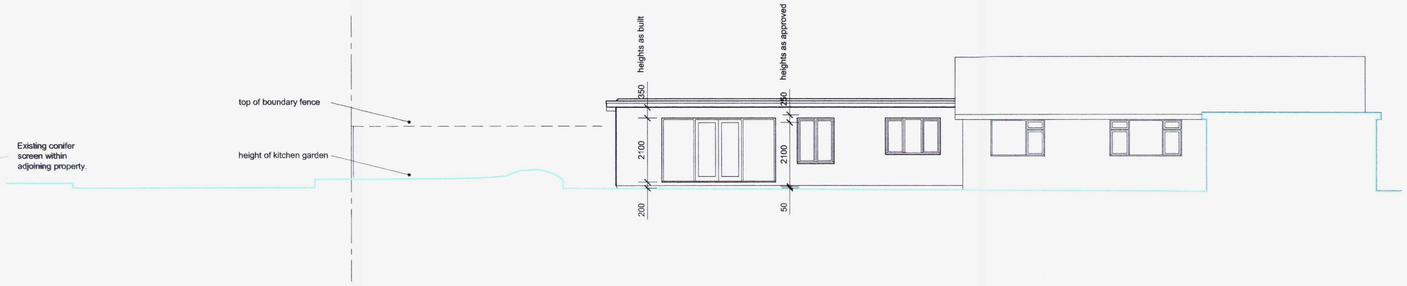

WEST ELEVATION

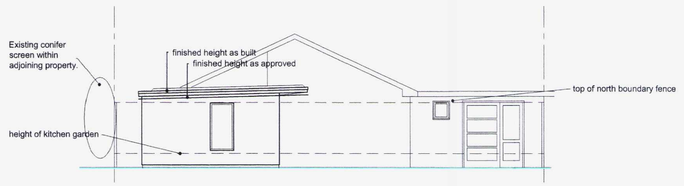

NORTH ELEVATION

EXTERNAL MATERIALS :

Roof - single ply membrane.

Walls - colour washed render.

Windows - white upvc to match existing.

Patio doors - white upvc.

B :	Ground levels added + heights as built and as approved	28.02.11
A :	Height of extension roof raised.	11.02.11

project:
Proposed Extension & Alterations
24 Cheal Close
Shoreham Beach, West Sussex

client:
Mr & Mrs R Banks

title:
Proposed Floor Plans and Elevations

date: 21.05.10

scale: 1:100

drg. no: rev: B
10.1552.11

Maurice Ashenden-Bax
Chartered Architect

CALCETTO COTTAGE, CROSSBUSH LANE
ARUNDEL, WEST SUSSEX BN18 9PQ
Tel: 01903 882988 Mobile: 07976 509831
email: ashendenbax@btinternet.com