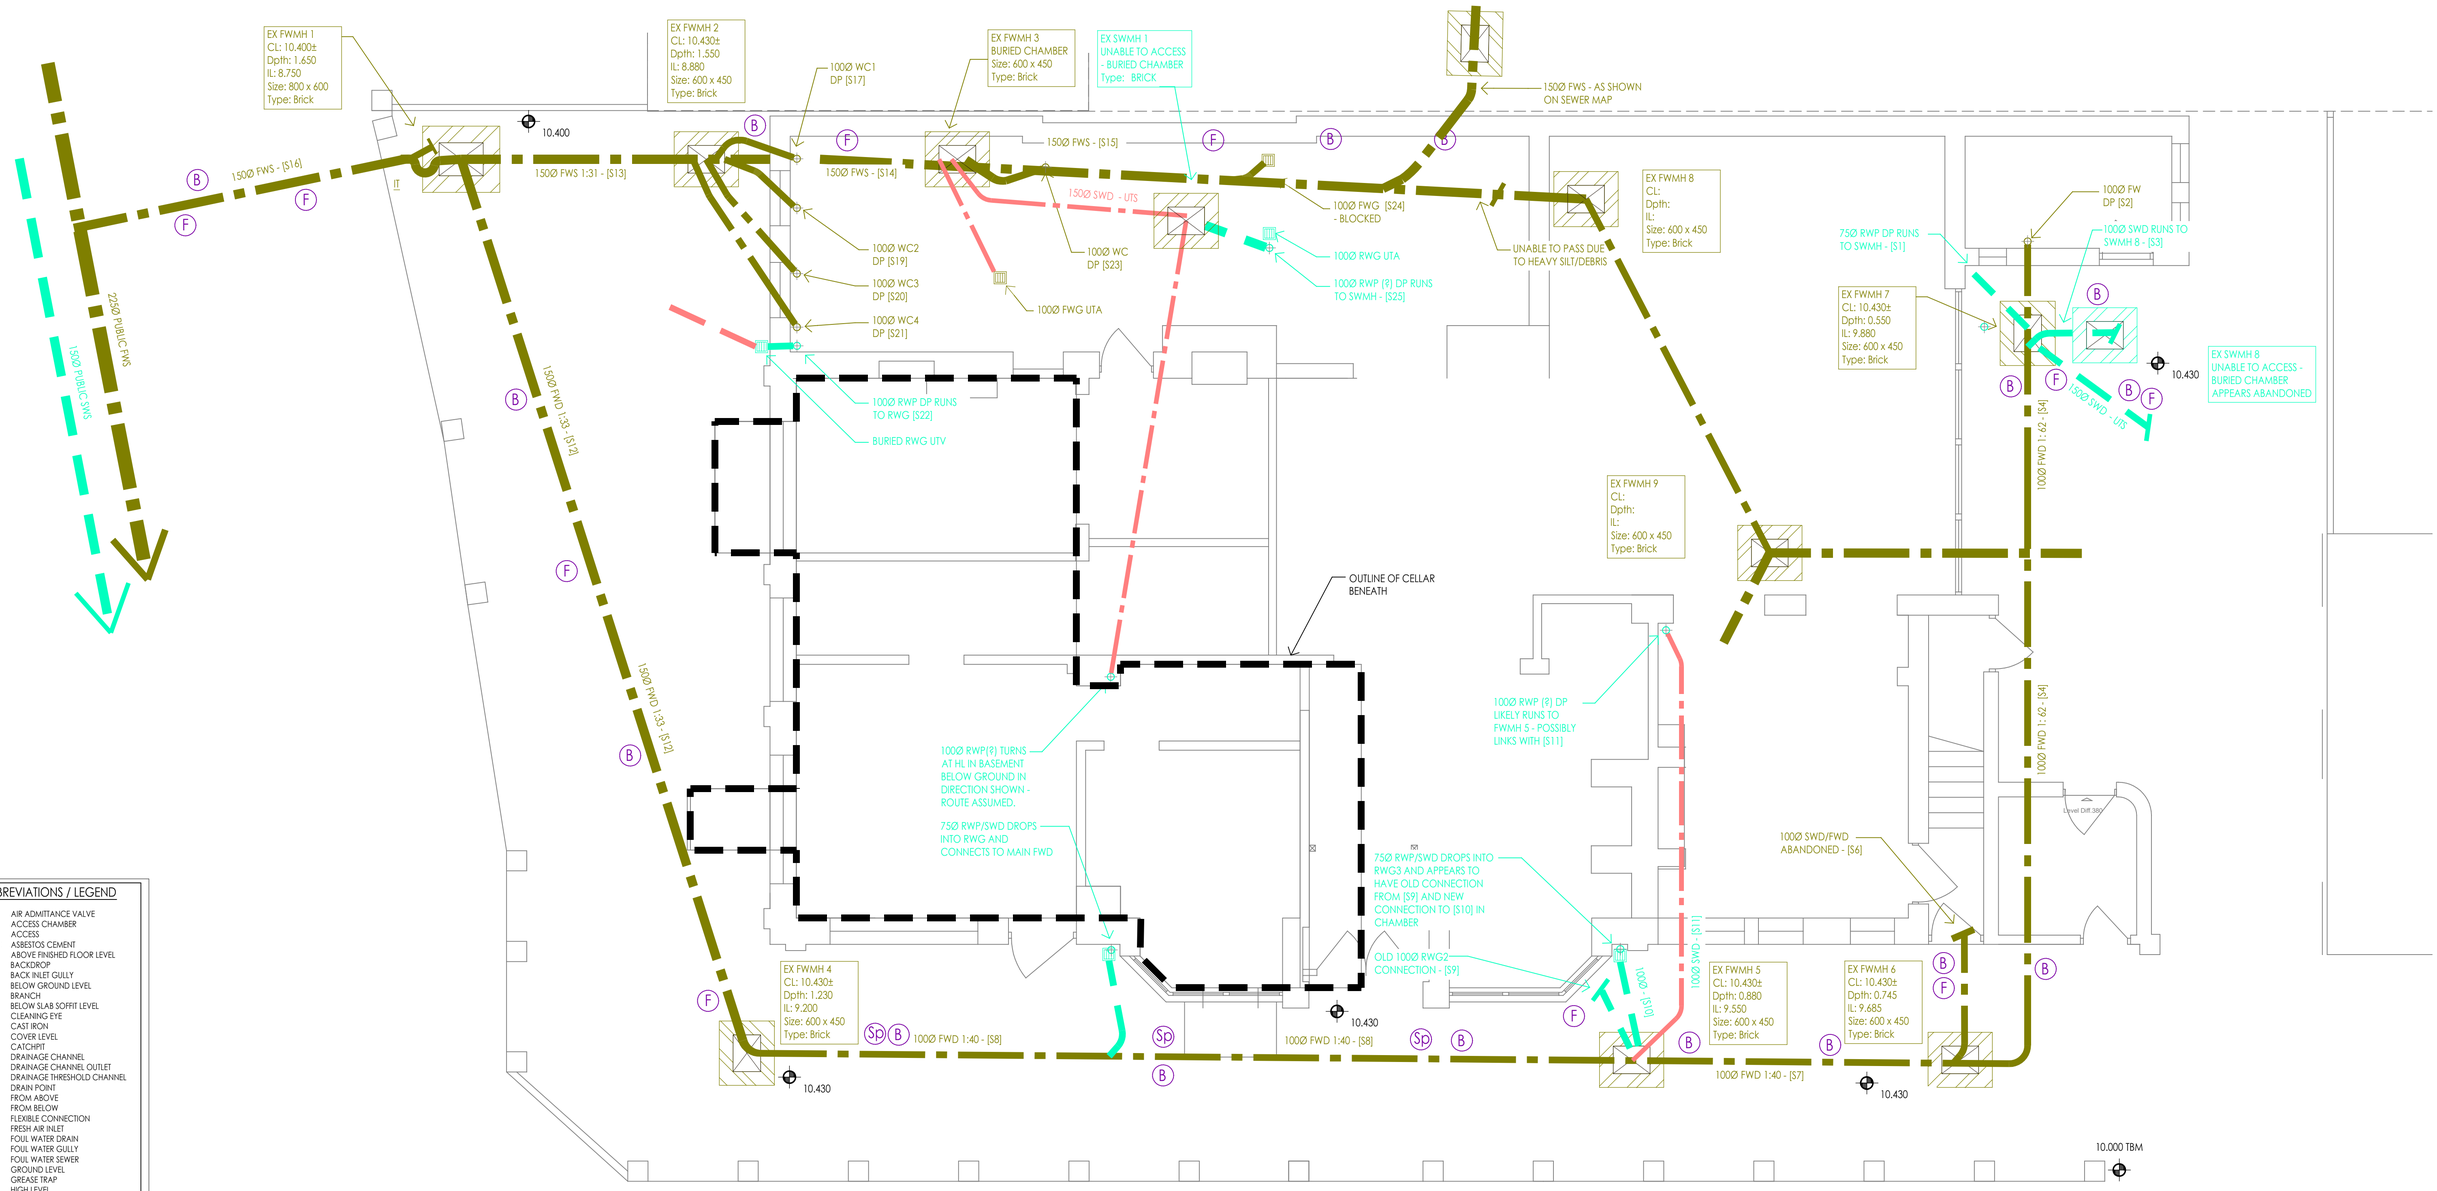

ABBREVIATIONS / LEGEND

AAV	AIR ADMITTANCE VALVE
AC	ACCESS CHAMBER
ACC	ACCESS
ASBC	ASBESTOS CEMENT
ASFL	ABOVE FINISHED FLOOR LEVEL
BD	BACKDROP
BIG	BACK INLET GULLY
BGL	BELOW GROUND LEVEL
BR	BRANCH
BSSL	BELOW SLAB SOFFIT LEVEL
CE	CLEANING EYE
CI	CAST IRON
CL	COVER LEVEL
CP	CATCHPIT
DC	DRAINAGE CHANNEL
DCO	DRAINAGE CHANNEL OUTLET
DTC	DRAINAGE THRESHOLD CHANNEL
DP	DRAIN POINT
FA	FROM ABOVE
FB	FROM BELOW
FC	FLEXIBLE CONNECTION
FAI	FRESH AIR INLET
FWD	FOUL WATER DRAIN
FWG	FOUL WATER GULLY
FWS	FOUL WATER SEWER
GL	GROUND LEVEL
GT	GREASE TRAP
HL	HIGH LEVEL
IC	INSPECTION CHAMBER
IL	INVERT LEVEL
IT	INTERCEPTING TRAP
LL	LOW LEVEL
LWG	LIGHTWELL GULLY
MH	MANHOLE
ML	MID LEVEL
OD	OVERDRAIN
OTG	OPEN TOP GULLY
PE	POLYETHYLENE
PF	PITCH FIBRE
PM	PUMP MAIN
PP	POLYPROPYLENE
PPAC	POLYPROPYLENE AC
PPIC	POLYPROPYLENE IC
PCC	PRECAST CONCRETE
PVC	POLYVINYL CHLORIDE
RE	RODDING EYE
RG	ROAD GULLY
RWP	RAINWATER PIPE
SP	SOIL PIPE
SHG	SHOWER GULLY
STBIG	SEALED TOP BACK INLET GULLY
STP	SEWAGE TREATMENT PLANT
SVP	SOIL VENT PIPE
SS	STUB STACK
SWD	STORM WATER DRAIN
SWS	STORM WATER SEWER
TA	TO ABOVE
TB	TO BELOW
TBC	TO BE CONFIRMED
TD	TO DRAIN
UB	URINAL BOWL
UD	UNDERDRAIN
UTL	UNABLE TO LIFT
UTT	UNABLE TO TRACE
UTS	UNABLE TO SURVEY
UTV	UNABLE TO VIEW
VC	VITRIFIED CLAYWARE
VTA	VENT TO ATMOSPHERE
WC	WATER CLOSET
WHB	WASH HAND BASIN
WG	WASTE GULLY
WP	WASTE PIPE
WVP	WASTE VENT PIPE
YG	YARD GULLY

EXISTING STORM WATER LEGEND / KEY

- EXISTING SWD WITH GRADIENT AND CCTV SECTION REF — 100Ø SWD - 1:60 - [S7]
- ASSUMED SWD ROUTE
- EXISTING BRICK CHAMBER - REFER EX 001 FOR SIZE
- EXISTING SWG GULLY
- DRAINAGE CHANNEL (DC)
- EXISTING RWP

EXISTING FOUL WATER LEGEND / KEY

- EXISTING FWD WITH GRADIENT AND CCTV SECTION REF — 100Ø FWD - 1:40 - [S4]
- ASSUMED FWD ROUTE
- EXISTING BRICK CHAMBER - REFER EX 001 FOR SIZE
- EXISTING FWG GULLY
- EXISTING FW DP - SVP - SS
- EXISTING INTERCEPTOR TRAP (IT)

CCTV DEFECT TAGS

- (R) TREE ROOTS
- (J) DISPLACED/OPEN JOINT
- (F) FRACTURE or CRACK
- (G) HEAVY GREASE or FOGs
- (Sp) SPALLING
- (B) BLOCKAGE or DEBRIS

This is drawing is copyright and remains in the ownership of Simon Dent Associates (SDA)

This drawing should be read in conjunction with the design team's relevant documents, drawings & details.

Existing public & private utility services and drainage locations shown have been derived from non-intrusive survey techniques. Their location is not accurate and the contractor must satisfy himself using open excavation where the location of such plant and apparatus is critical in construction.

If the contractor has constructed from this drawing without necessary approvals from Local Planning Authorities, Building Control, Sewerage Undertakers, Environment Agency etc then any abortive work shall be at his own financial risk and not the responsibility of SDA.

If the contractor has constructed from this drawing whilst the drawing remains 'PRELIMINARY status, then any abortive work shall be at his own financial risk and not the responsibility of SDA.

The contractor should NOT construct any works should there be any doubt with information shown from any of the source. ALWAYS USE GIVEN DIMENSIONS ONLY. ALWAYS ASK IF IN DOUBT.

ALWAYS PRINT THIS DRAWING IN COLOUR

EXISTING DRAINAGE NOTES

THIS DRAWING IS A RECORD OF THE BRIEF DRAINAGE SURVEY CARRIED OUT BY 'EYES ON DRAINAGE' AND SDA ON 22ND JUNE 2023.

ALTHOUGH CONSIDERED A FAIR RECORD OF THE EXISTING DRAINAGE, CRITICAL DIMENSIONS AND SETTING OUT SHOULD BE CHECKED ON SITE WITH PIPES AND BURIED SERVICES TO USE INVASIVE TECHNIQUES (EXCAVATION) TO ASCERTAIN THEIR EXACT LOCATION.

THE BUILDING / LAND SURVEY WAS CARRIED OUT BY OTHERS AND SHOULD NOT BE RELIED UPON FOR CRITICAL DIMENSIONS, WHICH SHOULD BE TAKEN ON SITE BY THE CONTRACTOR.

IN ADDITION TO THE MAIN OBSERVATIONS RECORDED FOR PIPES, ALWAYS JET CLEAN THE EXISTING SYSTEM PRIOR TO ANY WORKS BEING UNDERTAKEN.

THIS DRAWING IS TO BE READ IN CONJUNCTION WITH THE EYES ON DRAINAGE CCTV DRAINAGE SURVEY REPORT.

Rev	Description	Date	Chkd
P4	Updated to suit recent manhole and pipe discoveries.	11/10/23	SAD
P3	Updated to suit recent drainage trench and survey work	29/08/23	SAD
P2	Anomalous pipes numbered require confirmation of origin. TBM added for information.	24/07/23	SAD
P1	PRELIMINARY ISSUE	05/07/23	SAD

SIMON DENT ASSOCIATES
Civil - Infrastructure - SuDS - Flood Risk - Drainage - Rainwater - Sanitation - Public Health
Consulting Engineers
☒ Shoreham by Sea Office
☐ Gosport Office
simondent@live.co.uk
0754 658 3150

Client: Temple & Co Property Investments

Project: Southdown Inn, 38 Northcourt Road Worthing BN

Drawing title: Existing Ground floor - Below ground drainage

Drawing status: **PRELIMINARY**

Project no	Scales	Drawing no	Rev
1807	A1 - 1:50 A3 - 1:100	EX 001	P4