

N


FRONT ELEVATION

SECTIONAL ELEVATION (west)

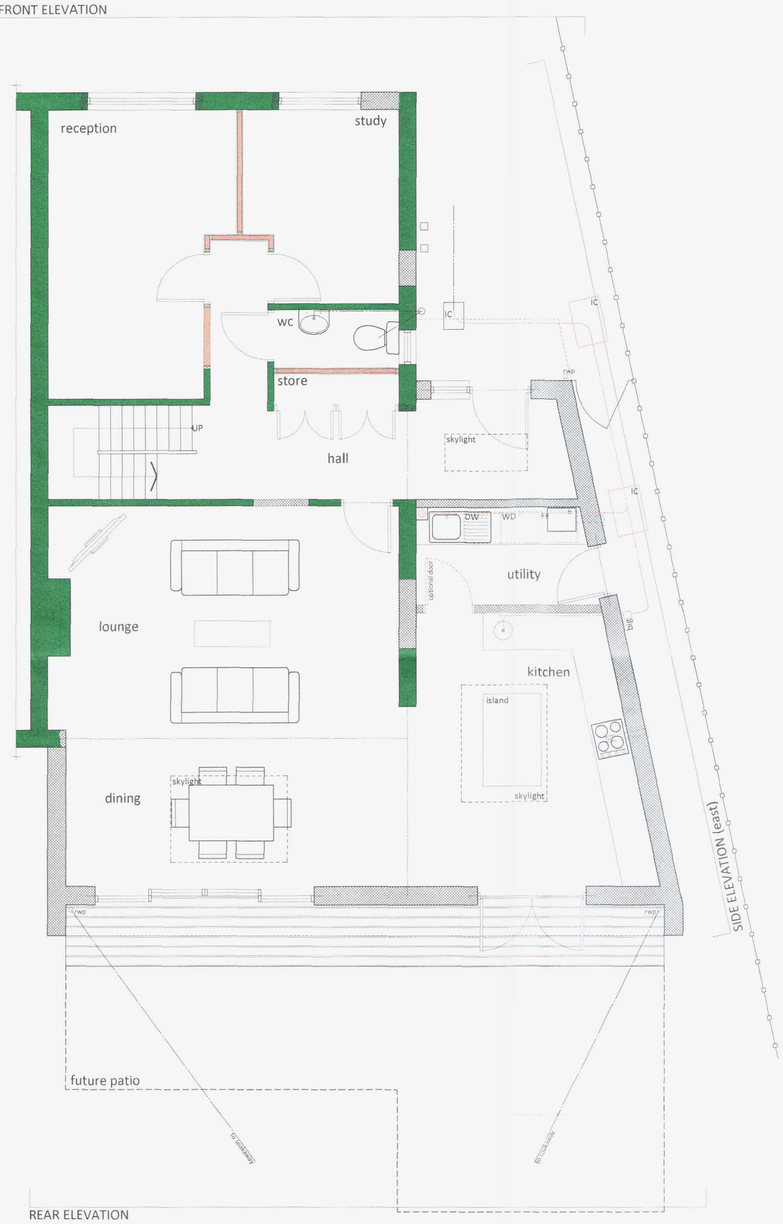

REAR ELEVATION

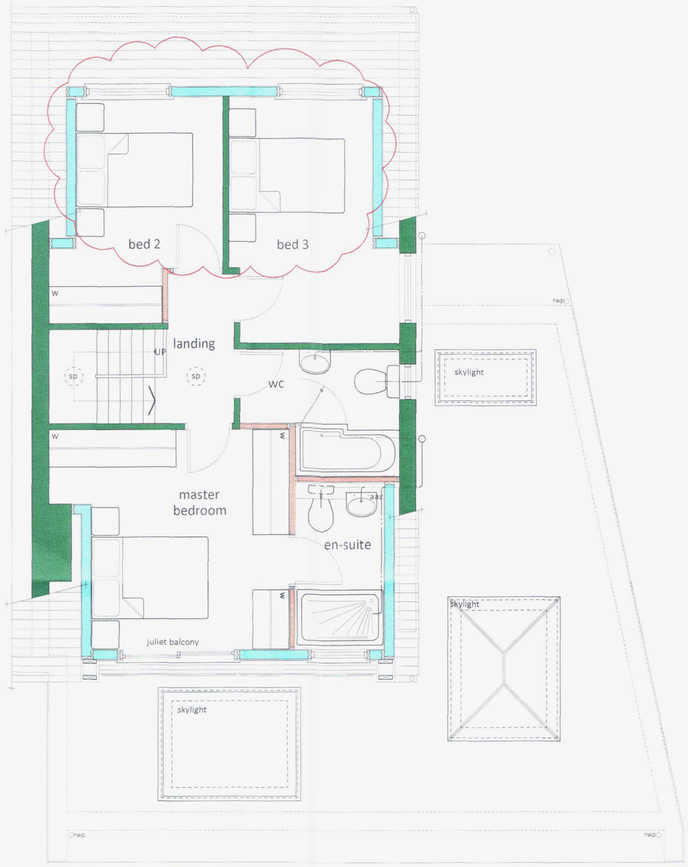

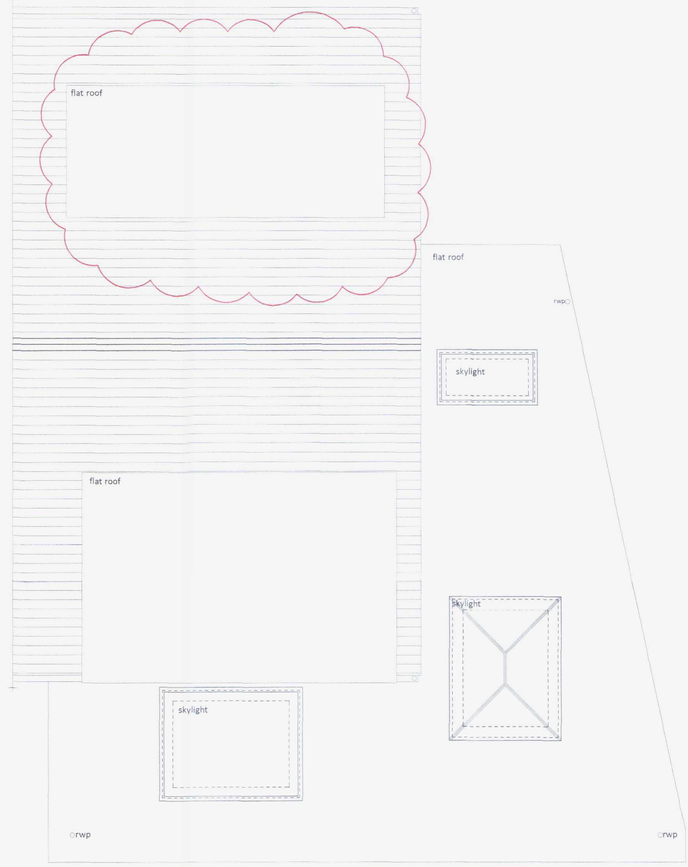

01 Ground Floor
1:50 @ A1
1:100@ A3

02 First Floor
1:50 @ A1
1:100@ A3

03 Roof Plan
1:50 @ A1
1:100@ A3

0 1 2 3 4 5
meters

NOTE:
- **DO NOT SCALE**, except for planning purposes.
- The contractor is required to check all dimensions on site before work commences.
- All goods, materials and workmanship to comply with current Building Regulations, BSS, CDP's and such other requirements as the local/statutory authorities enforcement officer may consider necessary.

© This drawing is copyright of Crowther Overton-Hart

AMENDMENT

ADUR & WORTHING PLANNING SERVICES

PLAN	AWDM/0376/15
DATE ~~VALID~~	REC'D 21.05.15

D	20.05.15 Amendments to Planning Officers comments	NB
C	15.05.15 Amendments to Planning Officers comments	NB
B	25.03.15 Roof plan added	NB
A	24.03.15 Elevation positions shown at planners request	NB

Revision

Project
Re-Modeling
51 Sompting Road
Lancing
BN15 9LB

Drawing
Proposed Ground & 1st Floor Plans

Client
Mr. & Mrs. M. Jefford

Scale
1:50 @ A1

Date	Drawn By	Checked By
Feb. '15	NB	ROH

Information	☐	Preliminary	☐
Approval	☐	Planning	■
Tender	☐	Building Regs.	☐
Construction	☐	As Built	☐

Drawing No. 448.14.10 Revision D

crowther overton-hart
28 Chanctonfold, Horsham Road
Steyning, West Sussex, BN44 3AA
T 01903 816290 F 01903 814163
E reception@cohsurveyors.co.uk

RICS