

AS-INSTALLED FRONT ELEVATION

Scale 1:50

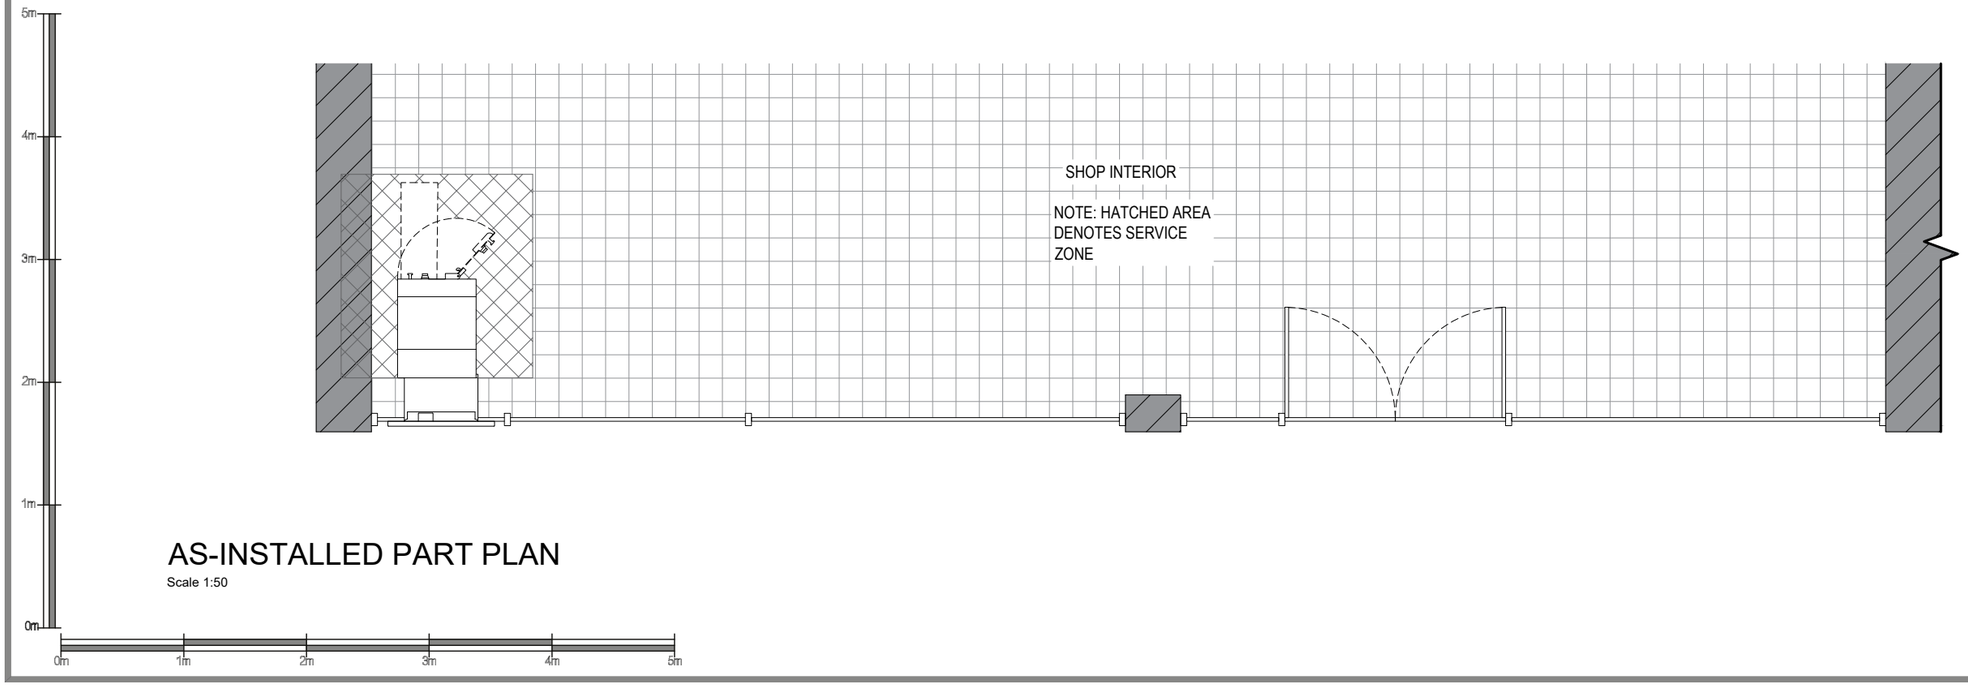

AS-INSTALLED PART PLAN

Scale 1:50

NM GROUP

Date:	Comments:	By:

GENERAL NOTES:

1) All dimensions in millimeters unless otherwise stated.

Site:
Mulberrys - South Lancing Juliet Foods Ltd, 40-48 [illegible] South Street,
Lancing,
BN15 8AG

Drawing Title:
As-Installed Plan and Elevation

Ref: A - T019216 [illegible]	Date: 09/07/2019	Rev:
Scale: 1:50	Paper: A3	Date Rev: