


Original elevations
Scale 1:100

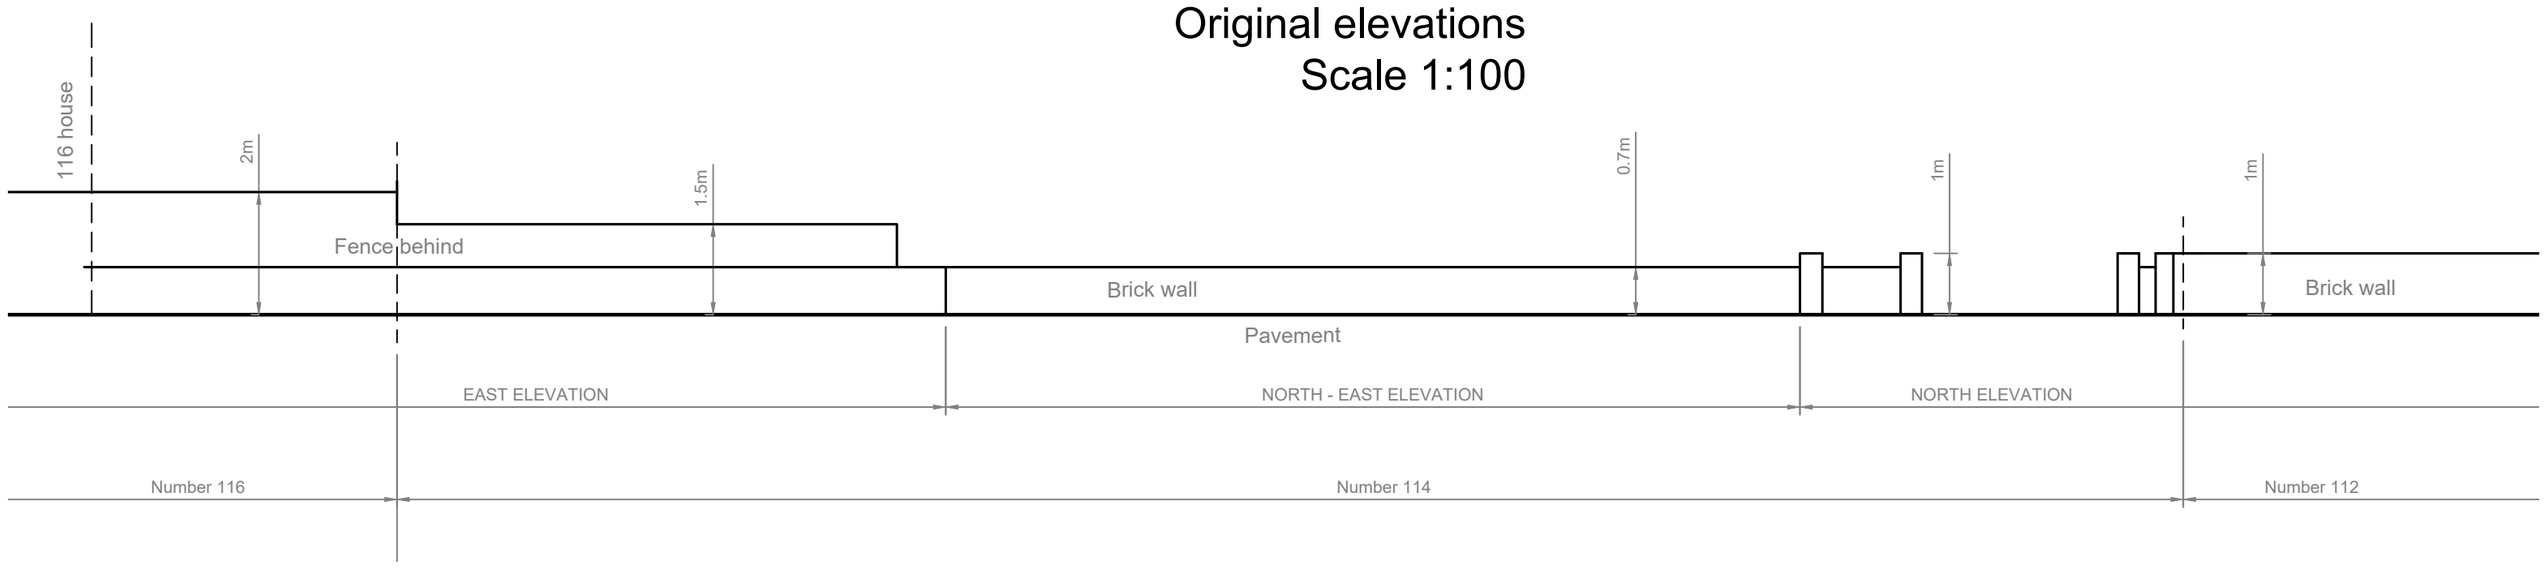

As built elevations
Scale 1:100

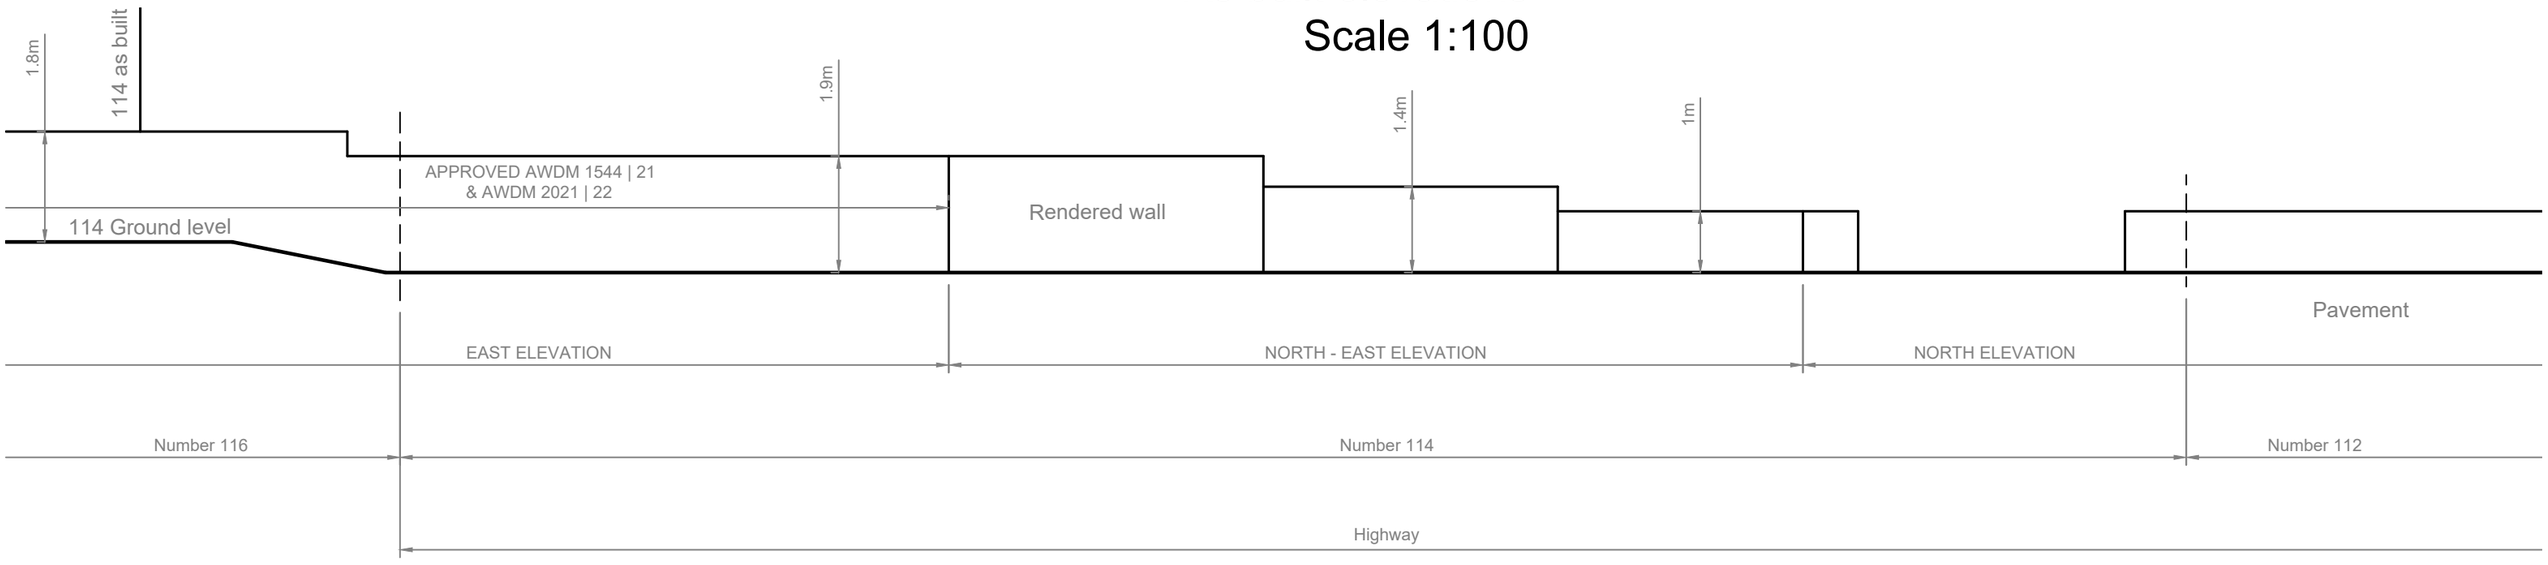

Stopping Sight Distance (SSD) PRIVATE ACCESS
Scale 1:200

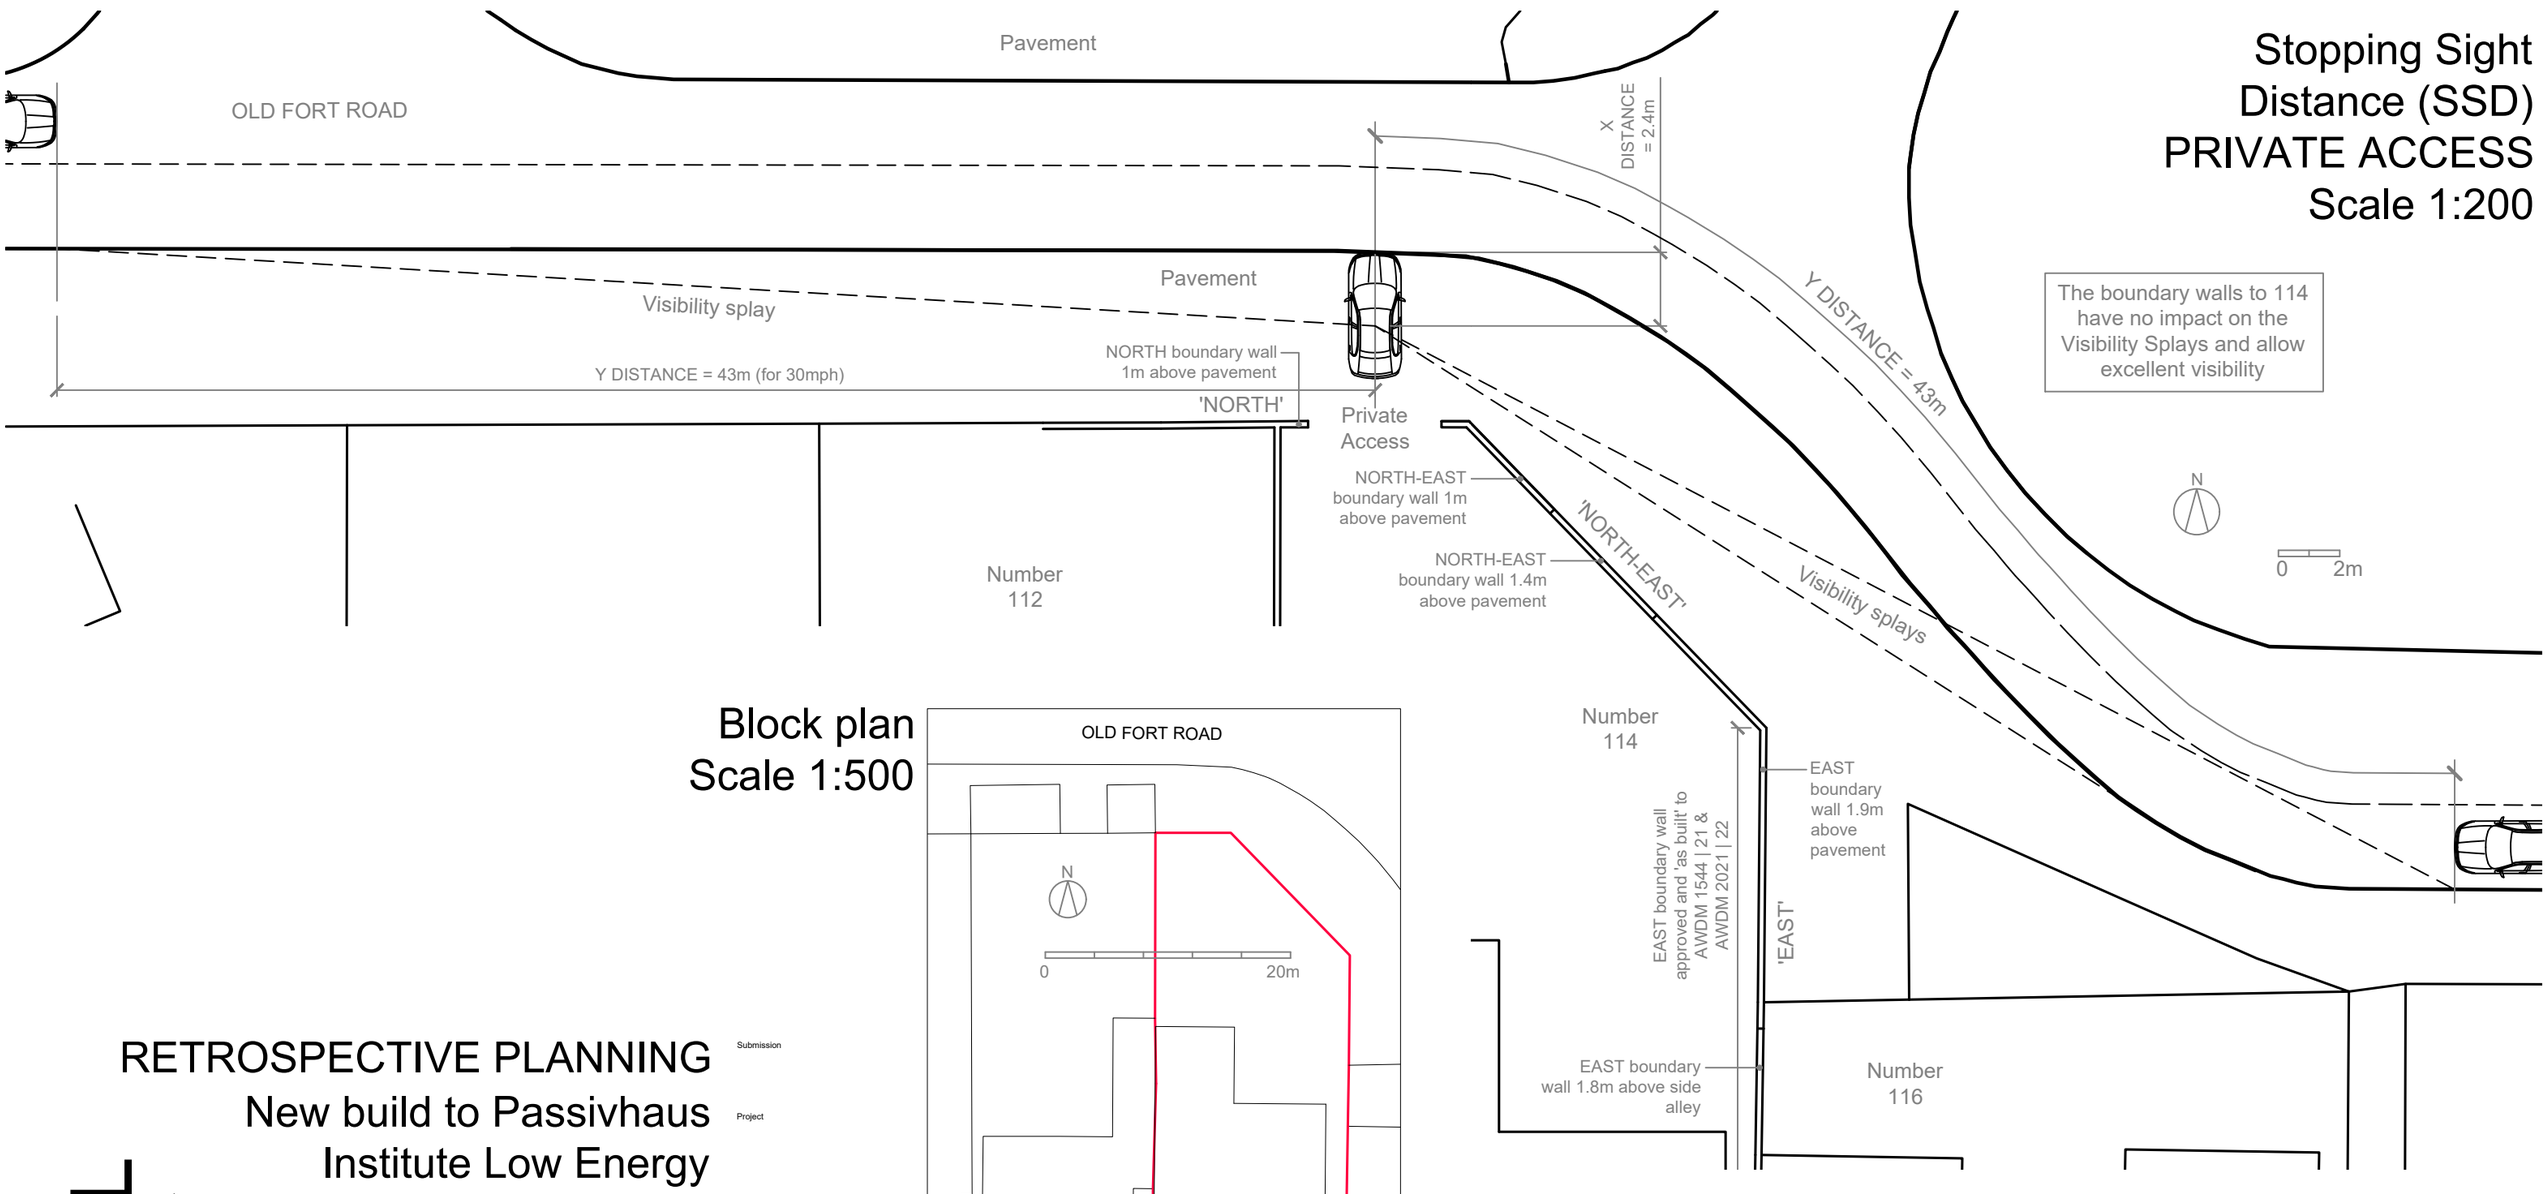

Block plan
Scale 1:500

RETROSPECTIVE PLANNING

Submission

New build to Passivhaus Institute Low Energy Building criteria

Project

SUBMISSION

Use

Chris Jessop

Client

114 Old Fort Road
Shoreham-by-Sea BN43 5HB

Address

1:100, 1:200, 1:500 & 1:1250 @ A2

Scale

Submission 03.04.2025
Revision A 11.04.2025

Date/Rev

8303.76

Drawing

Plans should be approved by local authority building control prior to commencement of work.
No dimensions to be scaled from drawing.
All dimensions to be checked on site.
All dimensions in mm unless stated otherwise


Notes

This drawing is copyright.

JMD

Jim Miller Design Ltd
01273 233548
jim@jimmillerdesign.co.uk
www.jimmmillerdesign.co.uk
92 Livingstone Road, Hove BN3 3WL

BOUNDARY WALL ON TO HIGHWAY

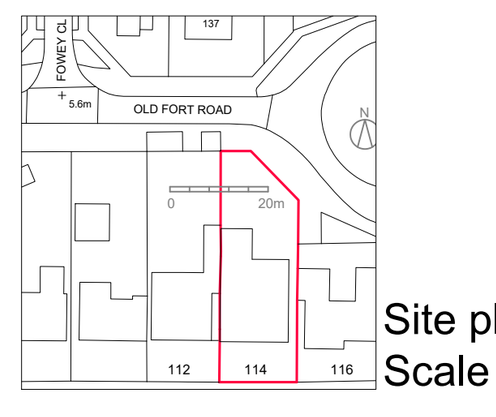

Site plan
Scale 1:1250

Pedestrian Visibility Splays PRIVATE ACCESS
Scale 1:100

