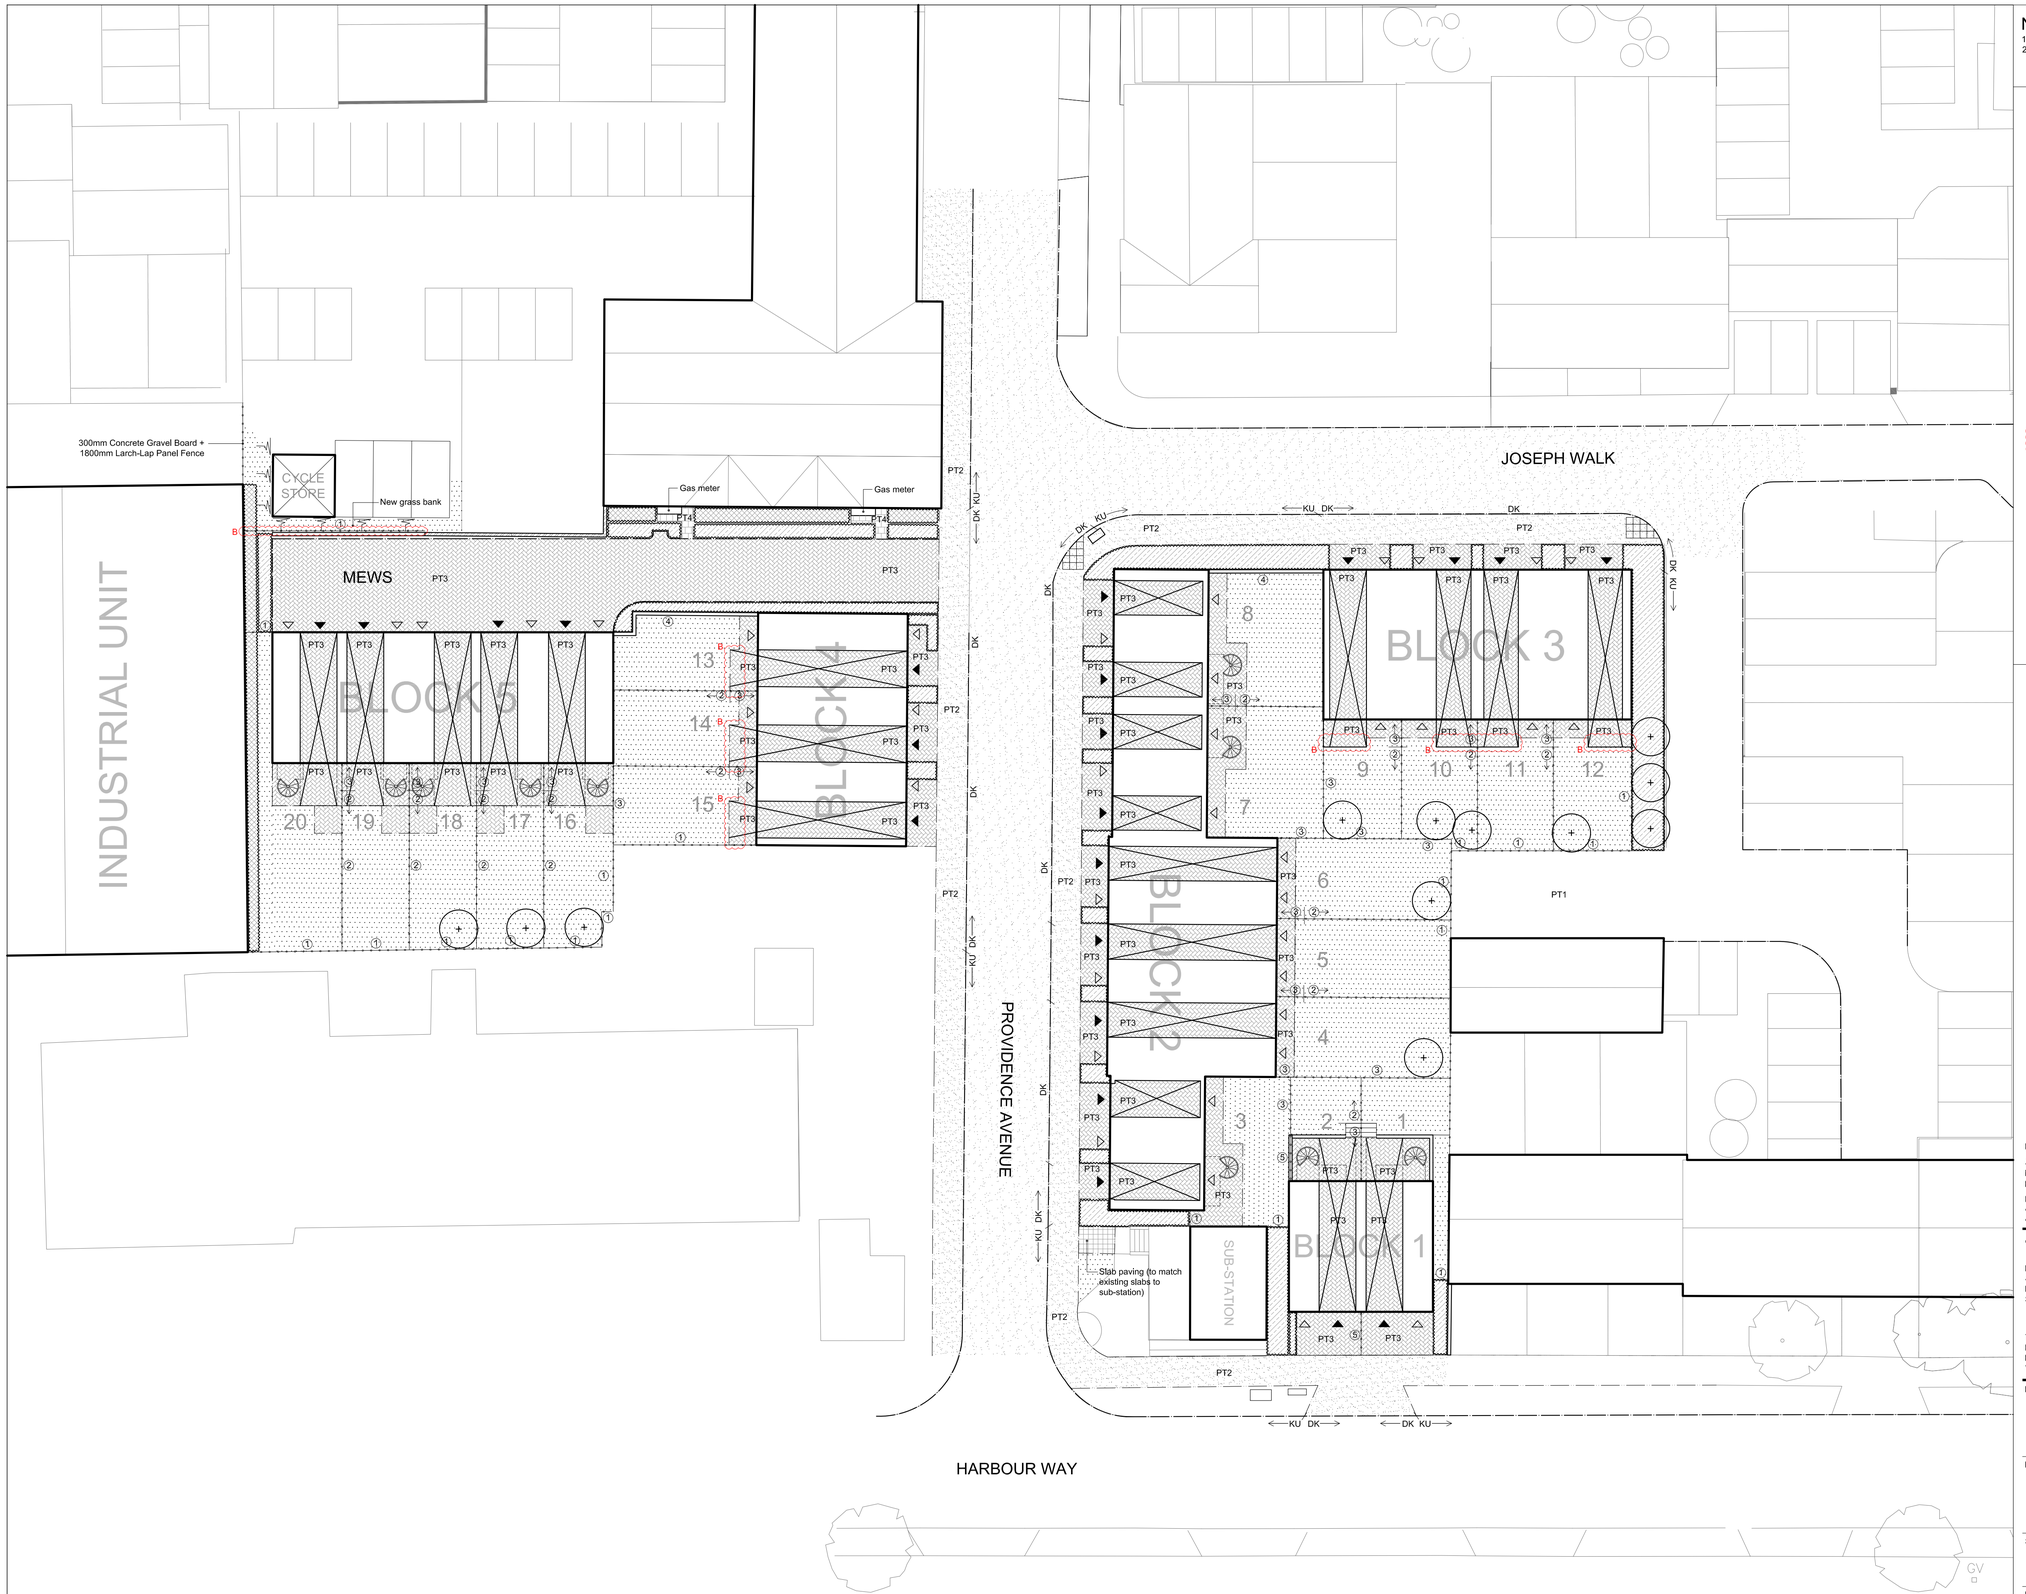


Notes

1. This drawing is the property of fabrik ltd. It must not be copied or reproduced without written consent.
2. Only figured dimensions are to be taken from this drawing. All contractors must visit site and be responsible for taking and checking all dimensions related to the works shown on the drawing.

LEGEND

- PT1 — Vehicular Tarmac (Black)
- PT2 — Pedestrian Tarmac (Black)
- PT3 — Permeable Block Paving, Marshalls 'Priora' (Brindle - TBC)
- PT4 — PCC Slab Paving, Marshalls 'Standard Pimple' (Natural)
- PCC Tactile Slab Paving, Marshalls 'Blister Tactile' (Natural)
- KU — Road Kerb Upstand (see engineer's detail)
- DK — Dropped Kerb (see engineer's detail)
- Pin Kerb (PCC Flat top Edging)
- 1 — 1800mm Close Board Fence
- 2 — 900mm Two-Strand Post & Wire Fence
- 3 — 1800mm Larch-Lap Fence
- 4 — 1800mm Brick Wall
- 5 — 600mm Brick Wall with 1200mm Larch-Lap Panel (B)
- Gate (to match adjacent fence type)
- Proposed Shrub Planting
- Proposed Hedge Planting
- Proposed Tree / Specimen Shrub
- Proposed Lawn (optional extra)
- Vehicular Entrance Point
- Pedestrian Entrance Point

m 0 2 4 6 8 10 12 14 16 18 20
Scale 1:200

north

No.	Date	Reason	Name
B.	28/07/11	Clouded changes as per client comments.	MYF
A.	01/07/11	Clouded changes as per client comments.	MYF

Revisions

External References:

- -
- -

fabrik
First Floor
4-8 Emerson Street
London
SE1 9DU

T : 0207 620 1453
F : 0207 261 9126
E : london@fabrikuk.com
W : www.fabrikuk.com

Taylor Wimpey

Project

Phase 3 Harbour Way, Shoreham

Drawing

Hard & Soft Landscape - General Arrangement

Scale	Date	Drawn
1:200 @ A1	March '11	MYF

Drawing No.	Revision
D1923 L.101	B

- [ ] Preliminary
- [ ] Issued for Planning Approval
- [x] Issued for Construction (B)
- [ ] Issued for Design/Information
- [ ] Issued for Tender
- [ ] As Built

Drawing sheet size - A1

Copyright Reserved ©