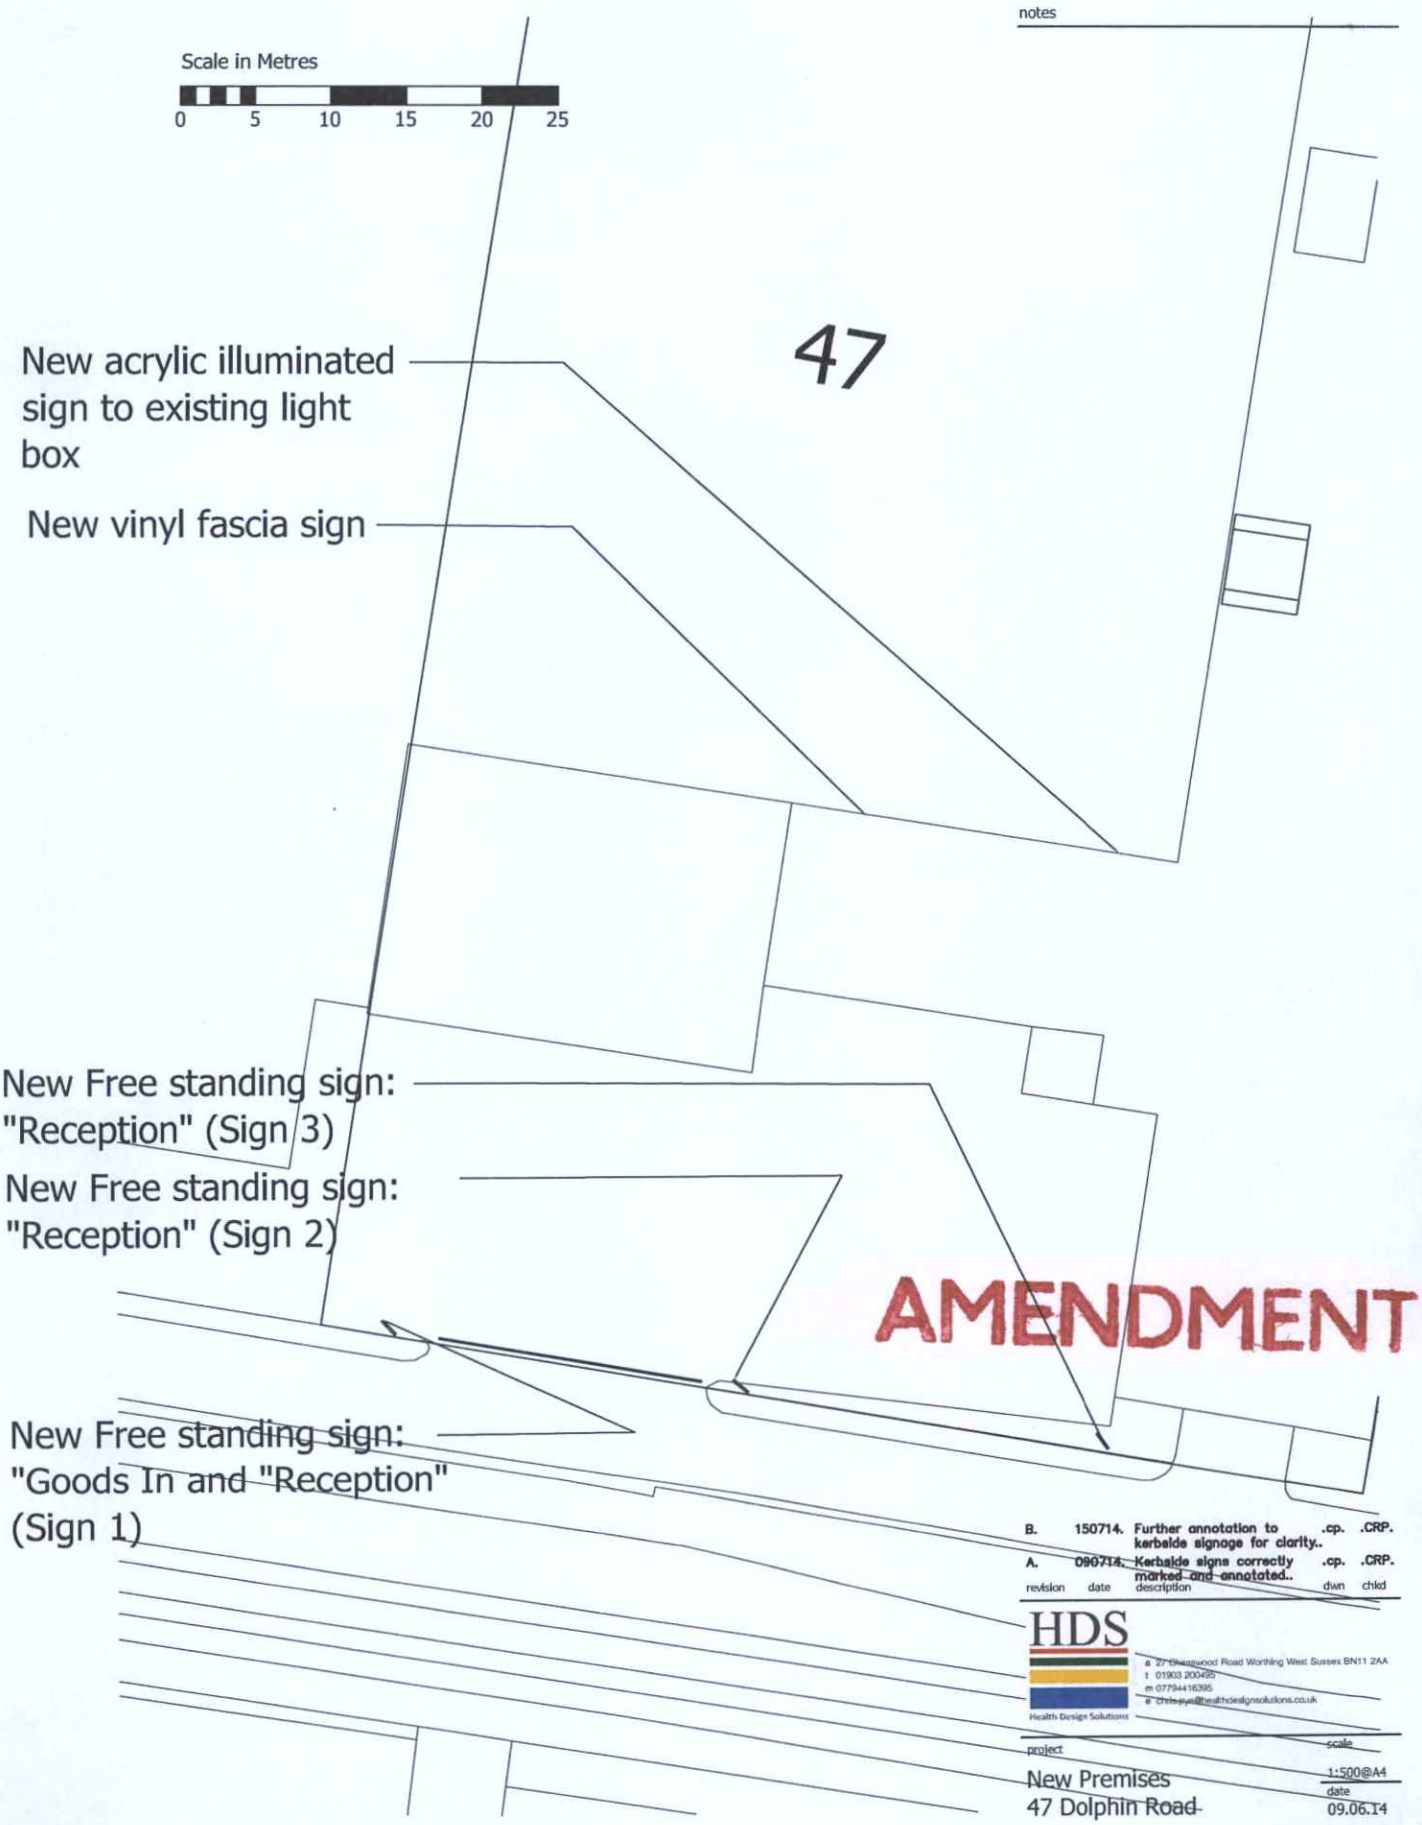

AMENDMENT

Signs 1-3 refer to drawing ~~no.~~ D14 002 L(00) 108

revision	date	description	dwn	chkd
B.	150714.	Further annotation to kerbside signage for clarity..	.cp.	.CRP.
A.	090714.	Kerbside signs correctly marked and annotated..	.cp.	.CRP.

HDS
Health Design Solutions
a 27 Chesswood Road Worthing West Sussex BN11 2AA
t 01903 200495
m 07794416395
e chris.pye@healthdesignsolutions.co.uk

project
New Premises
47 Dolphin Road

scale 1:500@A4
date 09.06.14
drawn crp
checked CP

client
VW Heritage

drawing
Site Plan- Planning Application

drawing number D14 002 L(00) 101
revision B

DO NOT SCALE FROM THIS DRAWING. THIS DRAWING IS COPYRIGHT ©

ADUR & WORTHING
PLANNING SERVICES
PLAN AWDM/ 0820/14
DATE ~~VALID~~ REC'D 15/07/14.