

ttens finished
5mm T-Break
vith foil taped
and 12.5mm
ard and skim

see construction
notes for build up

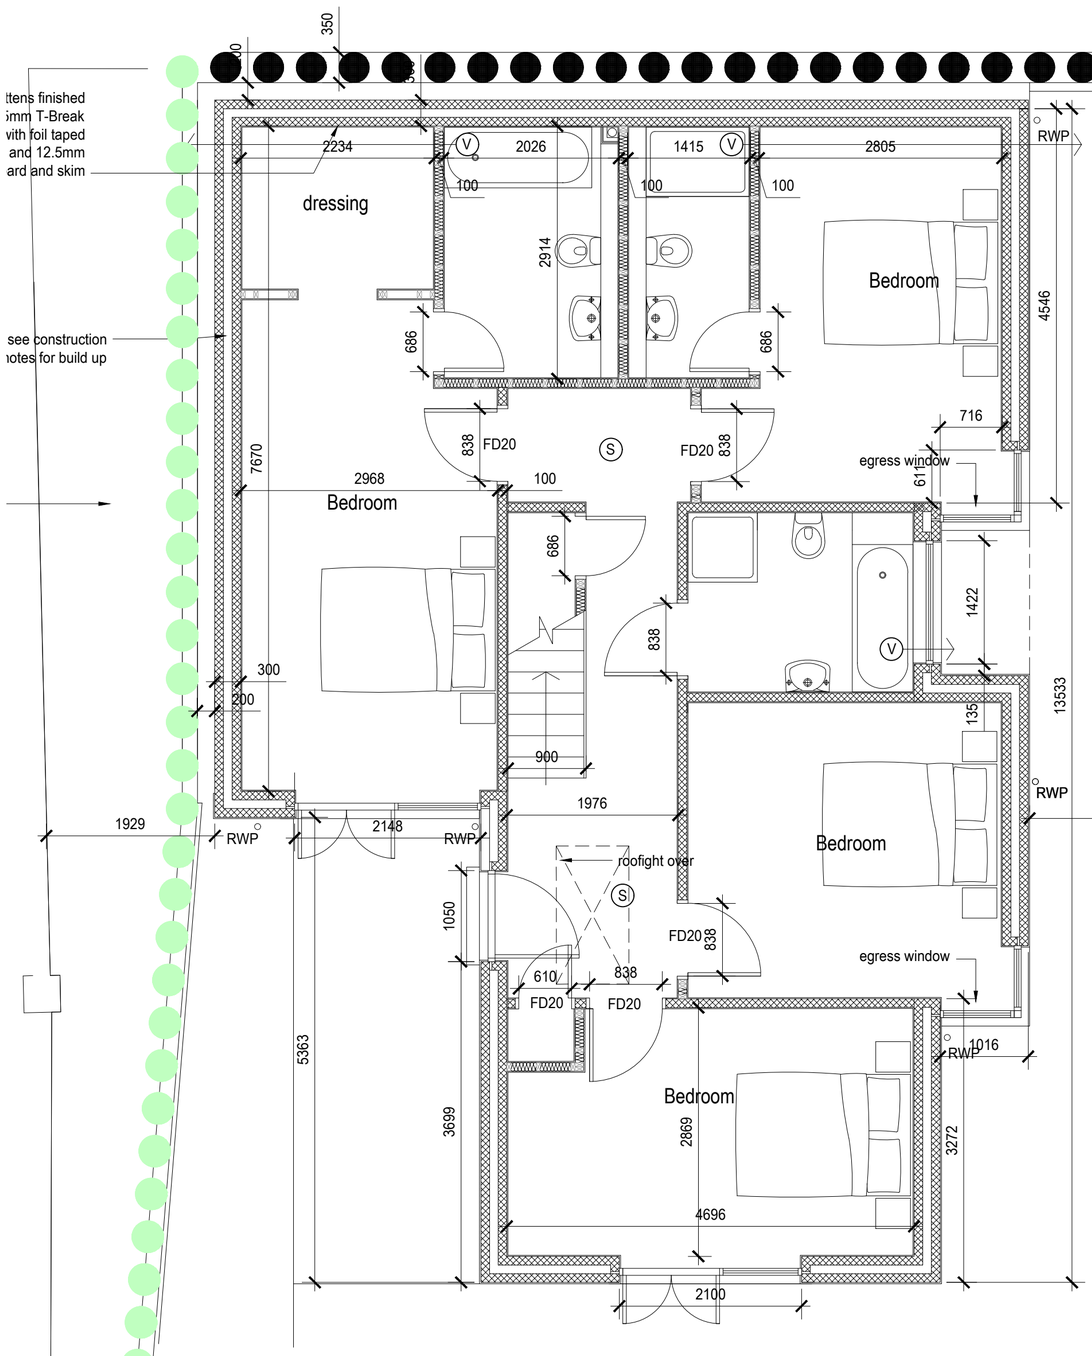


Ground Floor Plan House 1 1:50

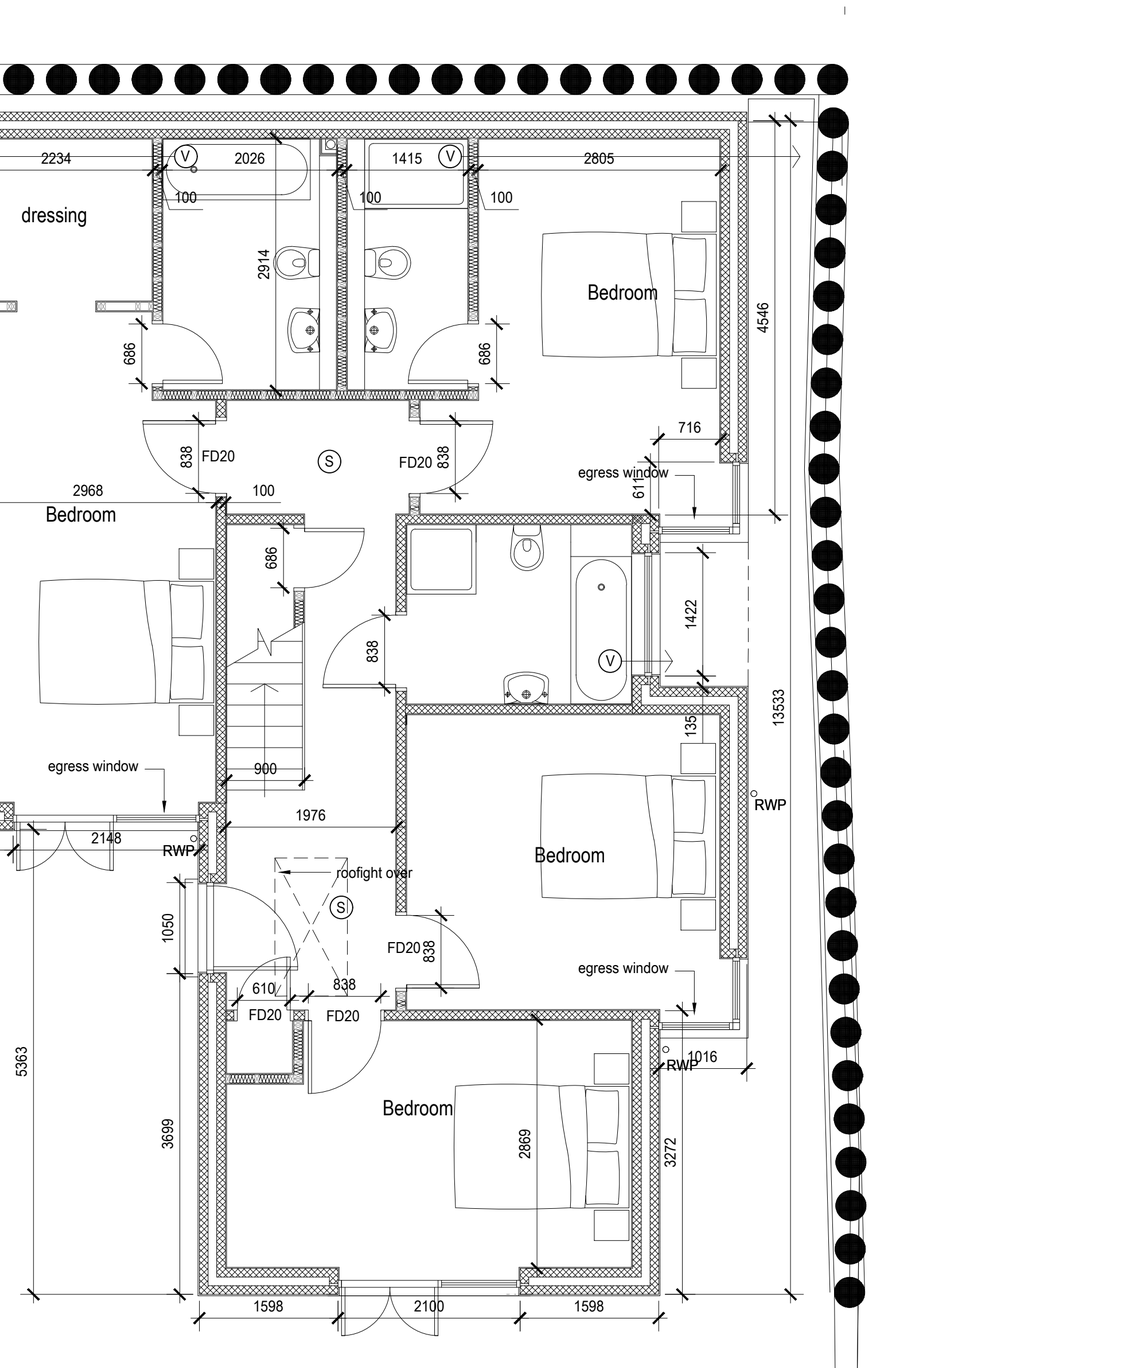

Ground Floor Plan House 2 1:50

2576*

see planning conditions drawing for boundary treatments

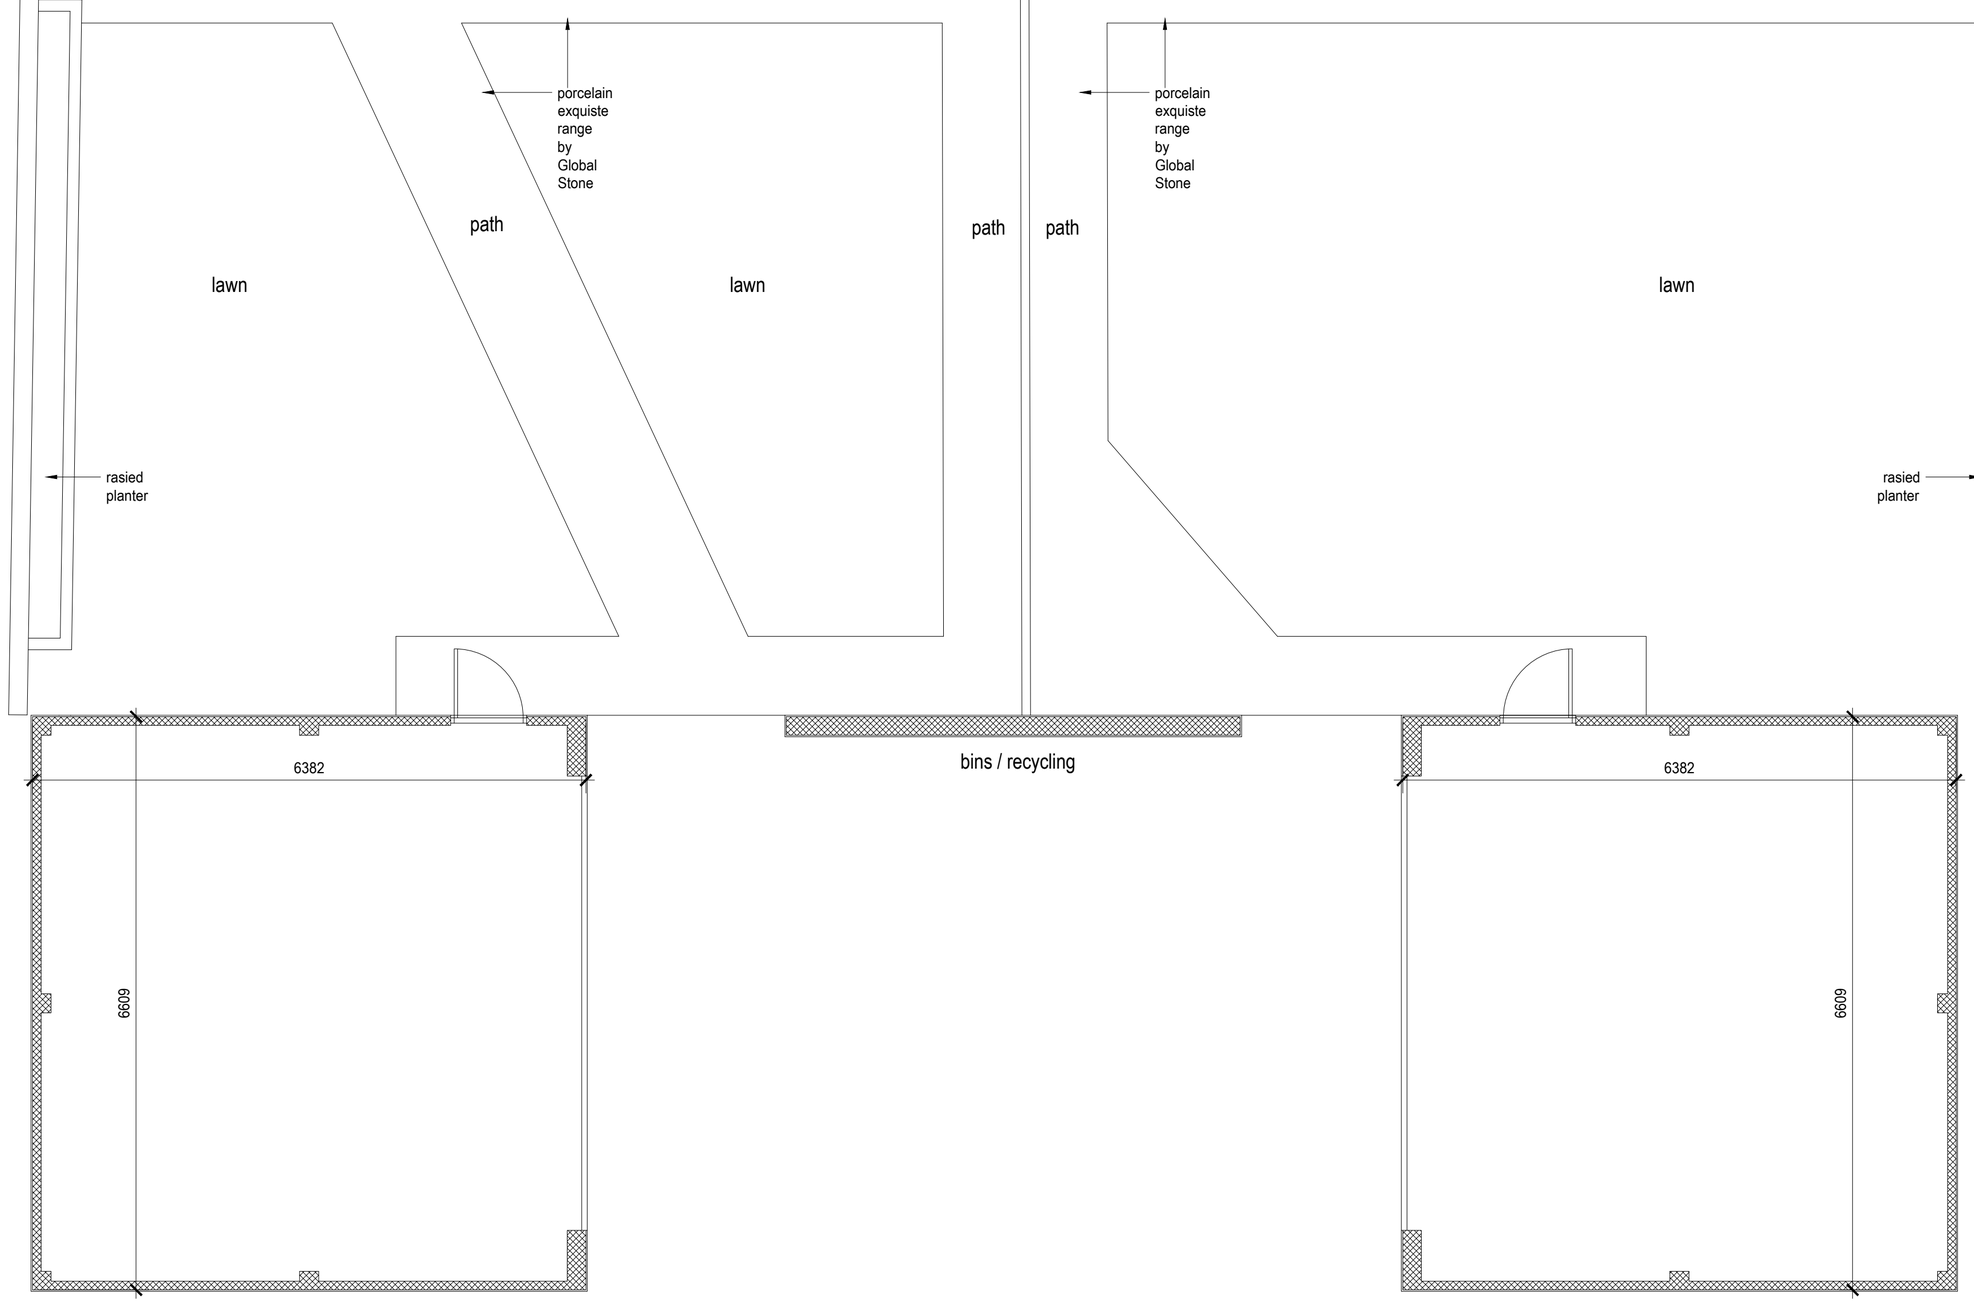

Rev E 01.08.20 AS BUILT amendments

bpm Architectural Services Limited

client
111a Arundel Road Development LLP

project
Land South of 14 Ring road
Norbury Drive
Lancing
West Sussex

project ref: 1515

Drawing No. BR01E

drawing title
Proposed ground Floor Plans

drawn by
J Boys

date
Jan 17

scale
1:50@ A1

www.bpmnet.co.uk
info@bpmnet.co.uk

Do not scale off drawing, check all dimensions on site before all work is commenced

All goods materials workmanship to conform with current building regs BSS and COP's