510800

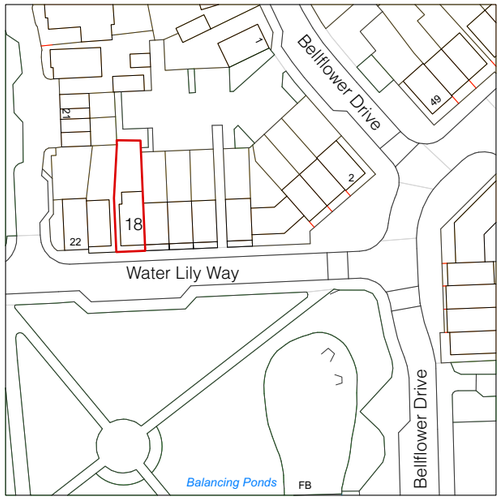

105200

105200

510800

20 0 20 40 60 80 100

Metres

N

Production Date: 05 June 2023
Ordnance Survey OS100035409.
Scale 1:1250

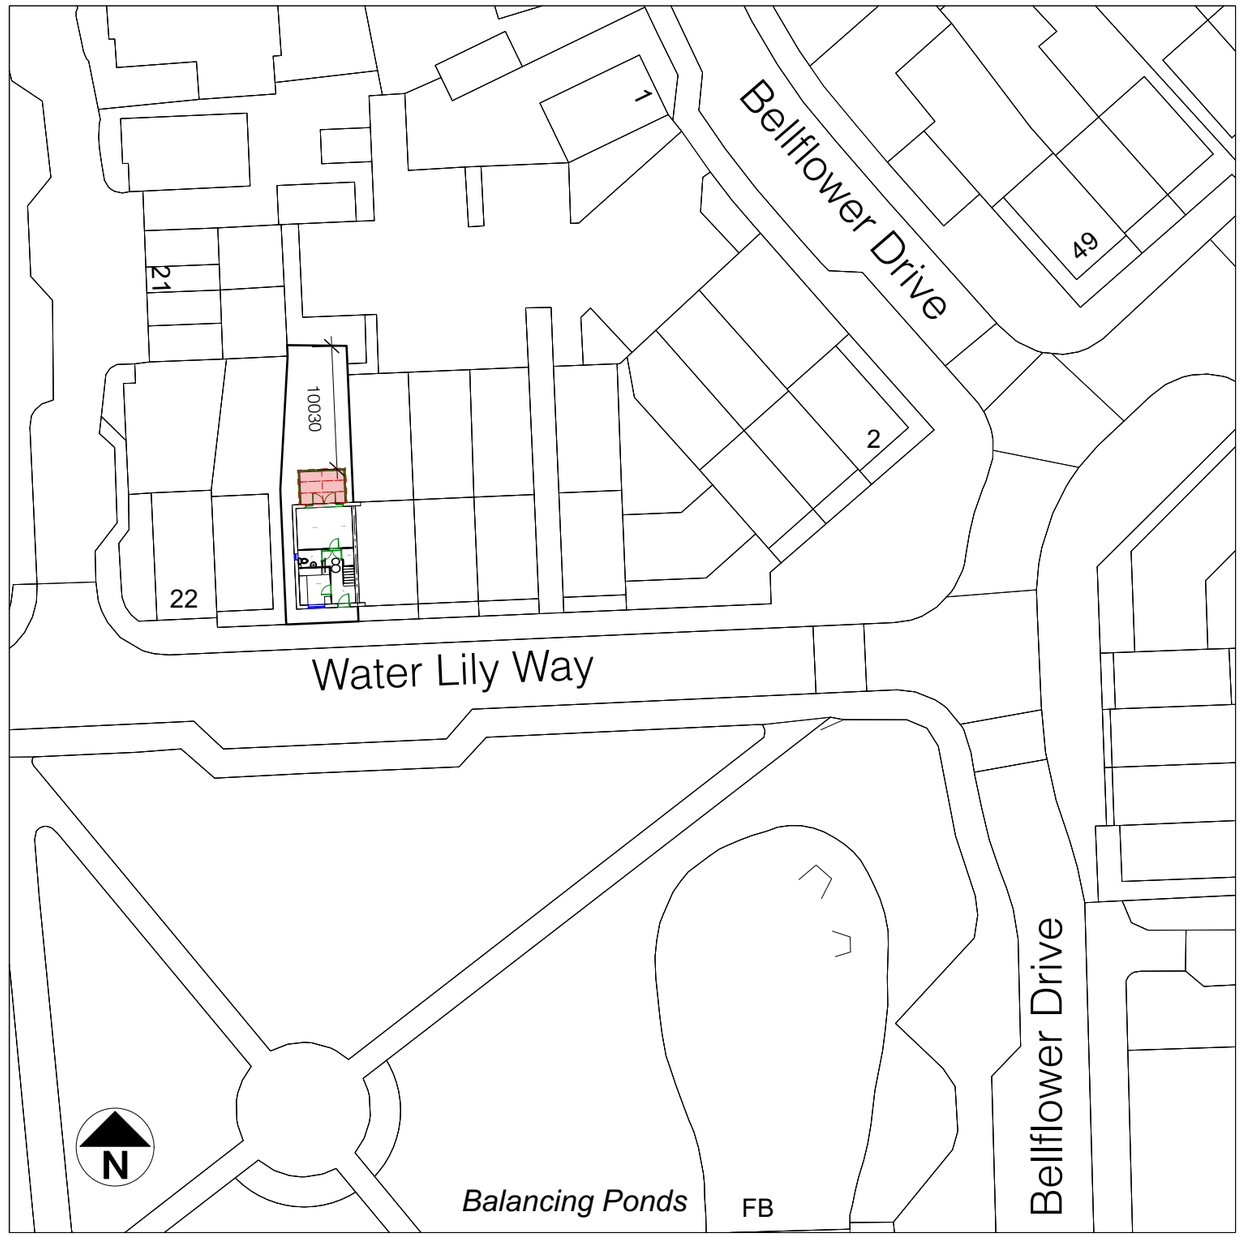

000 5.0 10.0 15.0 20.0 25.0 M

SCALE 1:500

Sheet No. CLD 0623/653/01

Scales:
AS NOTED @A3

Notes:

Project Name:
Certificate of Lawful Developement (Existing) Conservatory to North Elevation

Date: 05/06/2023

Client:
Beaumont

Site Address:
18 Water Lily Way
Durrington
BN13 3GR

PB PROPERTIES
the design to build on

Paul Maggs MCIAT

Hazelwood, Harbolets Road,
West Chltington RH20 2LG

Tel: 01798 813298

paul@pbproperties.co.uk
www.pbproperties.co.uk

Drawings produced using Vectorworks CAD. Only written dimensions to be respected. Copyright protected to PB Properties

CIAT
CHARTERED PRACTICE

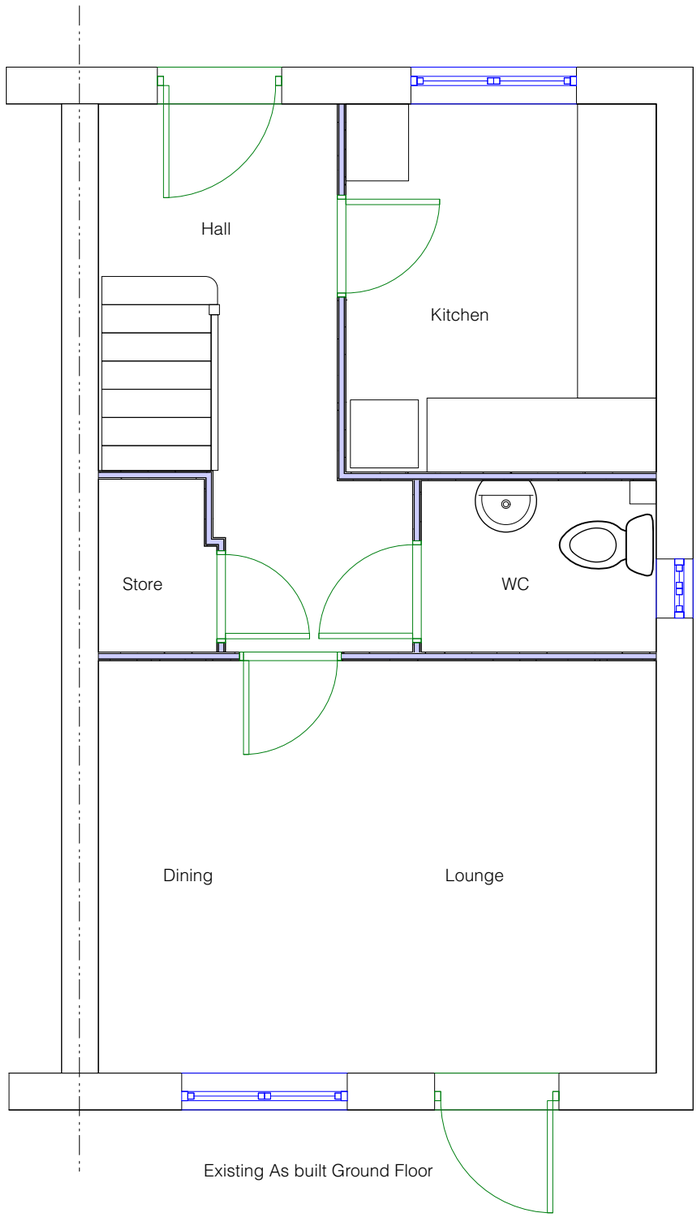

Existing As built Ground Floor

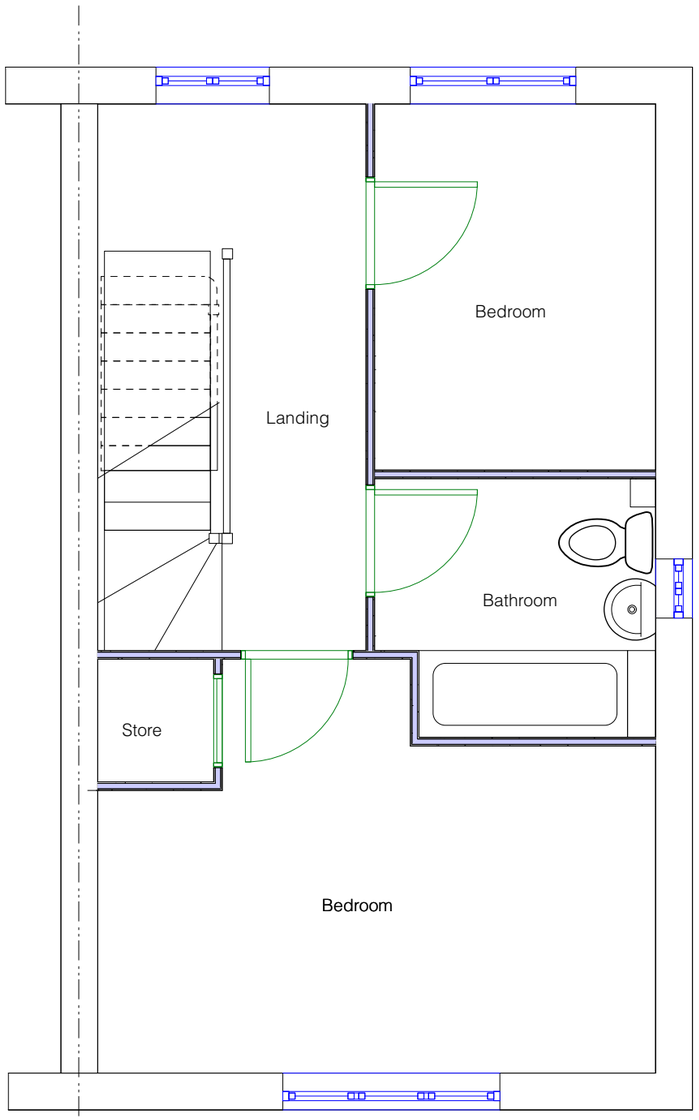

Existing First floor Unchanged

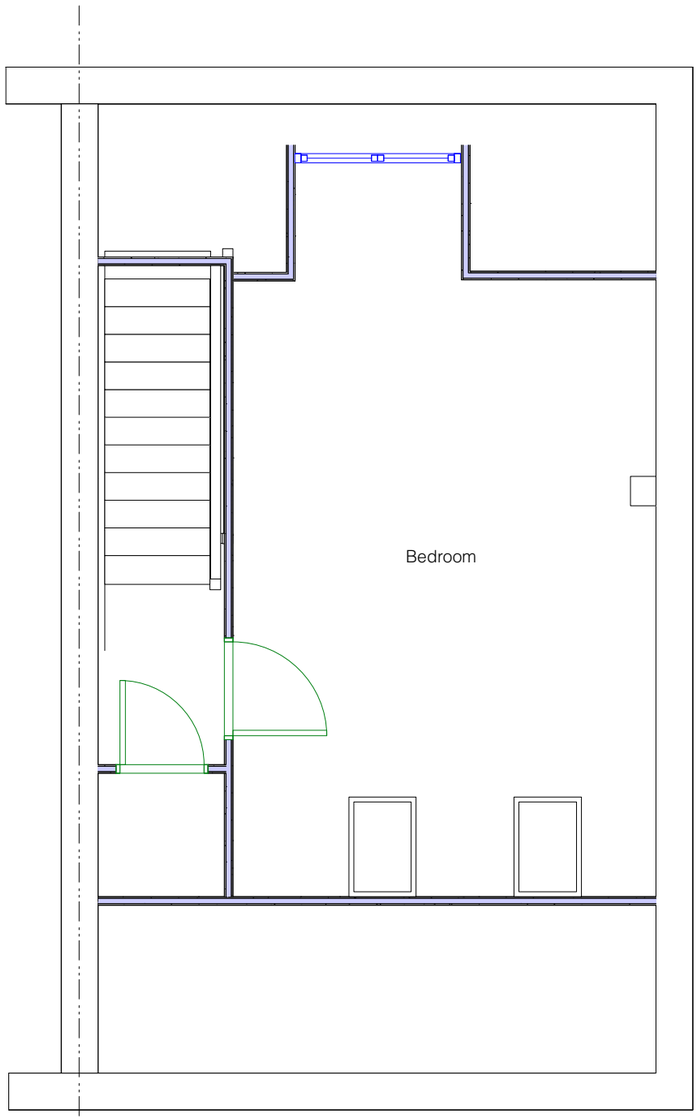

Existing Second floor Unchanged

EXISTING FLOOR PLANS AS BUILT AWDM/0721/16

0 1.0 2.0 3.0 4.0 5.0 M

PB PROPERTIES
the design to build on
CIAT CHARTERED PRACTICE

Paul Maggs MCIAT
Hazelwood, Harbolets Road,
West Chltington RH20 2LG
Tel: 01798 813298
paul@pbproperties.co.uk
www.pbproperties.co.uk

Client: Beaumont

Site Address:
18 Water Lily Way
Durrington
BN13 3GR

Project Name:
Certificate of Lawful Developement
(Existing) Conservatory to North Elevation

Date: 05/06/2023

Scales: 1:50 @A3

Plan No. CLD 0623/653/02

Drawings produced using Vectorworks CAD. Only written dimensions to be respected.
Copyright protected to PB Properties

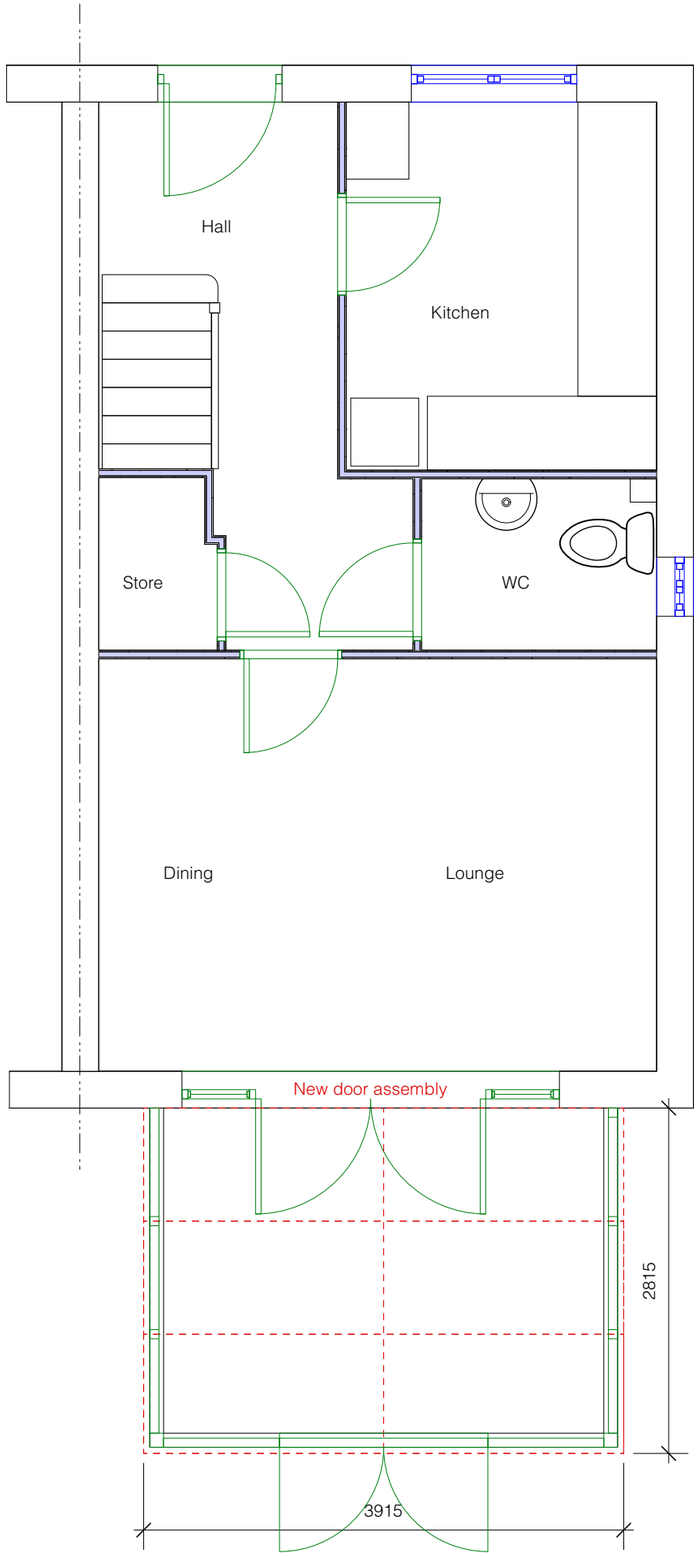

EXISTING GROUND FLOOR WITH CONSERVATORY ADDED AS BUILT

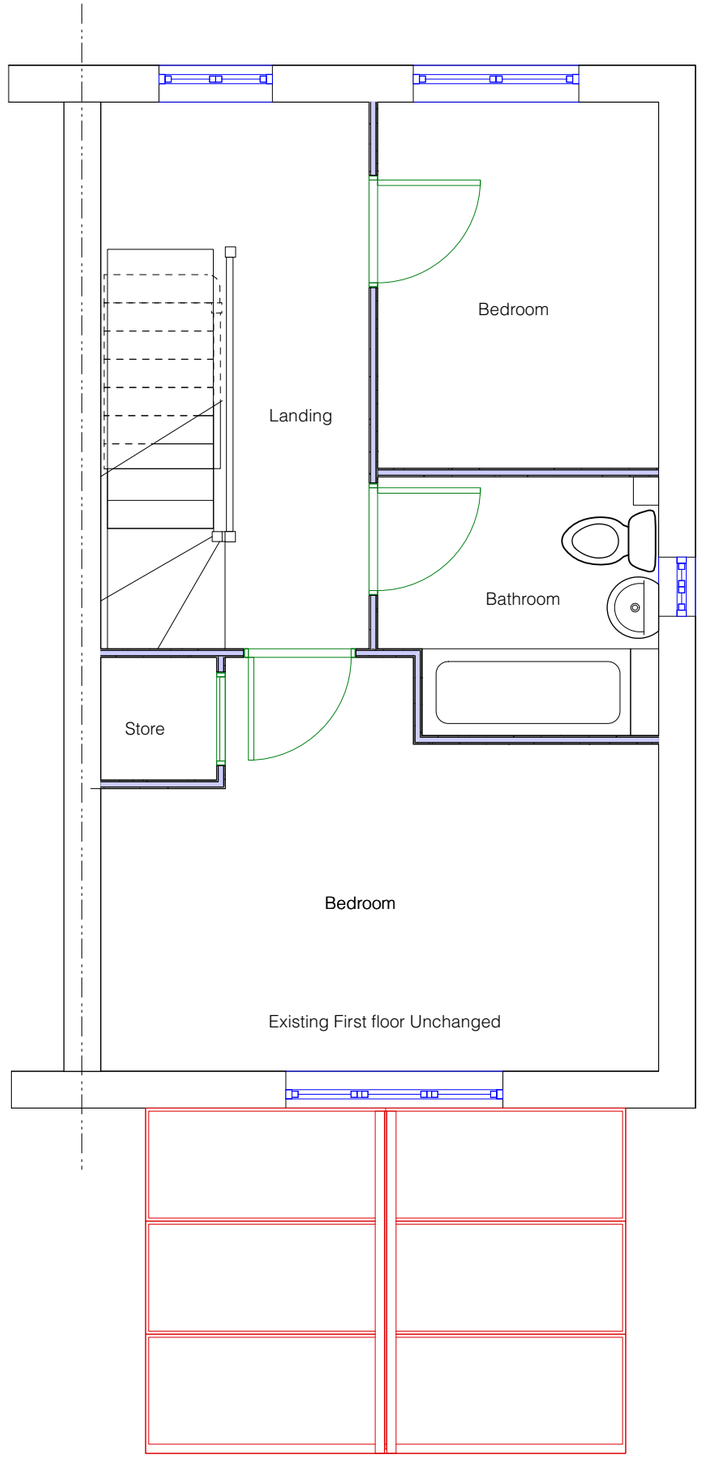

EXISTING FIRST FLOOR SHOWING CONSERVATORY ROOF

0 1.0 2.0 3.0 4.0 5.0 M

Sheet No. CLD 0623/653/03

Scales:
1:50 @A3

Notes:

Project Name:
Certificate of Lawful Developement (Existing) Conservatory to North Elevation

Date: 05/06/2023

Client:
Beaumont

Site Address:
18 Water Lily Way
Durrington
BN13 3GR

PB PROPERTIES
the design to build on

Paul Maggs MCIAT

Hazelwood, Harbolets Road,
West Chltington RH20 2LG

Tel: 01798 813298

paul@pbproperties.co.uk
www.pbproperties.co.uk

Drawings produced using Vectorworks CAD. Only written dimensions to be respected. Copyright protected to PB Properties

CIAT
CHARTERED PRACTICE



SOUTH

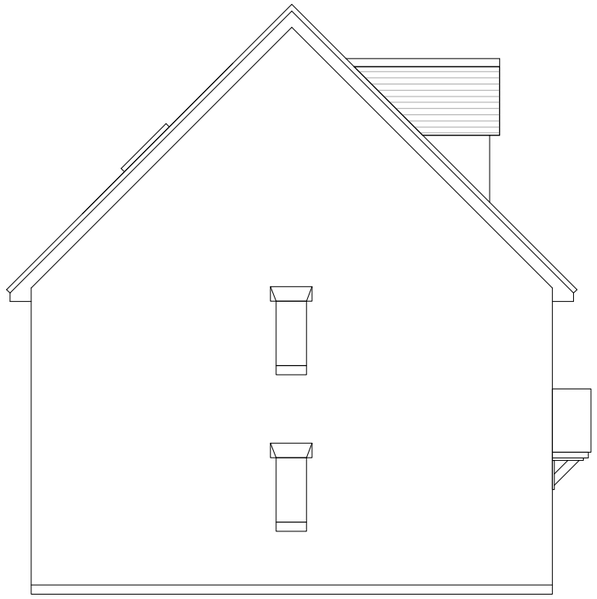

WEST

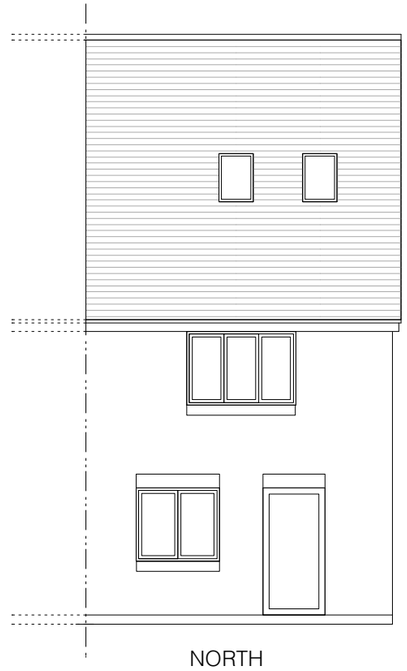

NORTH

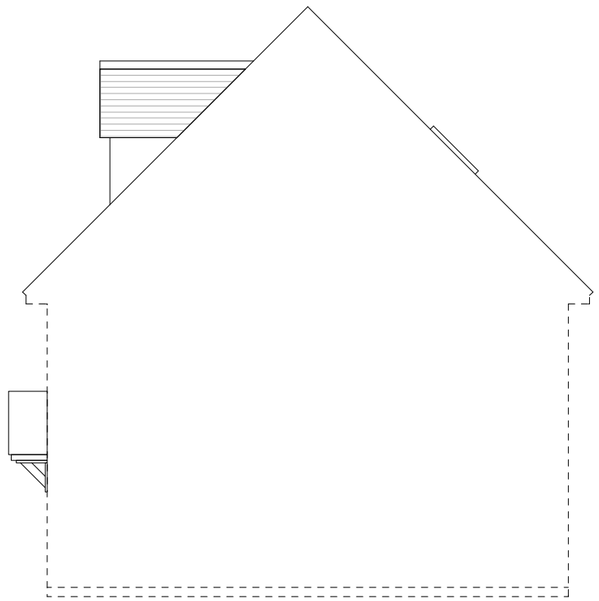

EAST VIA NEIGHBOUR PROPERTY



EXISTING AS BUILT ELEVATIONS AWDM/0721/16

0 0.5 1.0 2.0 3.0 4.0 5.0 M

Sheet No. CLD 0623/653/04

Scales:
1:100 @A3

Notes:

Project Name:
Certificate of Lawful Developement (Existing) Conservatory to North Elevation

Date: 05/06/2023

Client:
Beaumont

Site Address:
18 Water Lily Way
Durrington
BN13 3GR

PB PROPERTIES
the design to build on

Paul Maggs MCIAT

Hazelwood, Harbolets Road,
West Chltington RH20 2LG

Tel: 01798 813298

paul@pbproperties.co.uk
www.pbproperties.co.uk

Drawings produced using Vectorworks CAD. Only written dimensions to be respected. Copyright protected to PB Properties

CIAT
CHARTERED PRACTICE



SOUTH

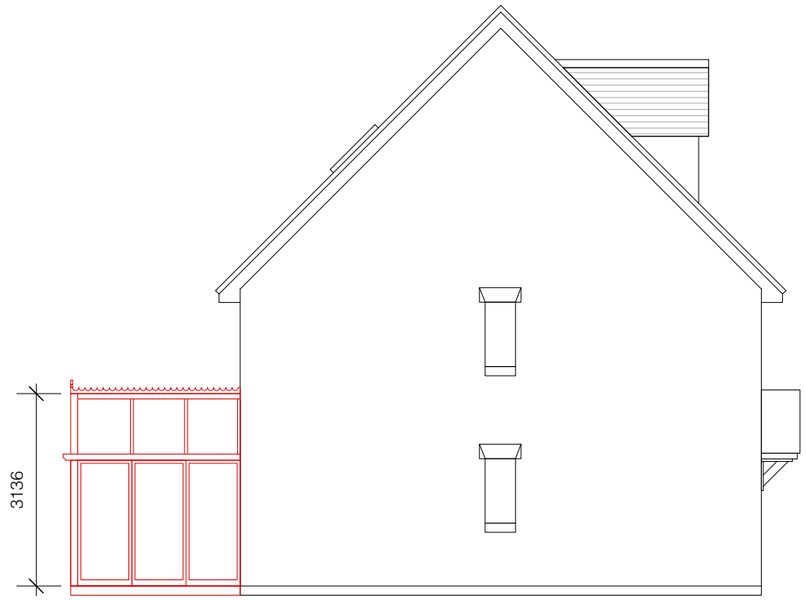

WEST

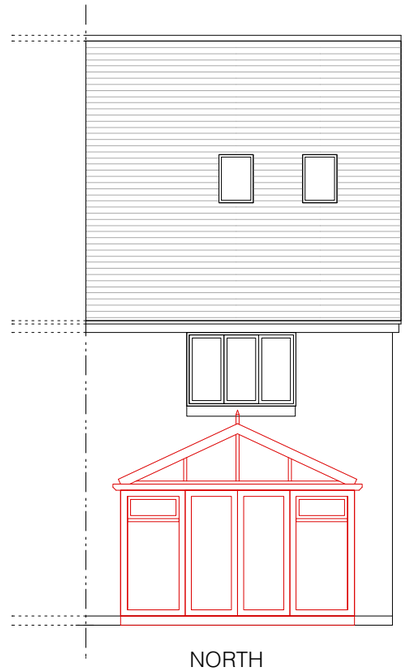

NORTH

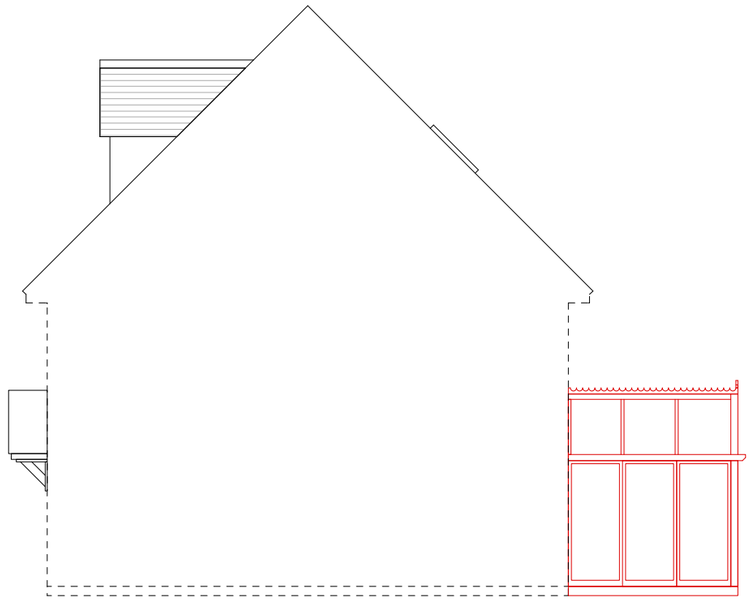

EAST VIA NEIGHBOUR PROPERTY



EXISTING AS BUILT ELEVATIONS Plus the additional Conservatory lined in red

000 1.0 2.0 3.0 4.0 5.0 M

Sheet No. CLD 0623/653/05

Scales:
1:100 @A3

Notes:

Project Name:
Certificate of Lawful Developement (Existing) Conservatory to North Elevation

Date: 05/06/2023

Client:
Beaumont

Site Address:
18 Water Lily Way
Durrington
BN13 3GR

PB PROPERTIES
the design to build on

Paul Maggs MCIAT

Hazelwood, Harbolets Road,
West Chltington RH20 2LG

Tel: 01798 813298

paul@pbproperties.co.uk
www.pbproperties.co.uk

Drawings produced using Vectorworks CAD. Only written dimensions to be respected. Copyright protected to PB Properties

CIAT
CHARTERED PRACTICE