

SOUTH

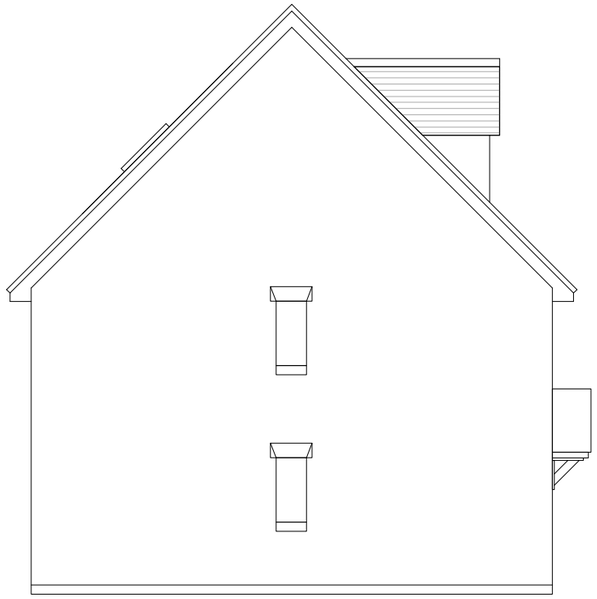

WEST

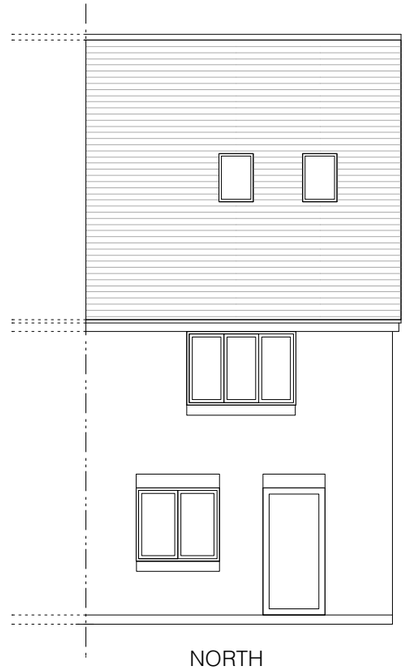

NORTH

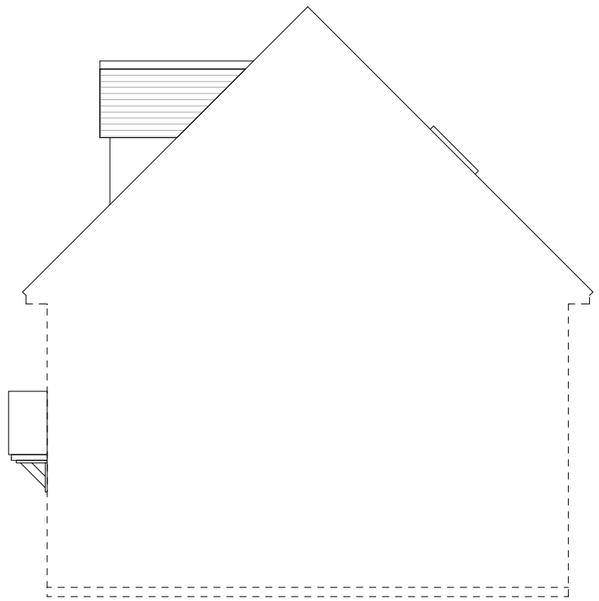

EAST VIA NEIGHBOUR PROPERTY



EXISTING AS BUILT ELEVATIONS AWDM/0721/16

0 0.5 1.0 2.0 3.0 4.0 5.0 M

Sheet No. CLD 0623/653/04

Scales:
1:100 @A3

Notes:

Project Name:
Certificate of Lawful Developement (Existing) Conservatory to North Elevation

Date: 05/06/2023

Client:
Beaumont

Site Address:
18 Water Lily Way
Durrington
BN13 3GR

PB PROPERTIES
the design to build on

Paul Maggs MCIAT

Hazelwood, Harbolets Road,
West Chltington RH20 2LG

Tel: 01798 813298

paul@pbproperties.co.uk
www.pbproperties.co.uk

Drawings produced using Vectorworks CAD. Only written dimensions to be respected. Copyright protected to PB Properties

CIAT
CHARTERED PRACTICE