DO NOT SCALE THIS DRAWING. CONTRACTORS MUST VISIT THE SITE AND TAKE RESPONSIBILITY FOR CHECKING ALL CRITICAL DIMENSIONS
COPYRIGHT: © JAMES BRECKELL CHARTERED ARCHITECT – ALL RIGHTS RESERVED

REV	DATE	BY	AMENDMENT
Rev A	24.05.12	jb	minor amendments to correspond to the built works
Rev B	20.06.12	jb	location of aircon units revised as built



PROPOSED GROUND FLOOR SERVICES PLAN 1:50



SERVICES KEY

- CM Carbon Monoxide sensor
- SD Smoke Detector
- Light switch
- LED down lighters
- Pendant Light
- External Light
- 3 Pin plug socket (double)
- Telephone Point
- External Power Socket
- External Tap
- Otoscope (electricall power required)
- Mechanical Extract
- EL Emergency lighting
- FB Fuse Board
- cat5 Catagory 5 cabling back to IT cupboard
- cat5 term Catagory 5 cabling terminal
- Flourescent
- B Boiler
- Air conditioning cassette at high level

Fire Alarm system to comply with BS5839 Part 6 Category D LD2

PROPOSED GROUND FLOOR FIT OUT PLAN 1:50

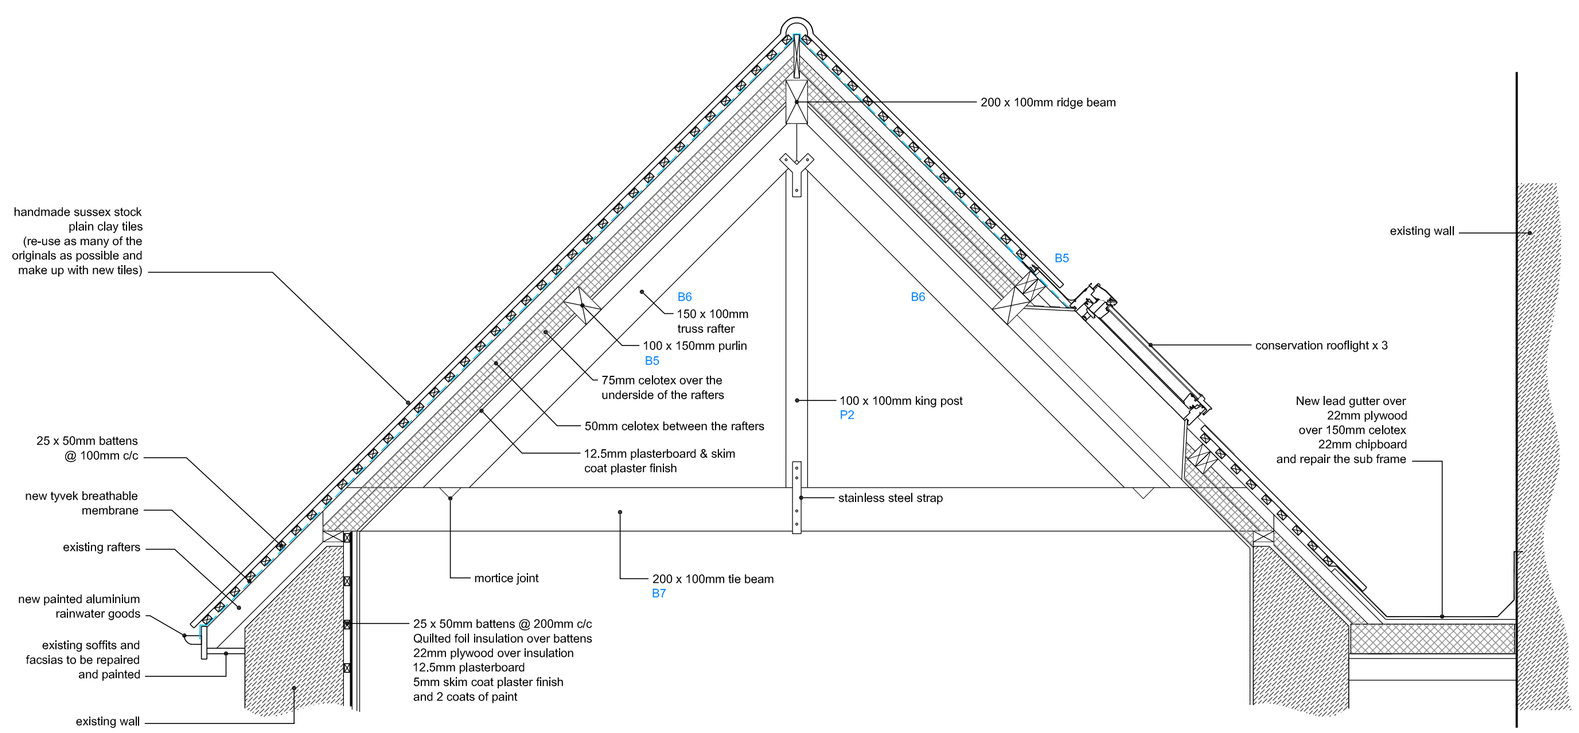

PROPOSED SECTION THROUGH SALON ROOF 1:20



PROPOSED SITE PLAN 1:200

James Breckell Architects
The Adur Business Centre
Little High Street
Shoreham by Sea
BN43 5EG
Tel: 01273 467 621
email: james@breckell.co.uk
website: www.breckell.co.uk

CLIENT
Grove Lodge Veterinary Group

JOB
Proposed Veterinary Surgery at 21 Southwick Street, Southwick BN42 4AD

DRAWING
Proposed Ground Floor Plan and Site Plan

DATE	April 2012
SCALE	As shown @ A1
DRAWN BY	jb
JOB NO.	298
DWG NO.	12
REVISION	B