97 OLD FORT ROAD, SHOREHAM BY SEA, BN43 5HA

Demolition of the existing bungalow and construction of a residential dwelling house

May 2024

Drawing Number 457/ A1/ 50 For Building Regulations

BALCONY HANDRAIL

AS BUILT - SEPTEMBER 10TH 2024

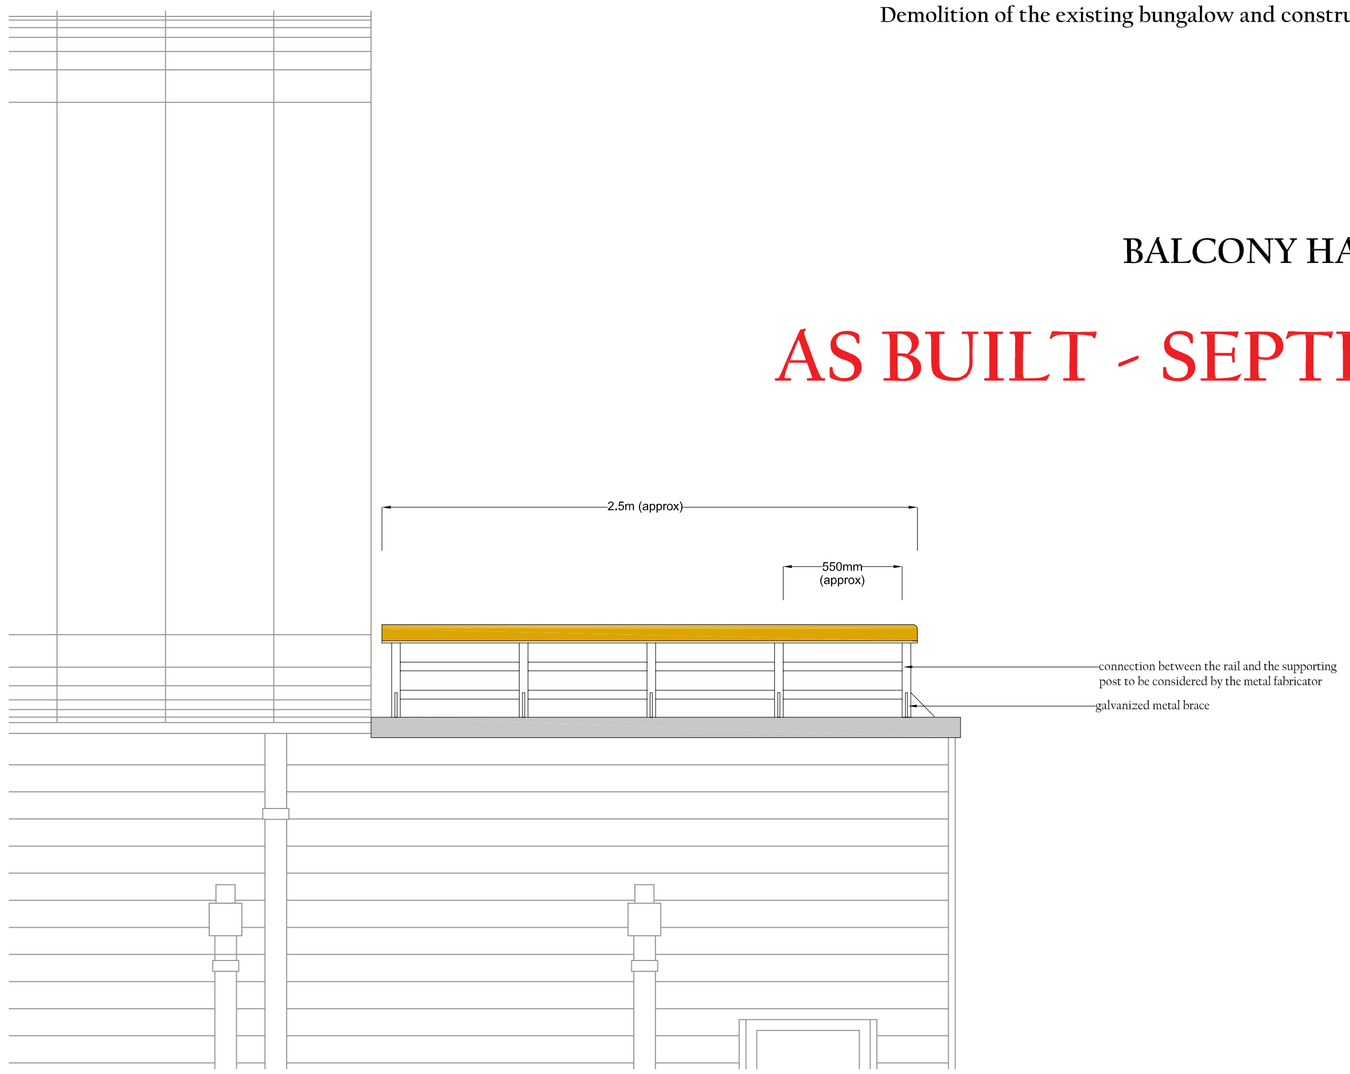

SIDE ELEVATION 1:20

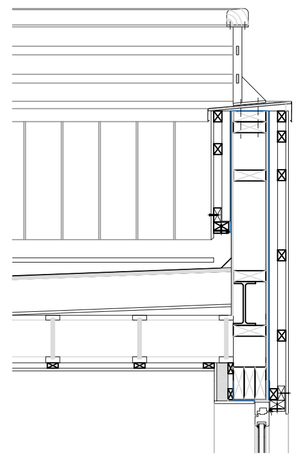

CONSTRUCTION SECTION 1:20

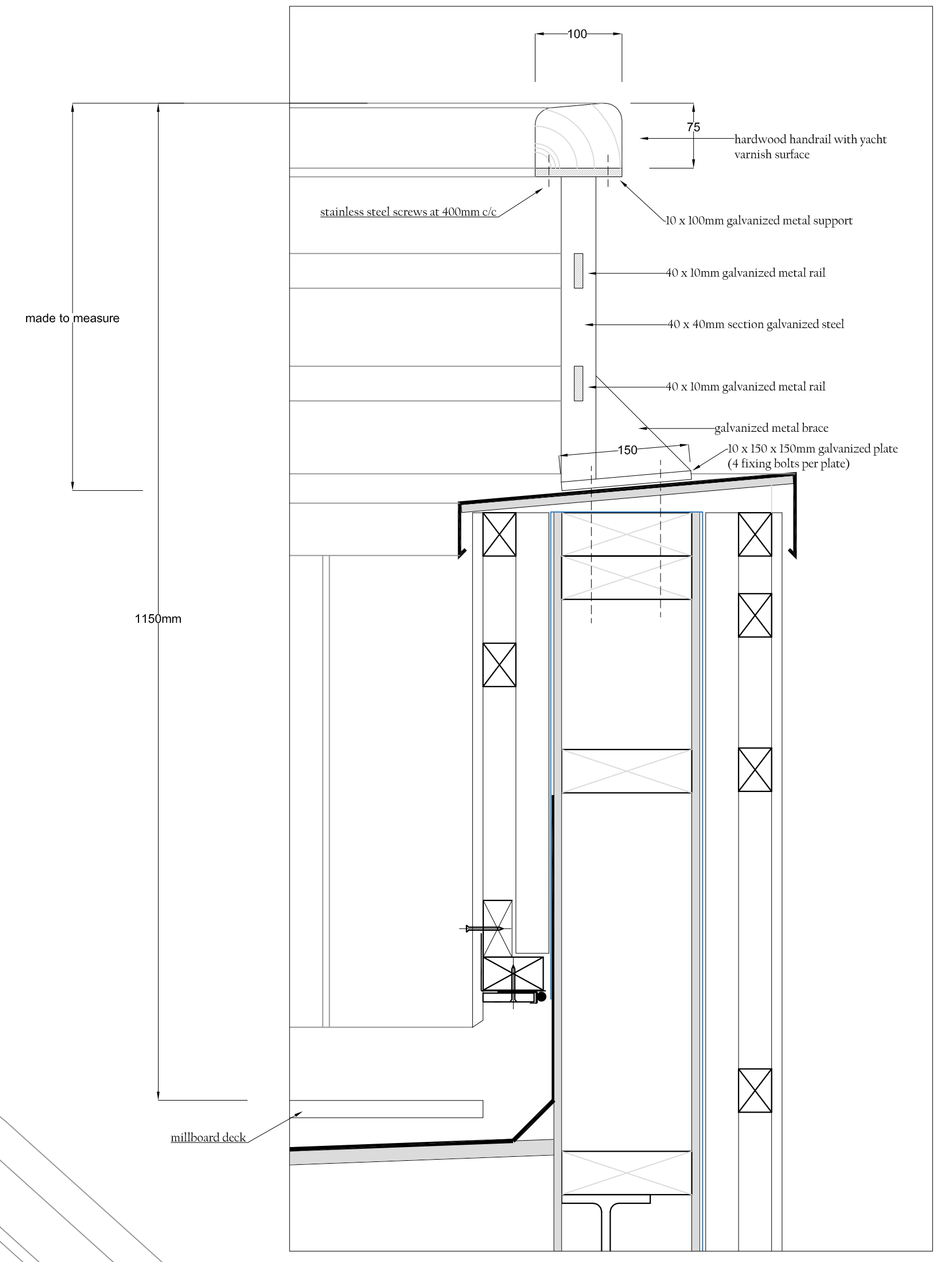

CONSTRUCTION SECTION 1:5

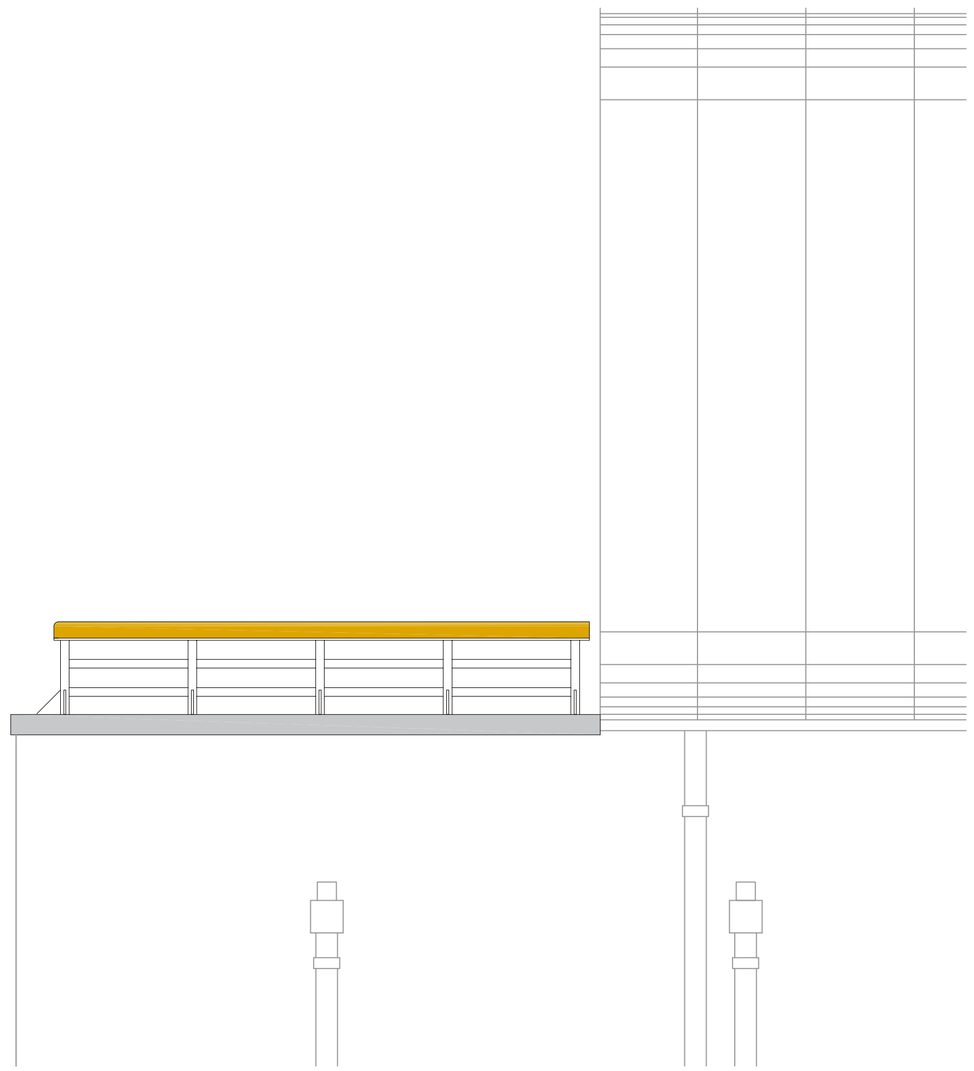

SIDE ELEVATION 1:20

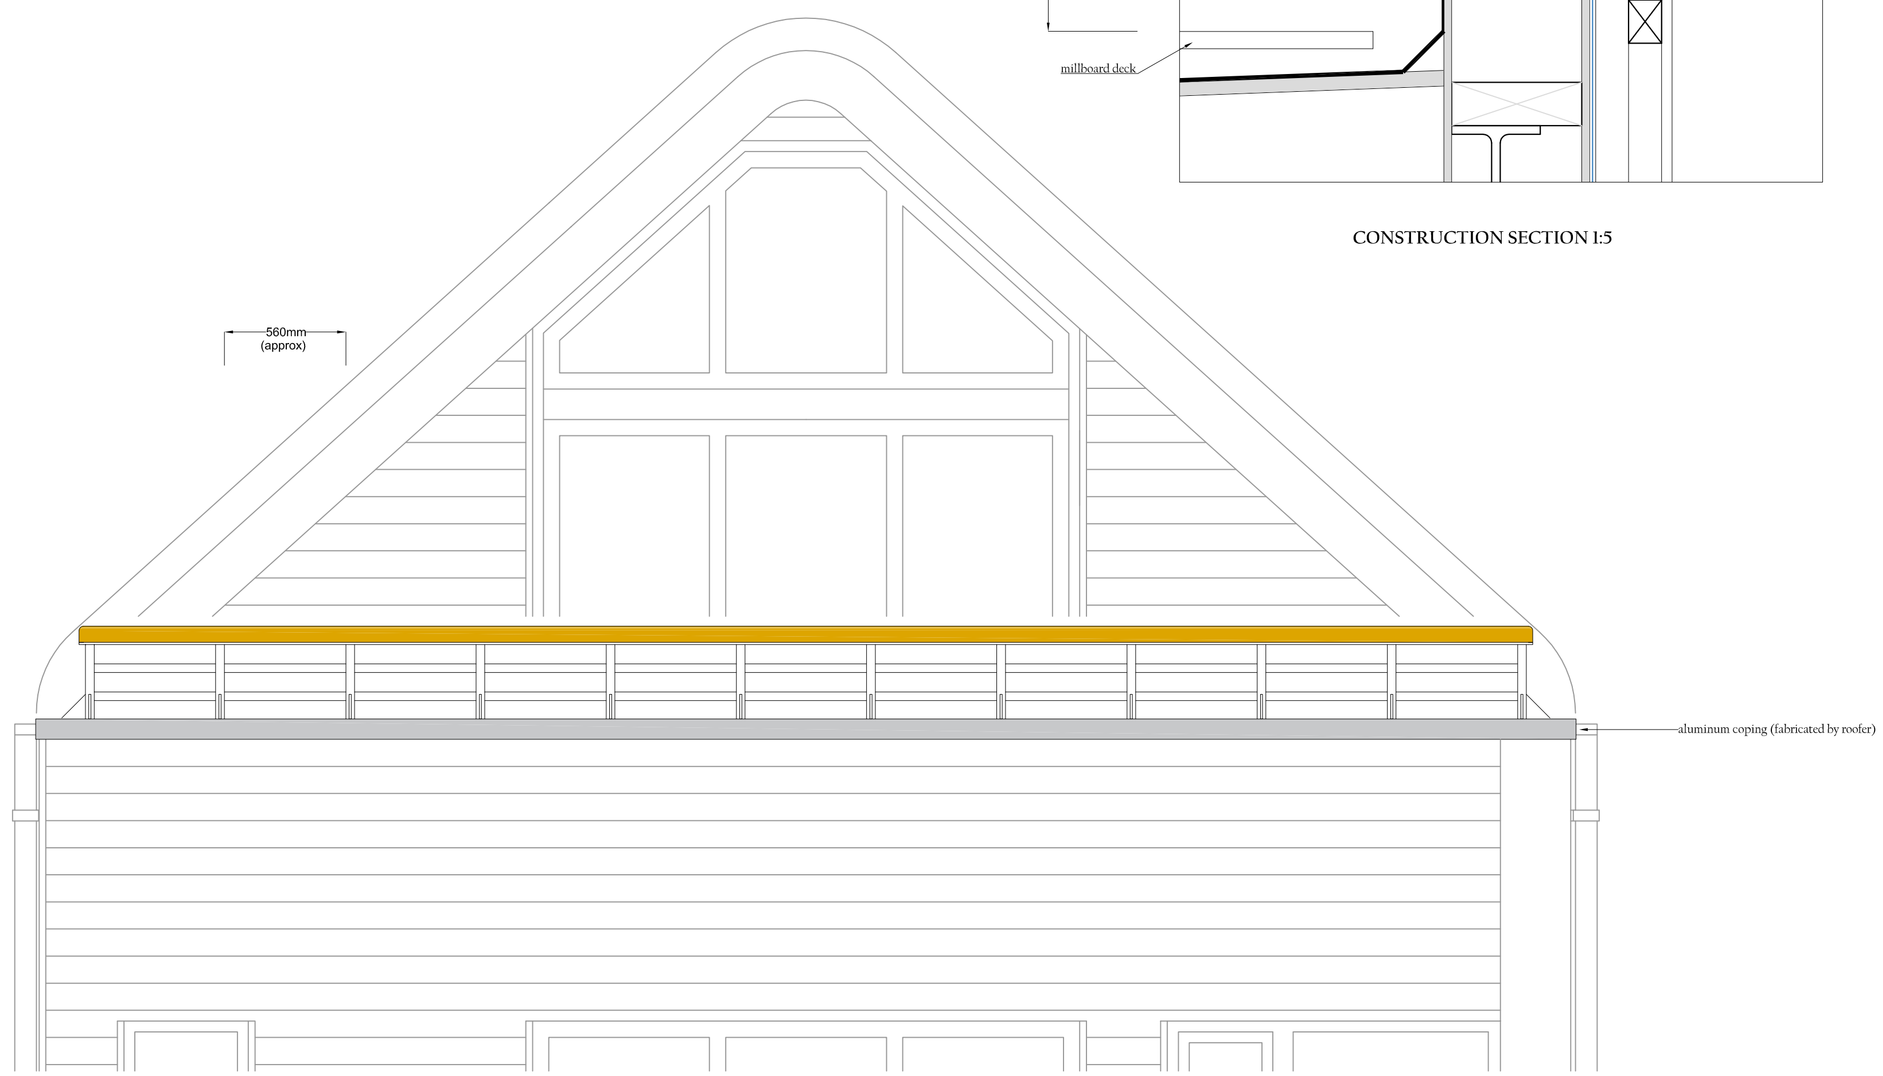

FRONT ELEVATION 1:20

JAMES BRECKELL : ARCHITECT : ARB : RIBA

89 Old Fort Road, Shoreham by Sea, West Sussex, BN43 5HA Tel 07733 268 297, Email: james@breckell.co.uk