Extensions & alterations:
2 WEST LANE
LANCING
WEST SUSSEX BN15 9RR

~~DATE~~ ~~VALID~~	1500; 24/1/19
PLAN	AWDM\0018/18
PLANNING SERVICES	

ADUR & WORTHING

Drawing No. 218\561\5 A

Paul Trussler
44 Firle Road
Lancing
West Sussex
BN15 0NZ

AMENDMENTS
Rev A: 24/01/2019 - Rear extension to extension realigned
front elevation removed & front mark reduced by 200mm, dormitories to

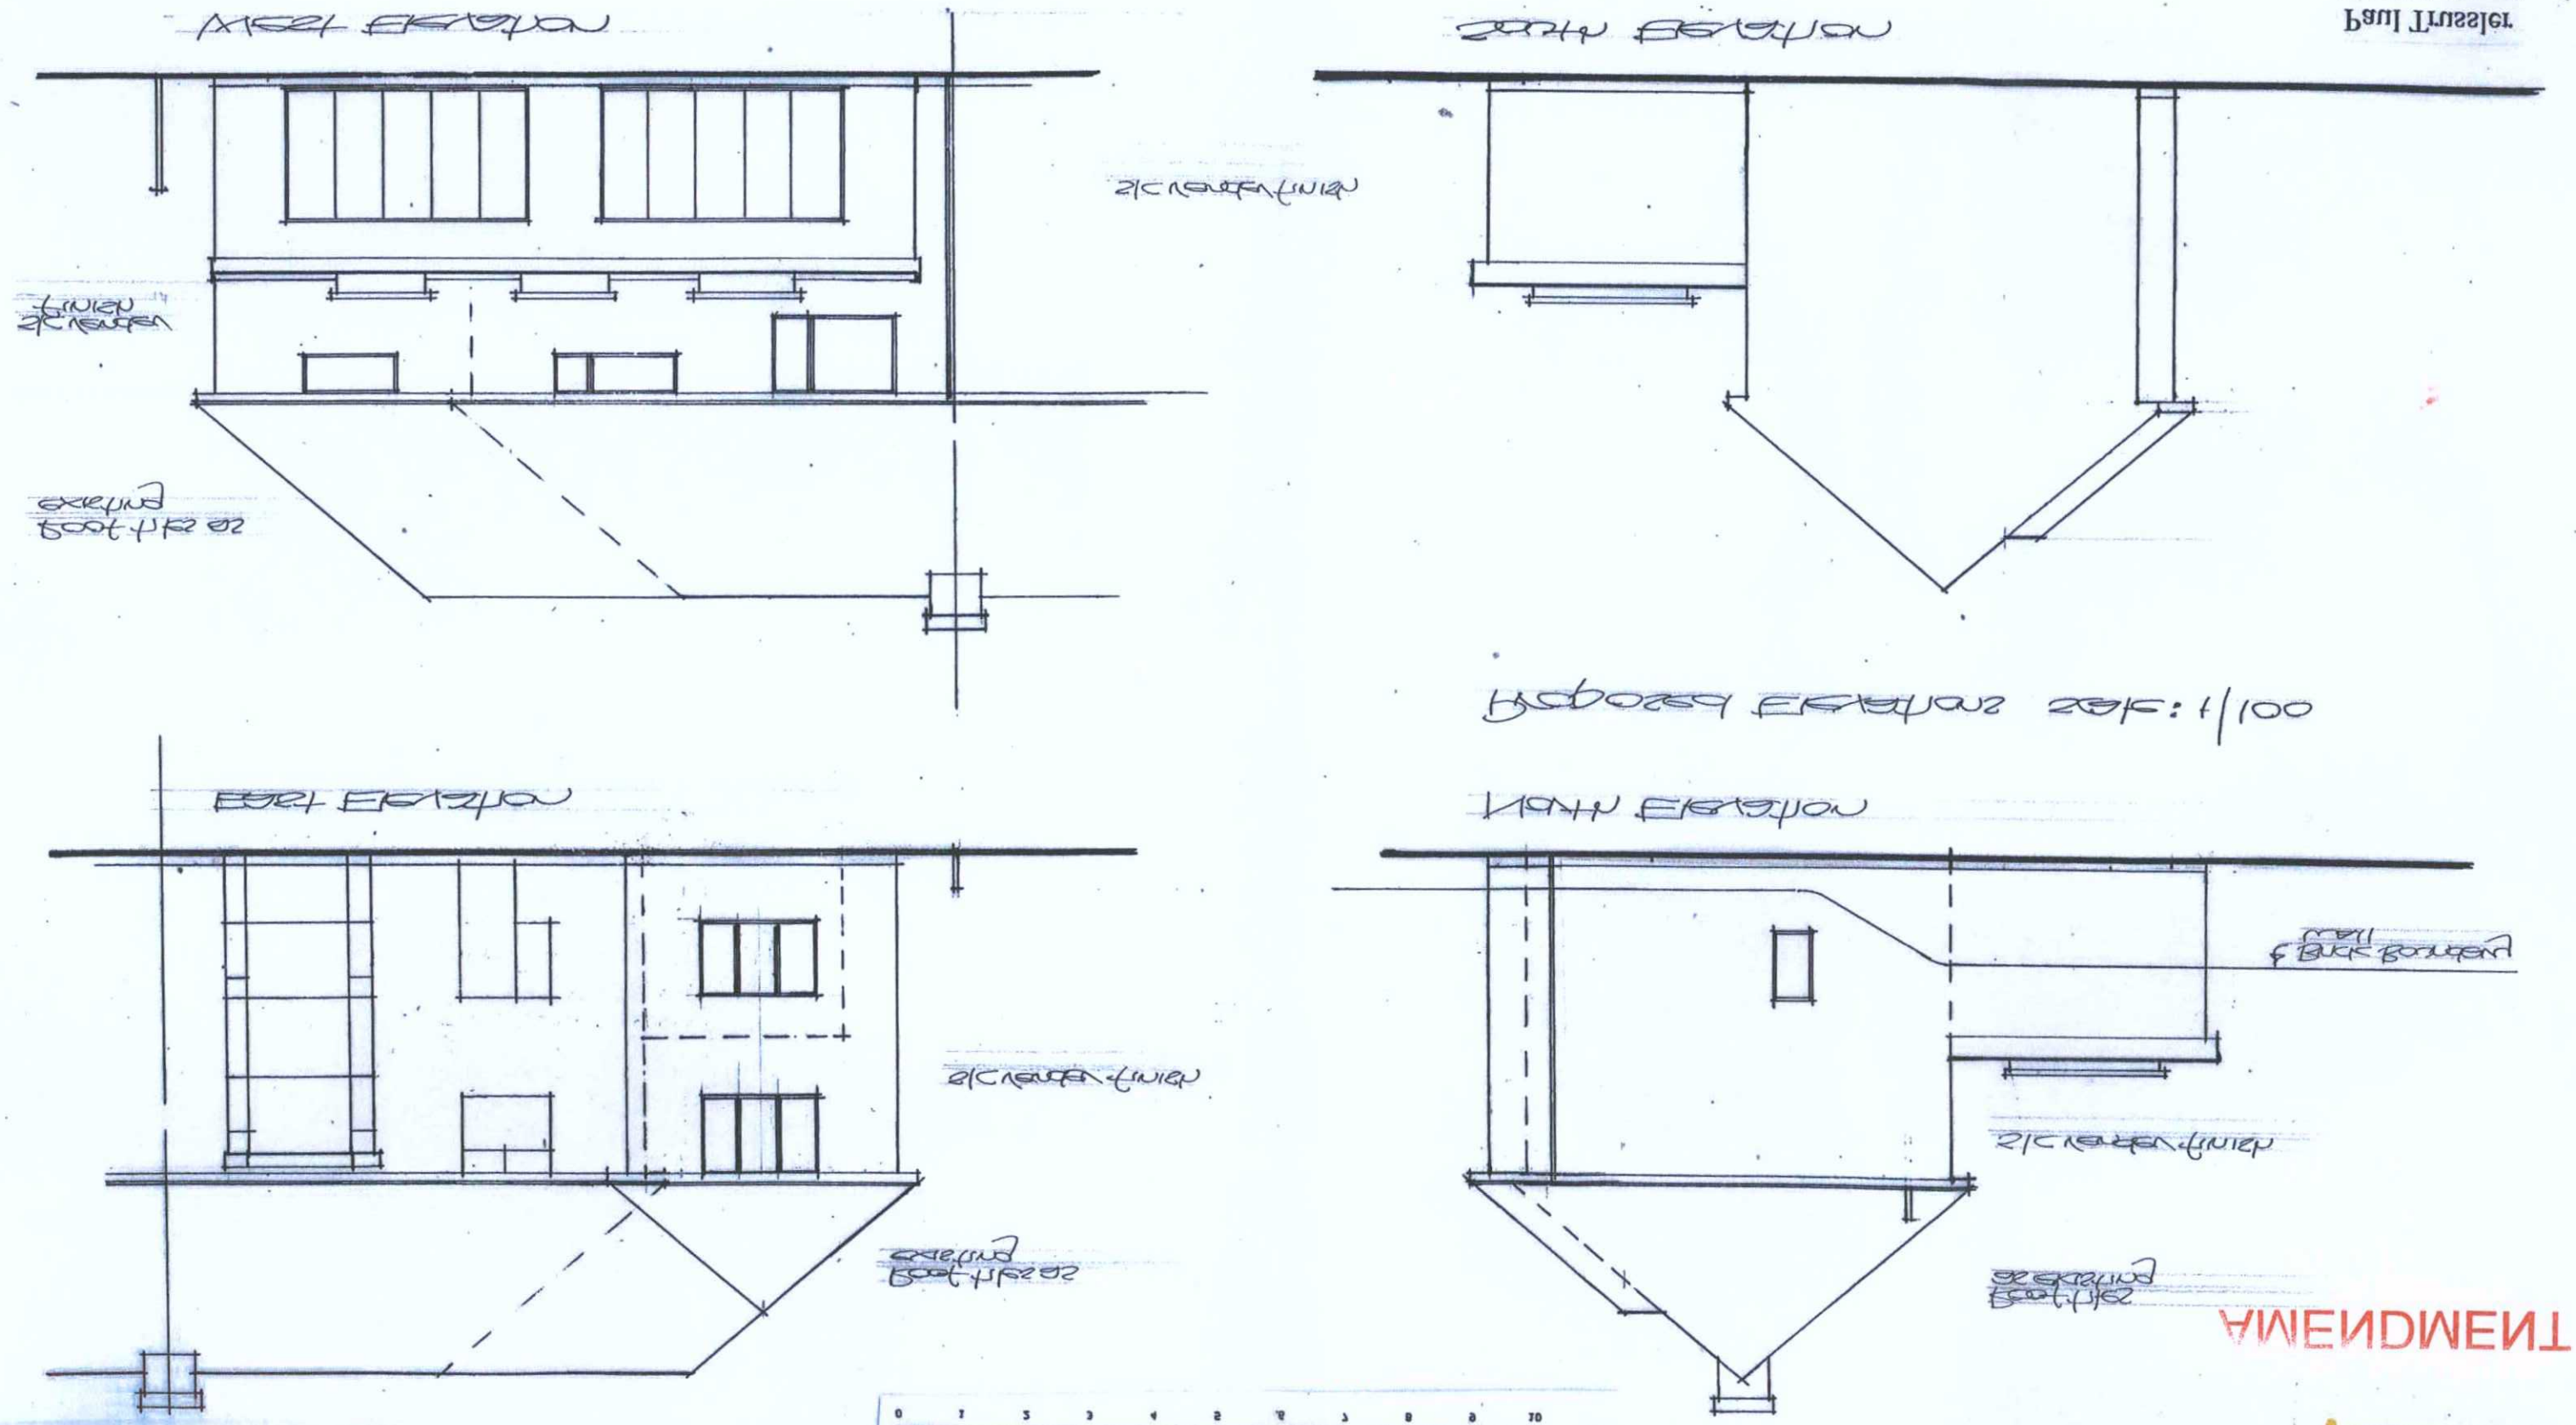

AMENDMENT

A3 PAPER SIZE