



FRONT ELEVATION



SIDE ELEVATION (east)

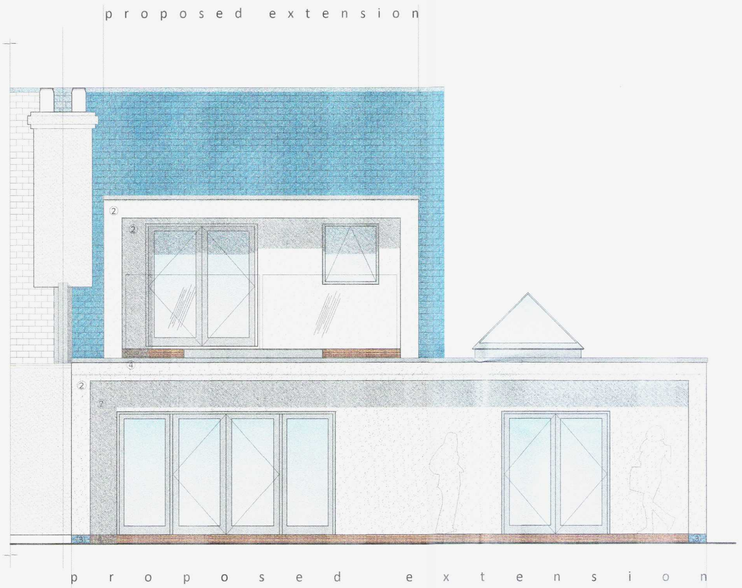

REAR ELEVATION

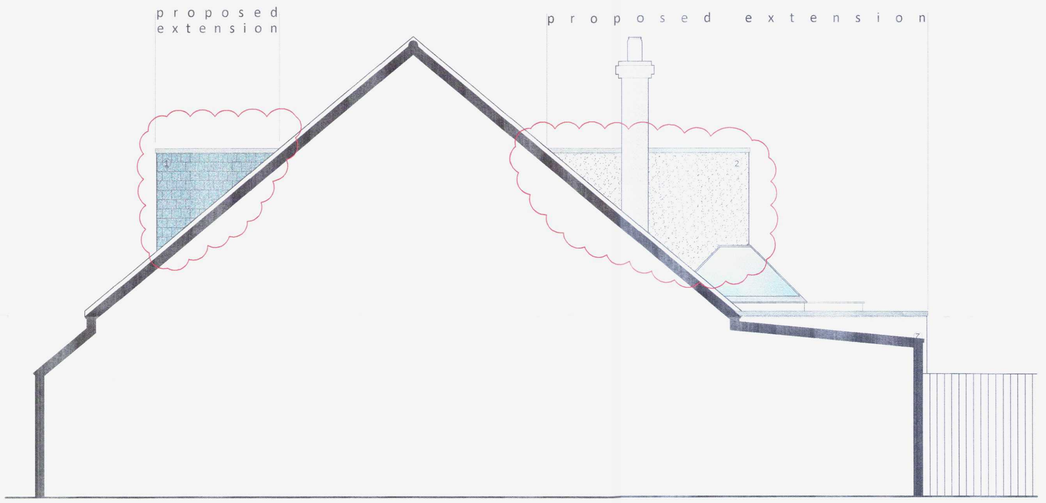

SECTIONAL ELEVATION (west)

0 1 2 3 4 5
meters

8c

NOTE:

- **DO NOT SCALE**, except for planning purposes.
- The contractor is required to check all dimensions on site before work commences.
- All goods, materials and workmanship to comply with current Building Regulations, BSS, COP's and such other requirements as the local/statutory authorities/ enforcement officer may consider necessary.

© This drawing is copyright of Crowther Overton-Hart

FINISHES:

1 Grey composite slate roof tile
2 Sand cement smooth render, brilliant white paint finish
3 Deep blue engineering brick plinth
4 Natural Teak

All doors, door frames, window frames & flashings to be powder coated drak grey finish.
New & existing down pipes, svp's etc to be painted to match above.

AMENDMENT

ADUR & WORTHING
PLANNING SERVICES
PLAN AWDM/0376/15
RECD 01.06.15

Revision		
F	01.06.15 Doormer cheek finishes shown	CH
E	26.05.15 Amendments to Planning Officers comments	CH
D	20.05.15 Amendments to Planning Officers comments	NB
C	15.05.15 Amendments to Planning Officers comments	NB
B	24.03.15 Sectional elevation (west) shown, at planners request.	NB
A	23.03.15 Side elevation (west) shown, at planners request.	NB

Project
Re-Modeling
51 Sompting Road
Lancing
BN15 9LB

Drawing
Proposed Elevations

Client
Mr. & Mrs. M. Jefford

Scale		
1:50 @ A1		
Date	Drawn By	Checked By
Feb. '15	NB	ROH

Information	☐	Preliminary	■
Approval	☐	Planning	☐
Tender	☐	Building Regs.	☐
Construction	☐	As Built	☐

Drawing No. 448.14.15 F Revision

crowther overton-hart
28 Chanctonfold, Horsham Road
Steyning, West Sussex, BN44 3AA
T 01903 816290 F 01903 814163
E reception@cohsurveyors.co.uk

RICS