

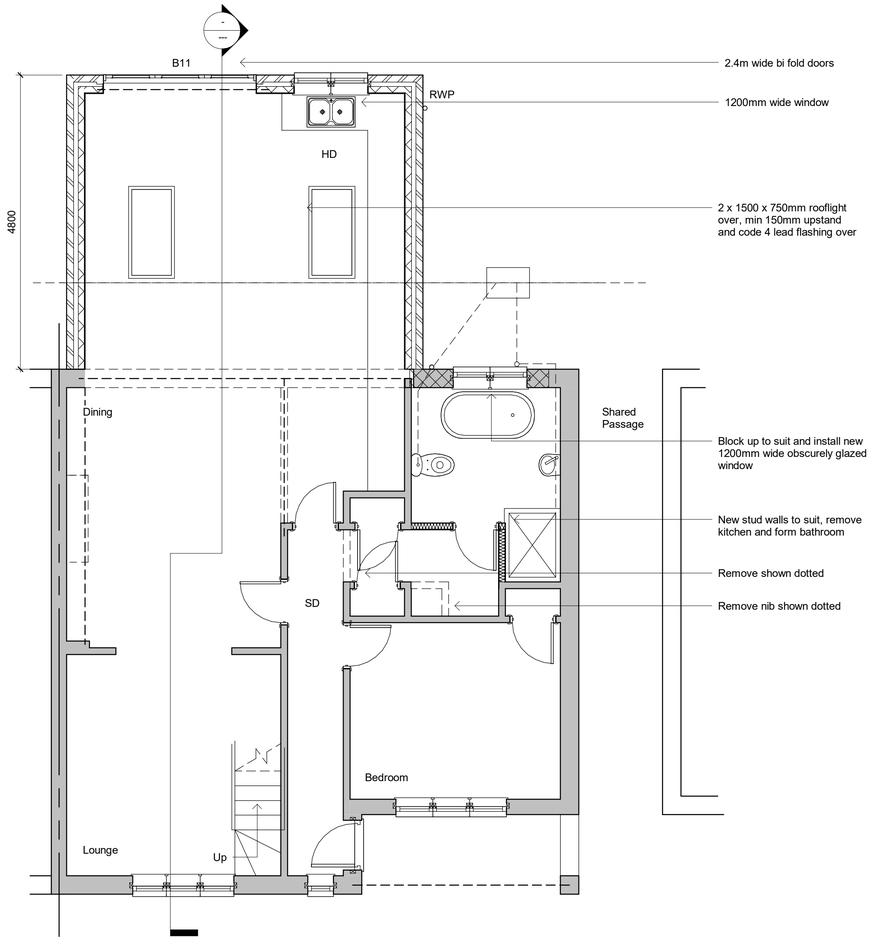


Ground Floor

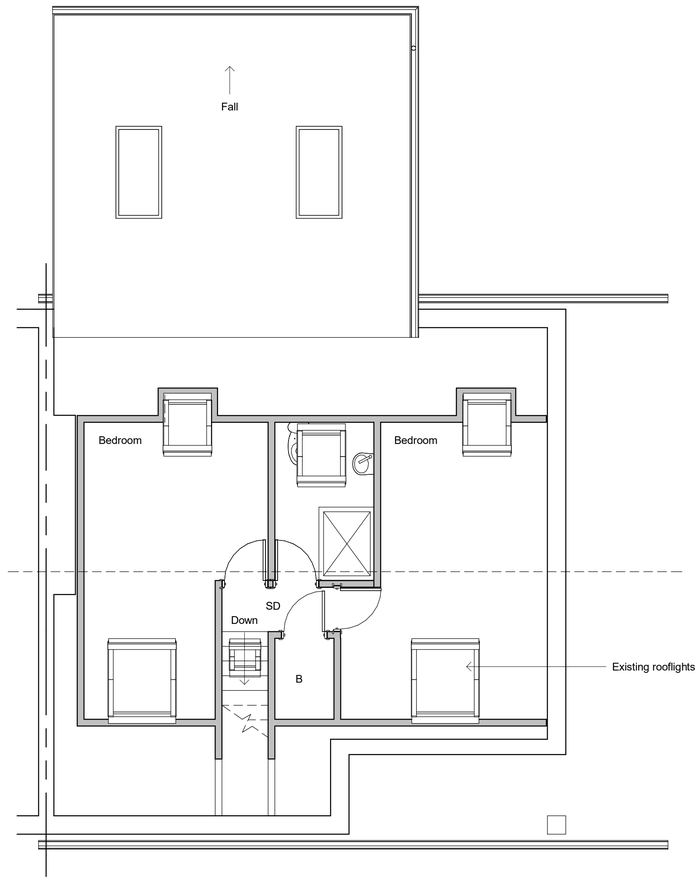


First Floor

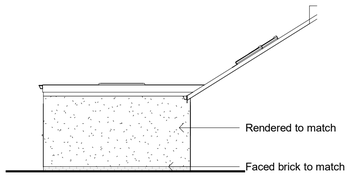


Side Elevation

Northwest

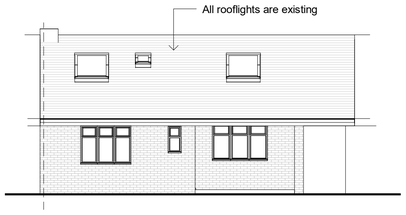

Front Elevation - No Change

Southwest

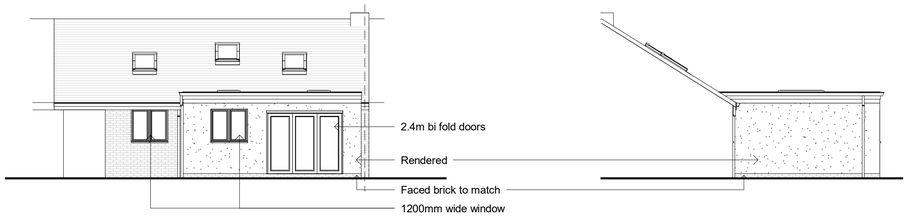


Rear Elevation

Northeast

Side Elevation

Southeast

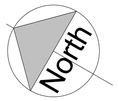

Revisions

0.5 0 0.5 1 1.5 2 2.5
SCALE 50 m
1:

0.5 0 0.5 1 1.5 2 2.5
SCALE 50 m
1:

Materials

Drawing Number	2019/154	Sheet	1 of 1
Size	A1	Scale	1:50, 1:100

Project

As built details
June 2020

Job Title

102 Downsway
Southwick
West Sussex
BN42 4WD

Do Not scale from this drawing except for planning as photocopies will be subject to distortion
Drawings to be read in conjunction with all other Designers and structural engineers contract drawings and specifications: Any discrepancies must be brought to the attention of the Designer immediatialy.
The contractor must verify all dimensions by site measurement before ordering materials or manufacturing components
Substitute materials and products to those named will be acceptable if proven to be of equal or higher performance and not in conflict with other elements

M.J.Humphrey Ltd

RICS cabe chartered association of building engineers

Mel Humphrey MRICS, MBEng
39 Northease Drive
Hove
East Sussex
BN3 8PQ
Mel@mjhumphrey.co.uk
07701055182

Adam Humphrey
9 Racton Road
Emsworth
Hampshire
PO10 7SY
Adam@mjhumphrey.co.uk
07812419142