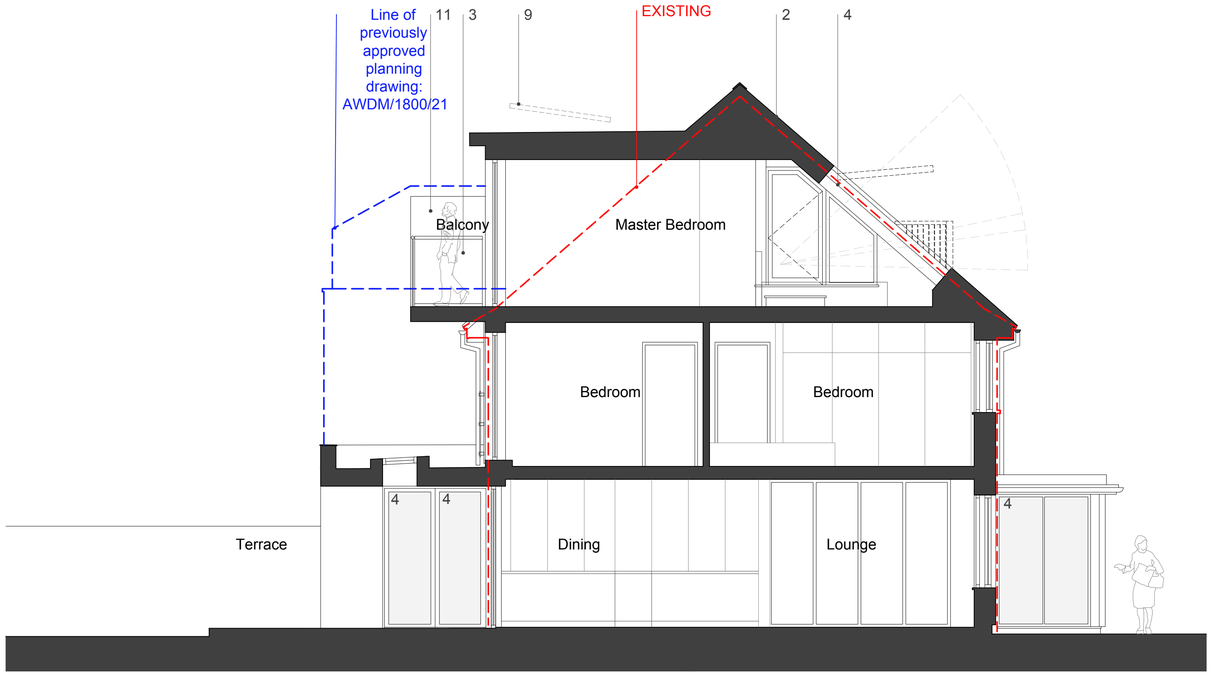

Section B-B 1:50

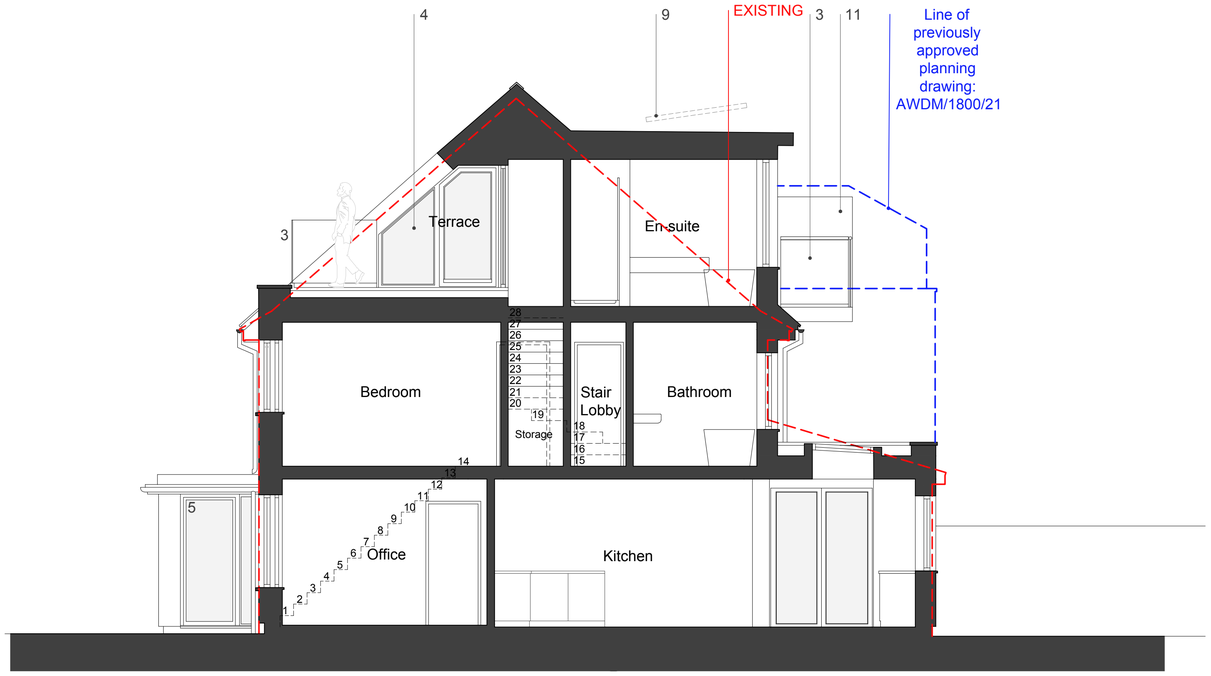

Section C-C 1:50

KEY

1A. Vertical timber cladding
1B. Horizontal timber cladding
2. Zinc cladding
3. Glass balustrade
4. Double glazed composite frame windows/doors/rooflights
5. Timber entrance door with a side light
6. Metal gutters,downpipes and fascias
7. Metal flue
8. White rendered walls
9. PV
10. Double glazed PC aluminium bi-folding doors
11. 1.8m high obscured glazed screen

0 1 2 3 4 5 6 7 8 9 10
scale in metres 1:50

amendments				
rev.	date	comment	auth	chkd.
-	29.09.21	Issued for planning	ACB	GI
A	26.10.21	Red line to show existing	ACB	GI
B	21.07.22	Amended Planning Issue	ND	GI
C	23.08..22	Privacy screens added to balcony	ND	GI

client: Mr and Mrs Roberts
drawing number: 0642.PL.003
revision: C
project: 62 Beach Green, Shoreham by Sea, BN43 5YA
drawing title: Proposed Sections, Planning
drawn by: A.C.B
checked by: G.I
riba work stage: 2
date: Sep '21
scale/original sheet size: 1:50 @ A1

www.abir.co.uk studio@abirarchitects.co.uk
Unit 1, Beta House, St John's Road, Hove, BN3 2FX, United Kingdom
Hove +44 (0)1273 724 384
Company No 06877117 VAT No 971 4147 17

© ABIR Architects Ltd. Check all dimensions on site before work is undertaken. All goods, materials and workmanship to conform with current building regulations, BSS and COP's.

ABIR architects
RIBA Chartered Practice