
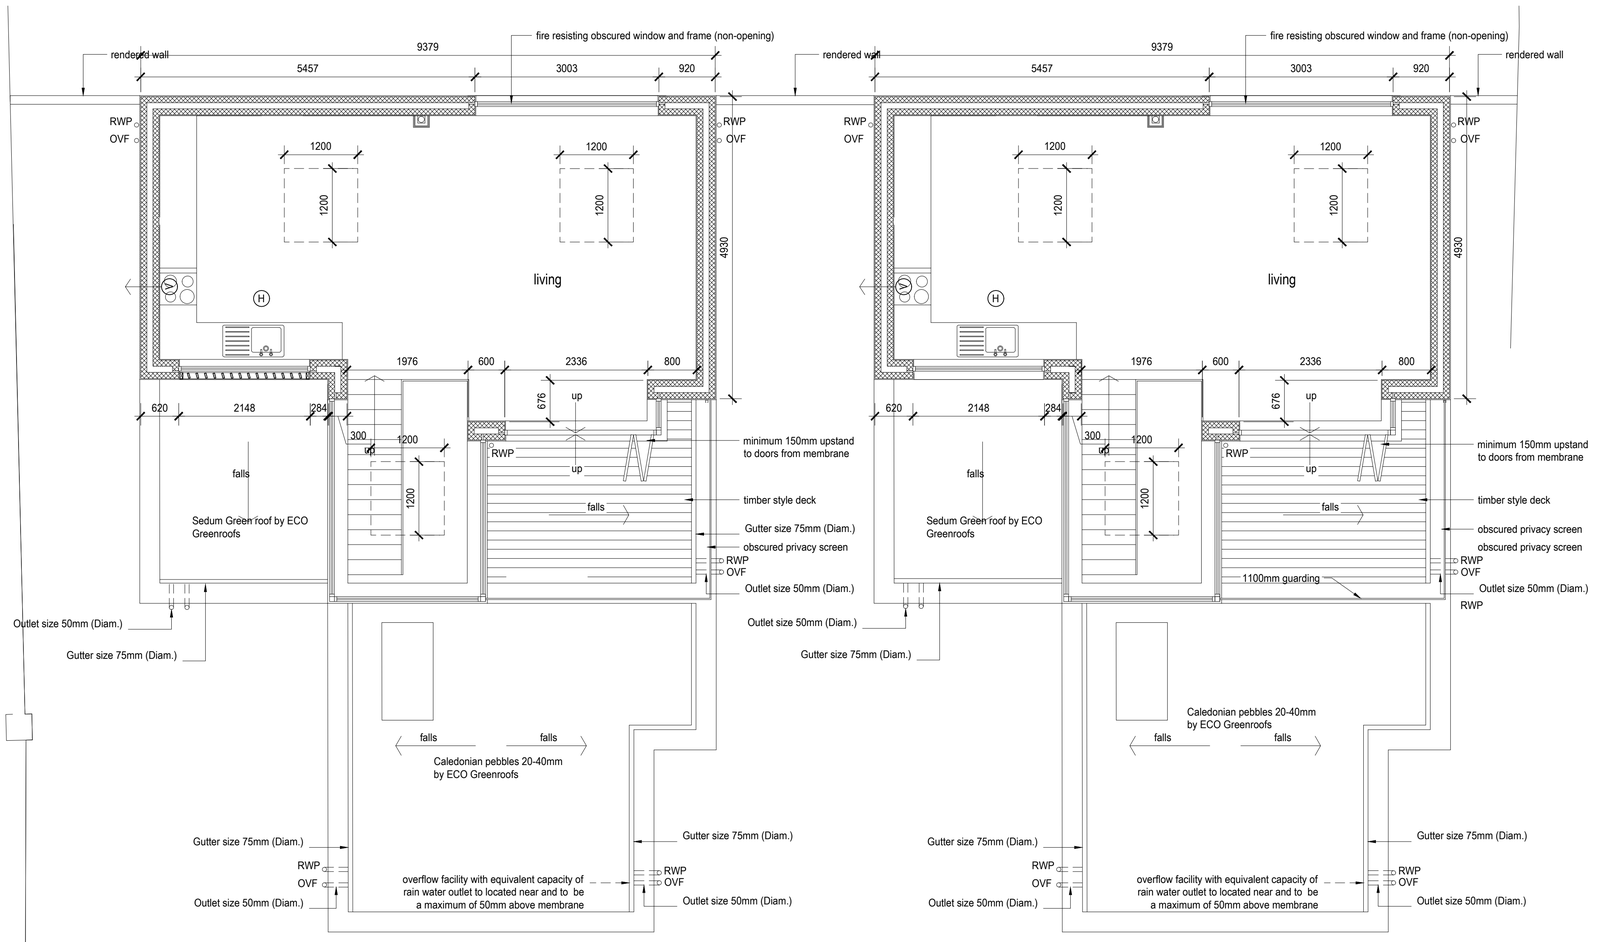



First Floor Plan House 1 & 2 1:50

First Floor Plan House 1 & 2 1:50

Screening plan 1:20

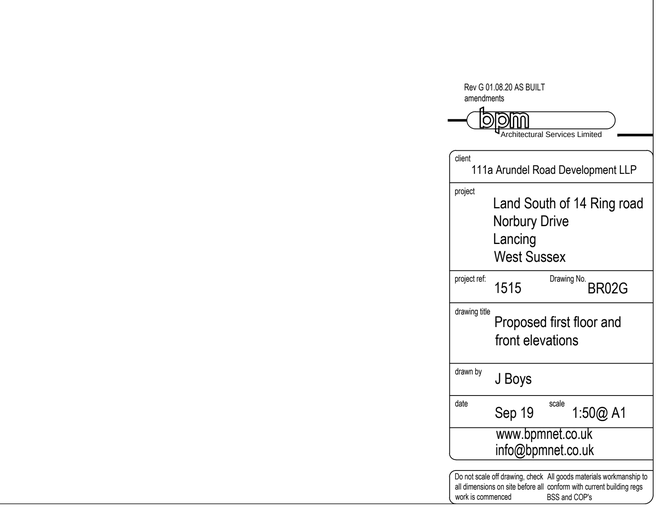

Window elevation 1:20
(showing slatted screening)

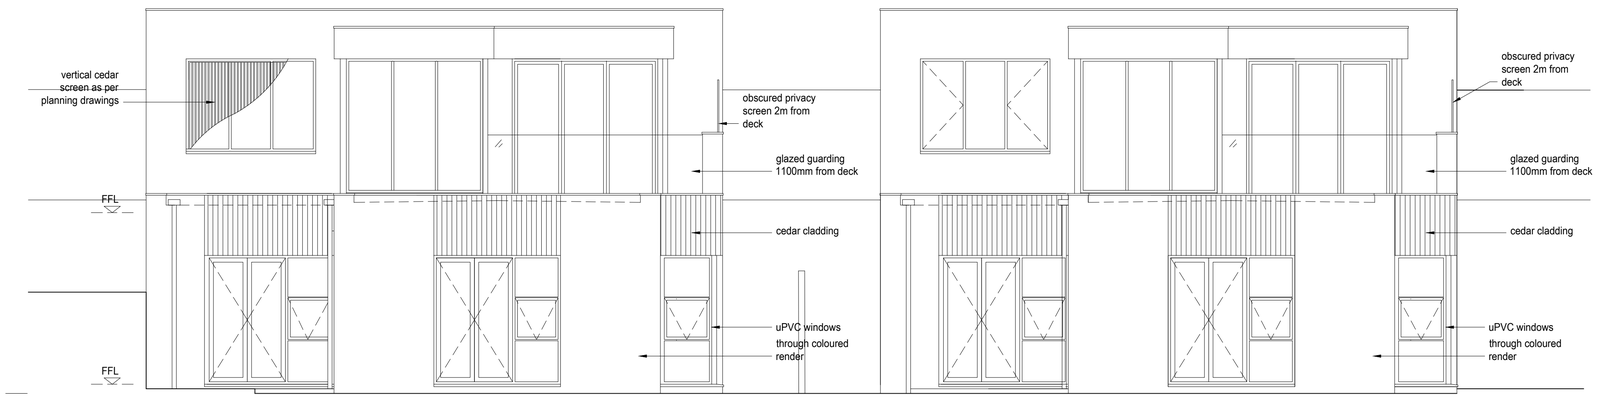

Proposed South elevation 1:50

Rev G 01.08.20 AS BUILT amendments

bpm Architectural Services Limited

client: 111a Arundel Road Development LLP

project: Land South of 14 Ring road
Norbury Drive
Lancing
West Sussex

project ref: 1515

Drawing No. BR02G

drawing title: Proposed first floor and front elevations

drawn by: J Boys

date: Sep 19

scale: 1:50@ A1

www.bpmnet.co.uk
info@bpmnet.co.uk

Do not scale off drawing, check all dimensions on site before all work is commenced

All goods materials workmanship to conform with current building regs BSS and COP's