
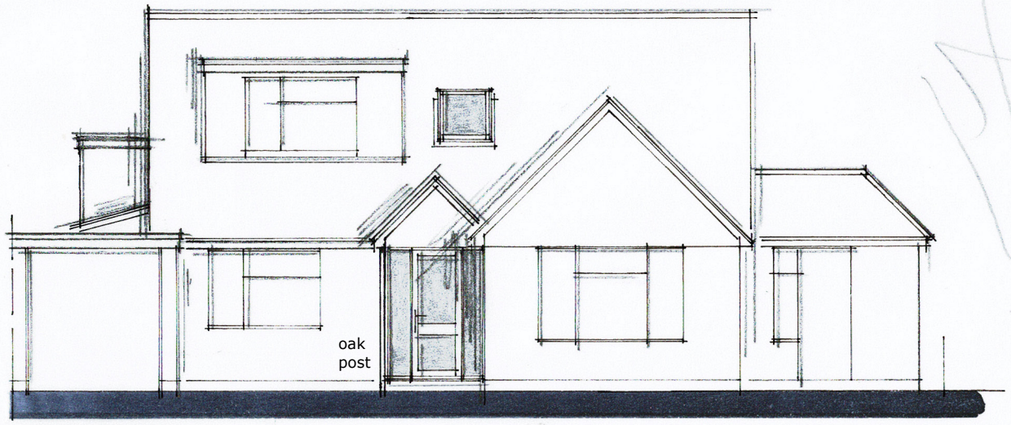



FRONT (n)

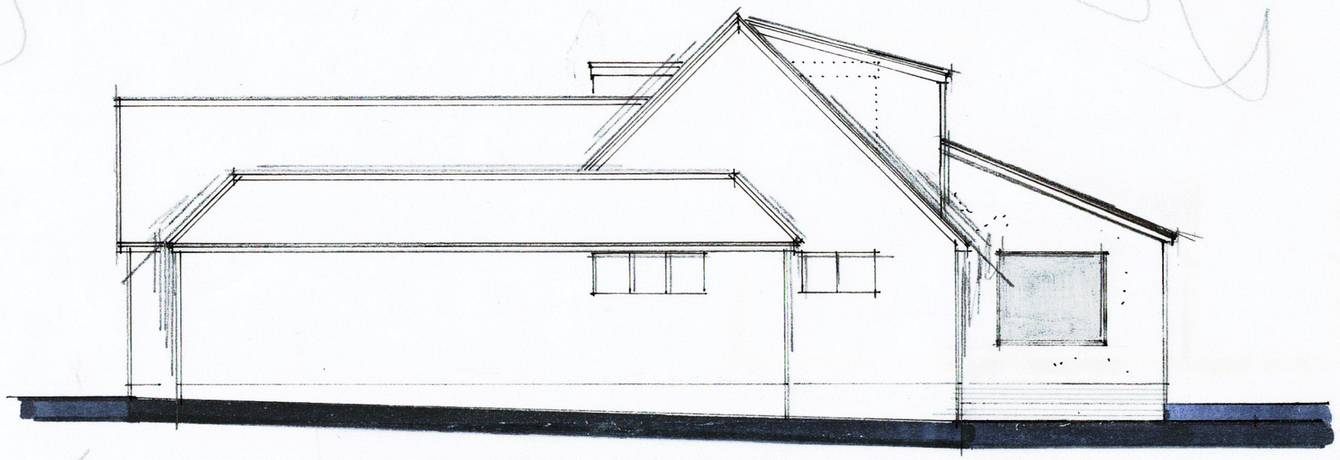

SIDE (w) ELEVATION 1:100 @ A3 / 1:50 @ A1

0 1 2 3 4 5m

metres

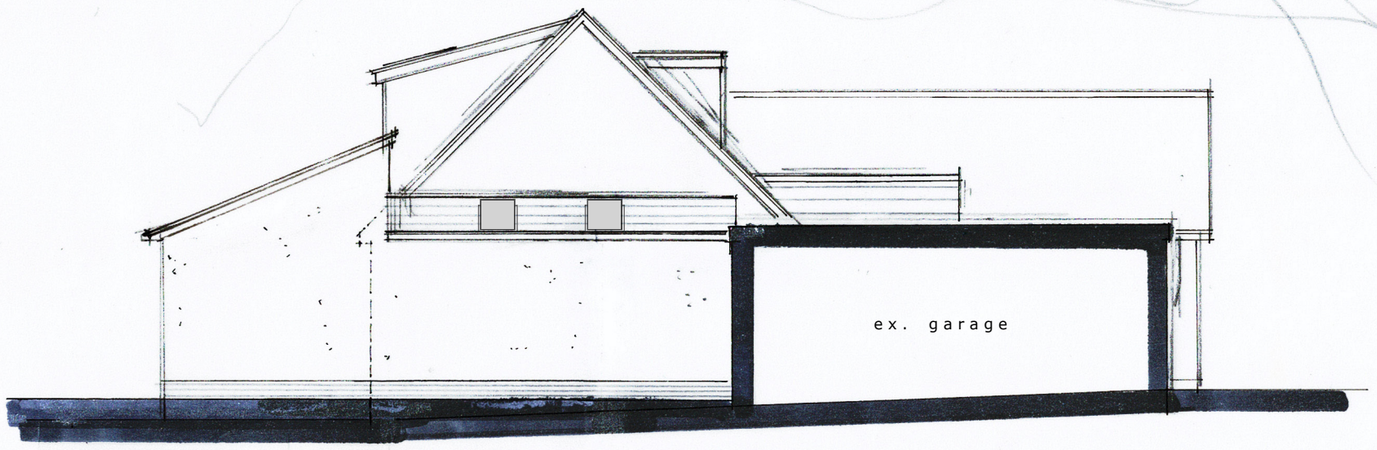

SIDE (e)



REAR (s)

SCHEDULE OF FINISHES

All materials to be of similar appearance to the existing property.

ELEVATIONS	: face brickwork and render to match existing
	: composite cladding or render to rear dormer window
ROOF	: interlocking roof tile to mono-pitch area to match existing main house
WINDOWS/DOORS	: white PVCu plastic or grey powdercoated aluminium frames
R/W GOODS	: black half round guttering with 63mm diameter downpipes

THE CONTRACTOR IS TO PROVIDE SAMPLES FOR APPROVAL BY THE CLIENT AND THE LOCAL PLANNING AUTHORITY IF REQUIRED.

C - two as-built velux shown on side (e) elevation 4/12/25
B - rear roof height increased to reflect as-built 8/9/25
A - rear extension reduced in size to avoid drain, small side extension & enlarged porch canopy added 21/8/24

REVISIONS

Figured dimensions to take precedence over scaled dimensions. The contractor is to verify all dimensions on site before commencing any works.

Any discrepancies whatsoever to be brought to the attention of the client immediately.

The copyright of this drawing is reserved and the drawing must not be disclosed without authority.

Project

43 WEST WAY, HIGH SALVINGTON, WORTHING

Proposed extension works

Client

Mr & Mrs Fullard

Drawing no. **WT/WW/04** **Rev C**

Scale **AS SHOWN** Date **June 2021**

Drawn By **WG**

WAYNE GANDER MCIAT
Chartered Architectural Technologist
98 Durrington Lane
WORTHING
West Sussex
BN13 2RQ
M 07808 887896
Email - waynegander08@gmail.com