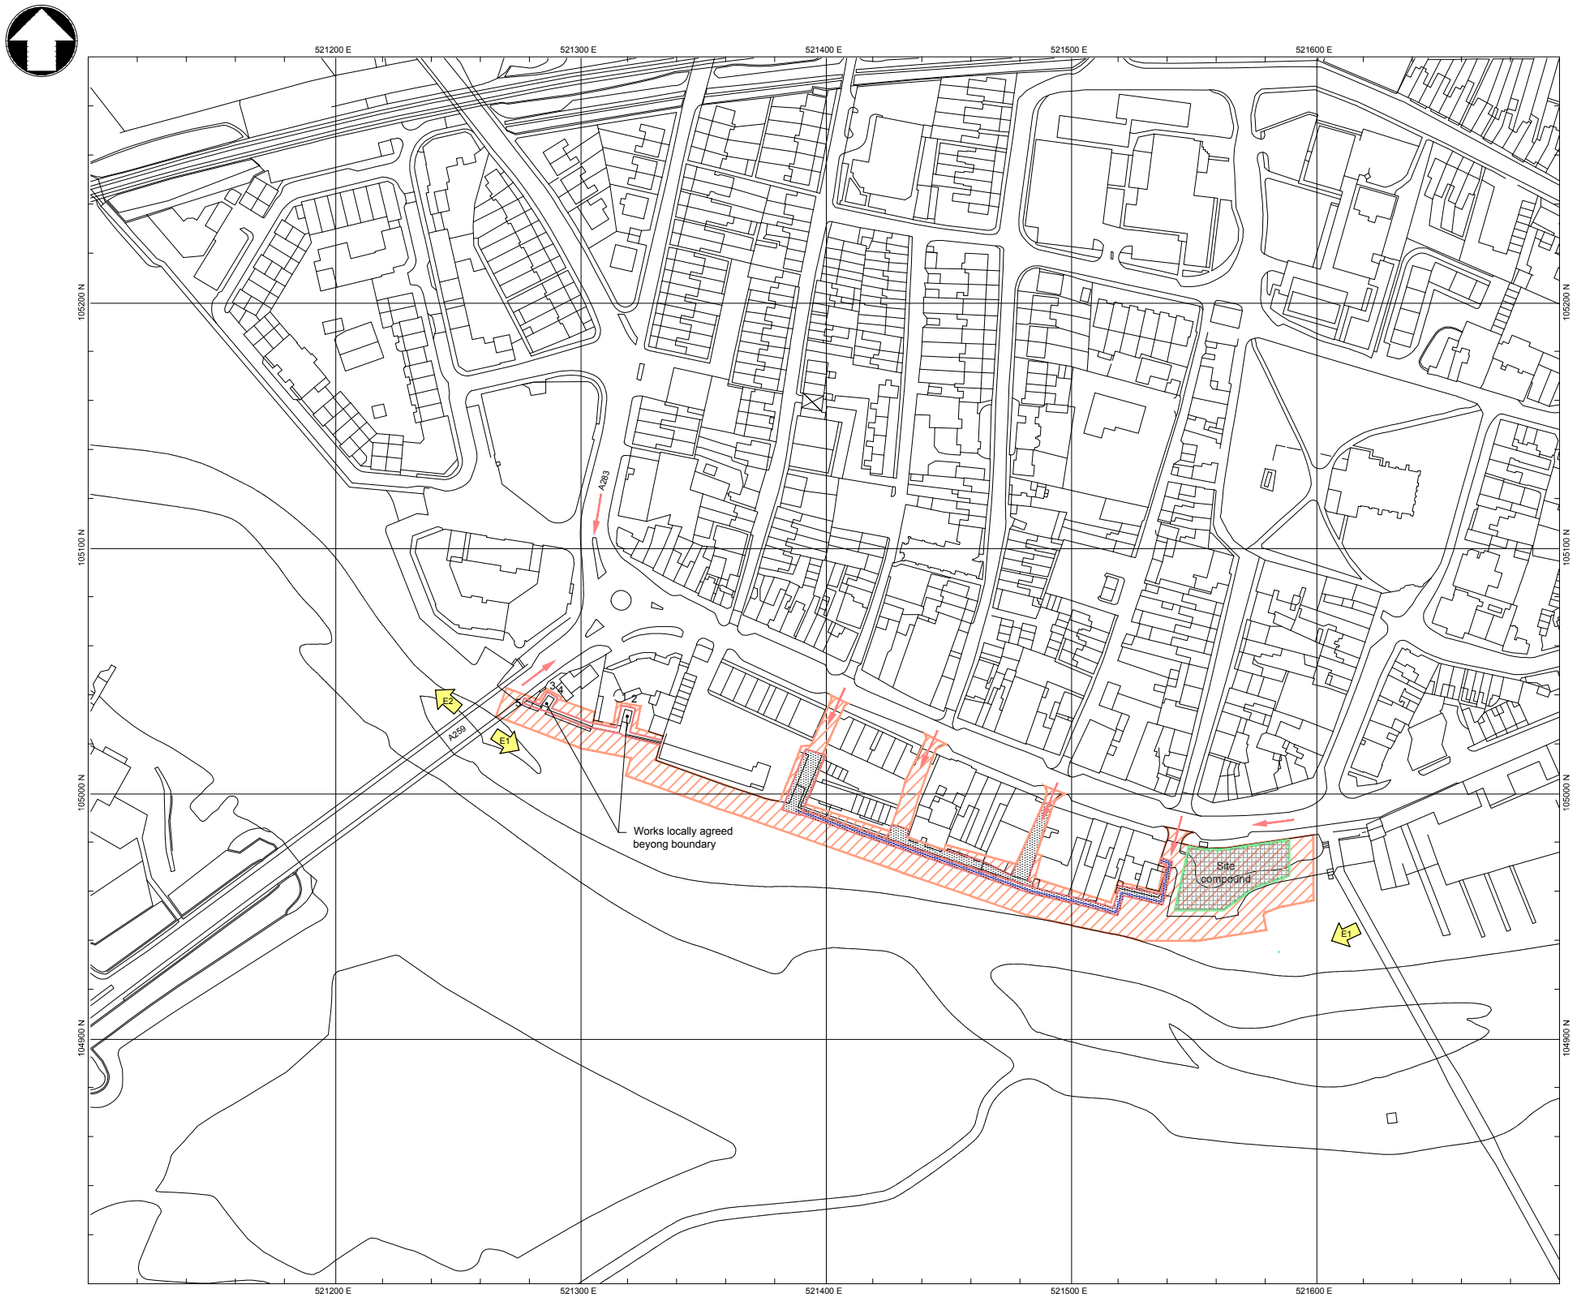


Notes

1. All dimensions are in metres unless noted otherwise.
2. All levels are in metres relative to Ordnance Datum Newlyn (OD).
3. All positions are in metres relative to National Grid.
4. Boundary works at the North extend up to 10m beneath the A259 Brighton Road. Shown over the bridge on plan for illustrative purposes.
5. The Boundary of Works lines should be 10m from the Flood Defence Wall riverward unless the Mean Low Water is encountered before, then Boundary of Works lines turns to be Mean Low Water.
6. Limit of deviation lines should be 1m to each side from the Flood Defence Wall.

Key to symbols

- Flood Defence (Wall or Embankment)
- MLW — Mean Low Water (MLW)
- MHW — Mean High Water (MHW)
- E1 — Reach extent
- Boundary of works
- Limits of deviation
- Satellite site compounds
- Site access from public road
- Temporary Works
- Permanent Works

Key plan



Reference drawings

IMSO000648-MMC-01-E1-DR-C-1131 - General Arrangement

As Built

1:1250 0 62.5m 125m

Rev	Date	Drawn	Description	Ch'k'd	App'd
C02	10.12.18	IAS	As Built	GRW	NJC
C01	18.05.16	PMS	Contract Drawing	NJC	PJP

Mott MacDonald

Mott MacDonald House
8-10 Sydenham Road
Croydon, CR0 2EE
United Kingdom

T +44 (0)20 8774 2000
F +44 (0)20 8681 5706
W www.mottmac.com

Client

Environment Agency

Title

Shoreham Adur Tidal Walls
Reach E1 : Tollhouse Bridge

Reach Overview

Designed	F Loy	FL	Eng check	F Loy	FL
Drawn	A L Mig	ALM	Coordination	N J Clarke	NJC
Dwg check	P M Starnes	PMS	Approved	P J Phipps	PJP

Scale at A1	Status	Rev	Security
1:1250	A6	C02	STD

Drawing Number
IMSO000648-MMC-01-E1-DR-C-1130

© Mott MacDonald

This document is issued for the party which commissioned it and for specific purposes connected with the captioned project only. It should not be relied upon by any other party or used for any other purpose.
We accept no responsibility for the consequences of this document being relied upon by any other party, or being used for any other purpose, or containing any error or omission which is due to an error or omission in data supplied to us by other parties.

© Crown copyright and database rights 2014 Ordnance Survey 100024198 © Environment Agency copyright and/or database rights 2014. All rights reserved.

C:\pw work\pw_dev_cde\sus40650\dms00807\IMSO000648-MMC-01-E1-DR-C-1130.dwg Dec 10, 2018 - 11:12AM SUS40650