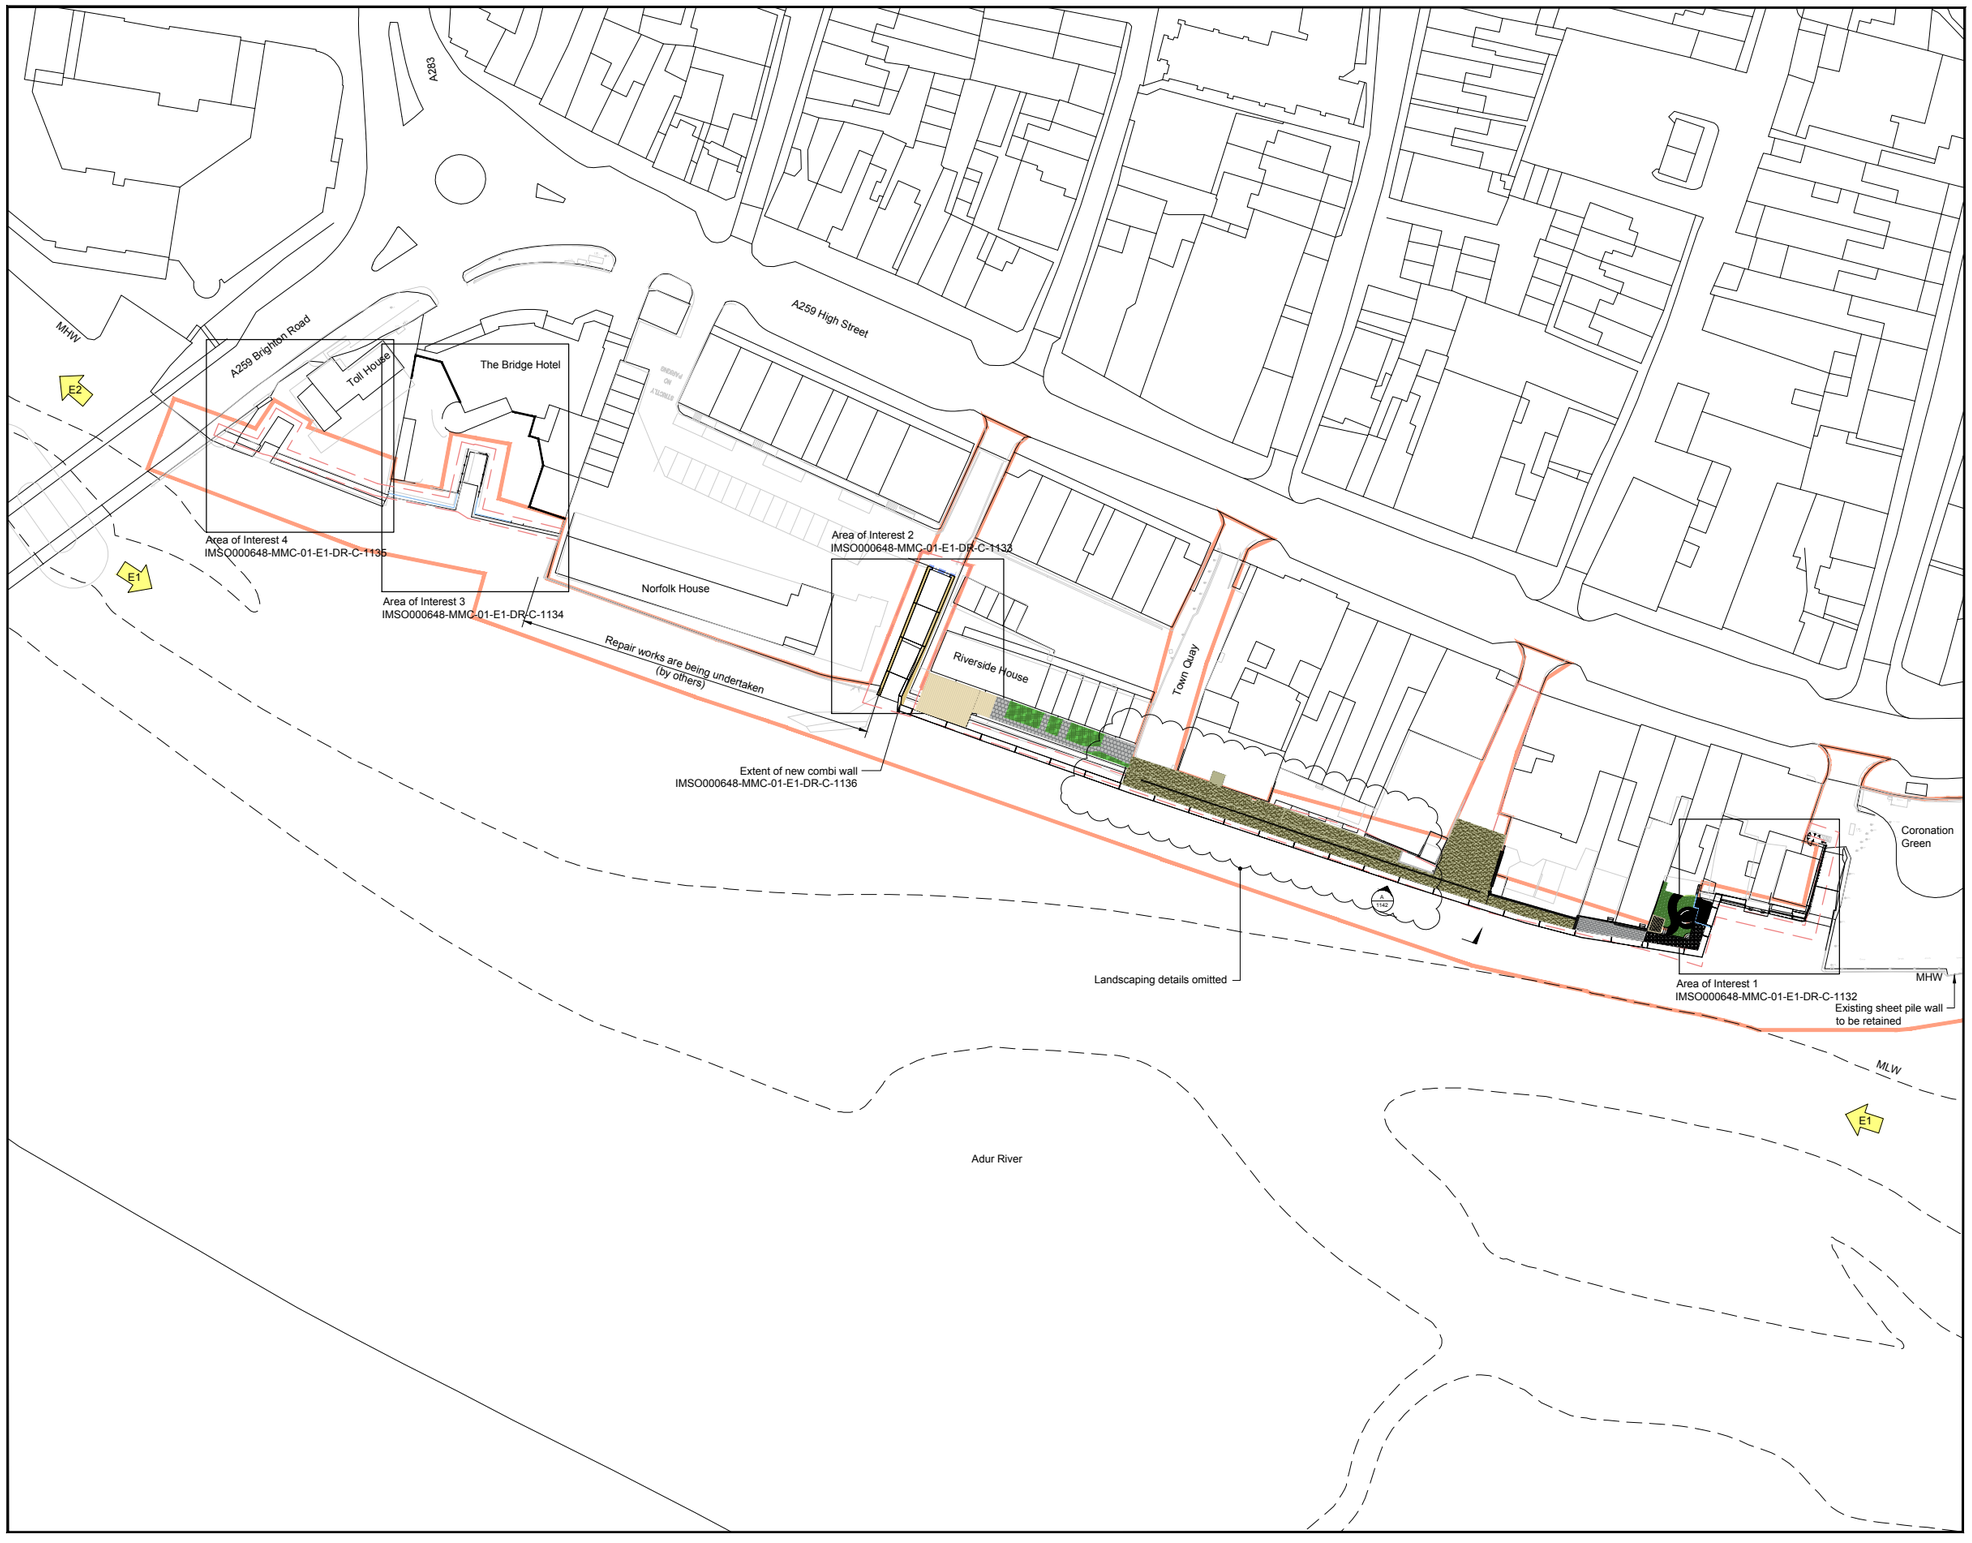


Notes

1. All dimensions are in millimetres unless noted otherwise.
2. All levels are in metres relative to Ordnance Datum Newlyn (OD).
3. All positions are in metres relative to National Grid.

Key to symbols

- Sheet Pile Wall (Length 150m)
- Reinforced Concrete L-Shaped Wall (Length 80m)
- Wall Improvement with Concrete Facing (Length 75m)
- Flood Gates and Stop Log Systems (Length 15m)
- Mean Low Water (MLW)
- Mean High Water (MHW)
- E1 Reach extent
- Boundary of works
- Limits of deviation

Key plan



Reference drawings

IMSO000648-MMC-01-E1-DR-C-1132	Plan View - Area of Interest 1
IMSO000648-MMC-01-E1-DR-C-1133	Plan View - Area of Interest 2
IMSO000648-MMC-01-E1-DR-C-1134	Plan View - Area of Interest 3
IMSO000648-MMC-01-E1-DR-C-1135	Plan View - Area of Interest 4
IMSO000648-MMC-01-E1-DR-C-1136	Sheet Pile Wall Alignment
IMSO000648-MMC-01-E1-DR-C-1142	Elevation at Town Quay
IMSO000648-MMC-01-E1-DR-C-1144	Elevation of the Reach

As Built

1:500 0 25m 50m

Rev	Date	Drawn	Description	Ch'k'd	App'd
C02	10.12.18	IAS	As Built	GRW	NJC
C01	18.05.16	PMS	Contract Drawing	NJC	PJP

Mott MacDonald

Mott MacDonald House
8-10 Sydenham Road
Croydon, CR0 2EE
United Kingdom

T +44 (0)20 8774 2000
F +44 (0)20 8681 5706
W www.mottmac.com

Client

Environment Agency

Title

Shoreham Adur Tidal Walls
Reach E1 : Tollhouse Bridge

General Arrangement Plan

Designed	F Loy	FL	Eng check	F Loy	FL
Drawn	I Sussex	IAS	Coordination	N J Clarke	NJC
Dwg check	P M Starnes	PMS	Approved	P J Phillips	PJP

Scale at A1	Status	Rev	Security
1:500	A6	C02	STD

Drawing Number
IMSO000648-MMC-01-E1-DR-C-1131

© Mott MacDonald

This document is issued for the party which commissioned it and for specific purposes connected with the captioned project only. It should not be relied upon by any other party or used for any other purpose.
We accept no responsibility for the consequences of this document being relied upon by any other party, or being used for any other purpose, or containing any error or omission which is due to an error or omission in data supplied to us by other parties.

© Crown copyright and database rights 2014 Ordnance Survey 100024198 © Environment Agency copyright and/or database rights 2014. All rights reserved.