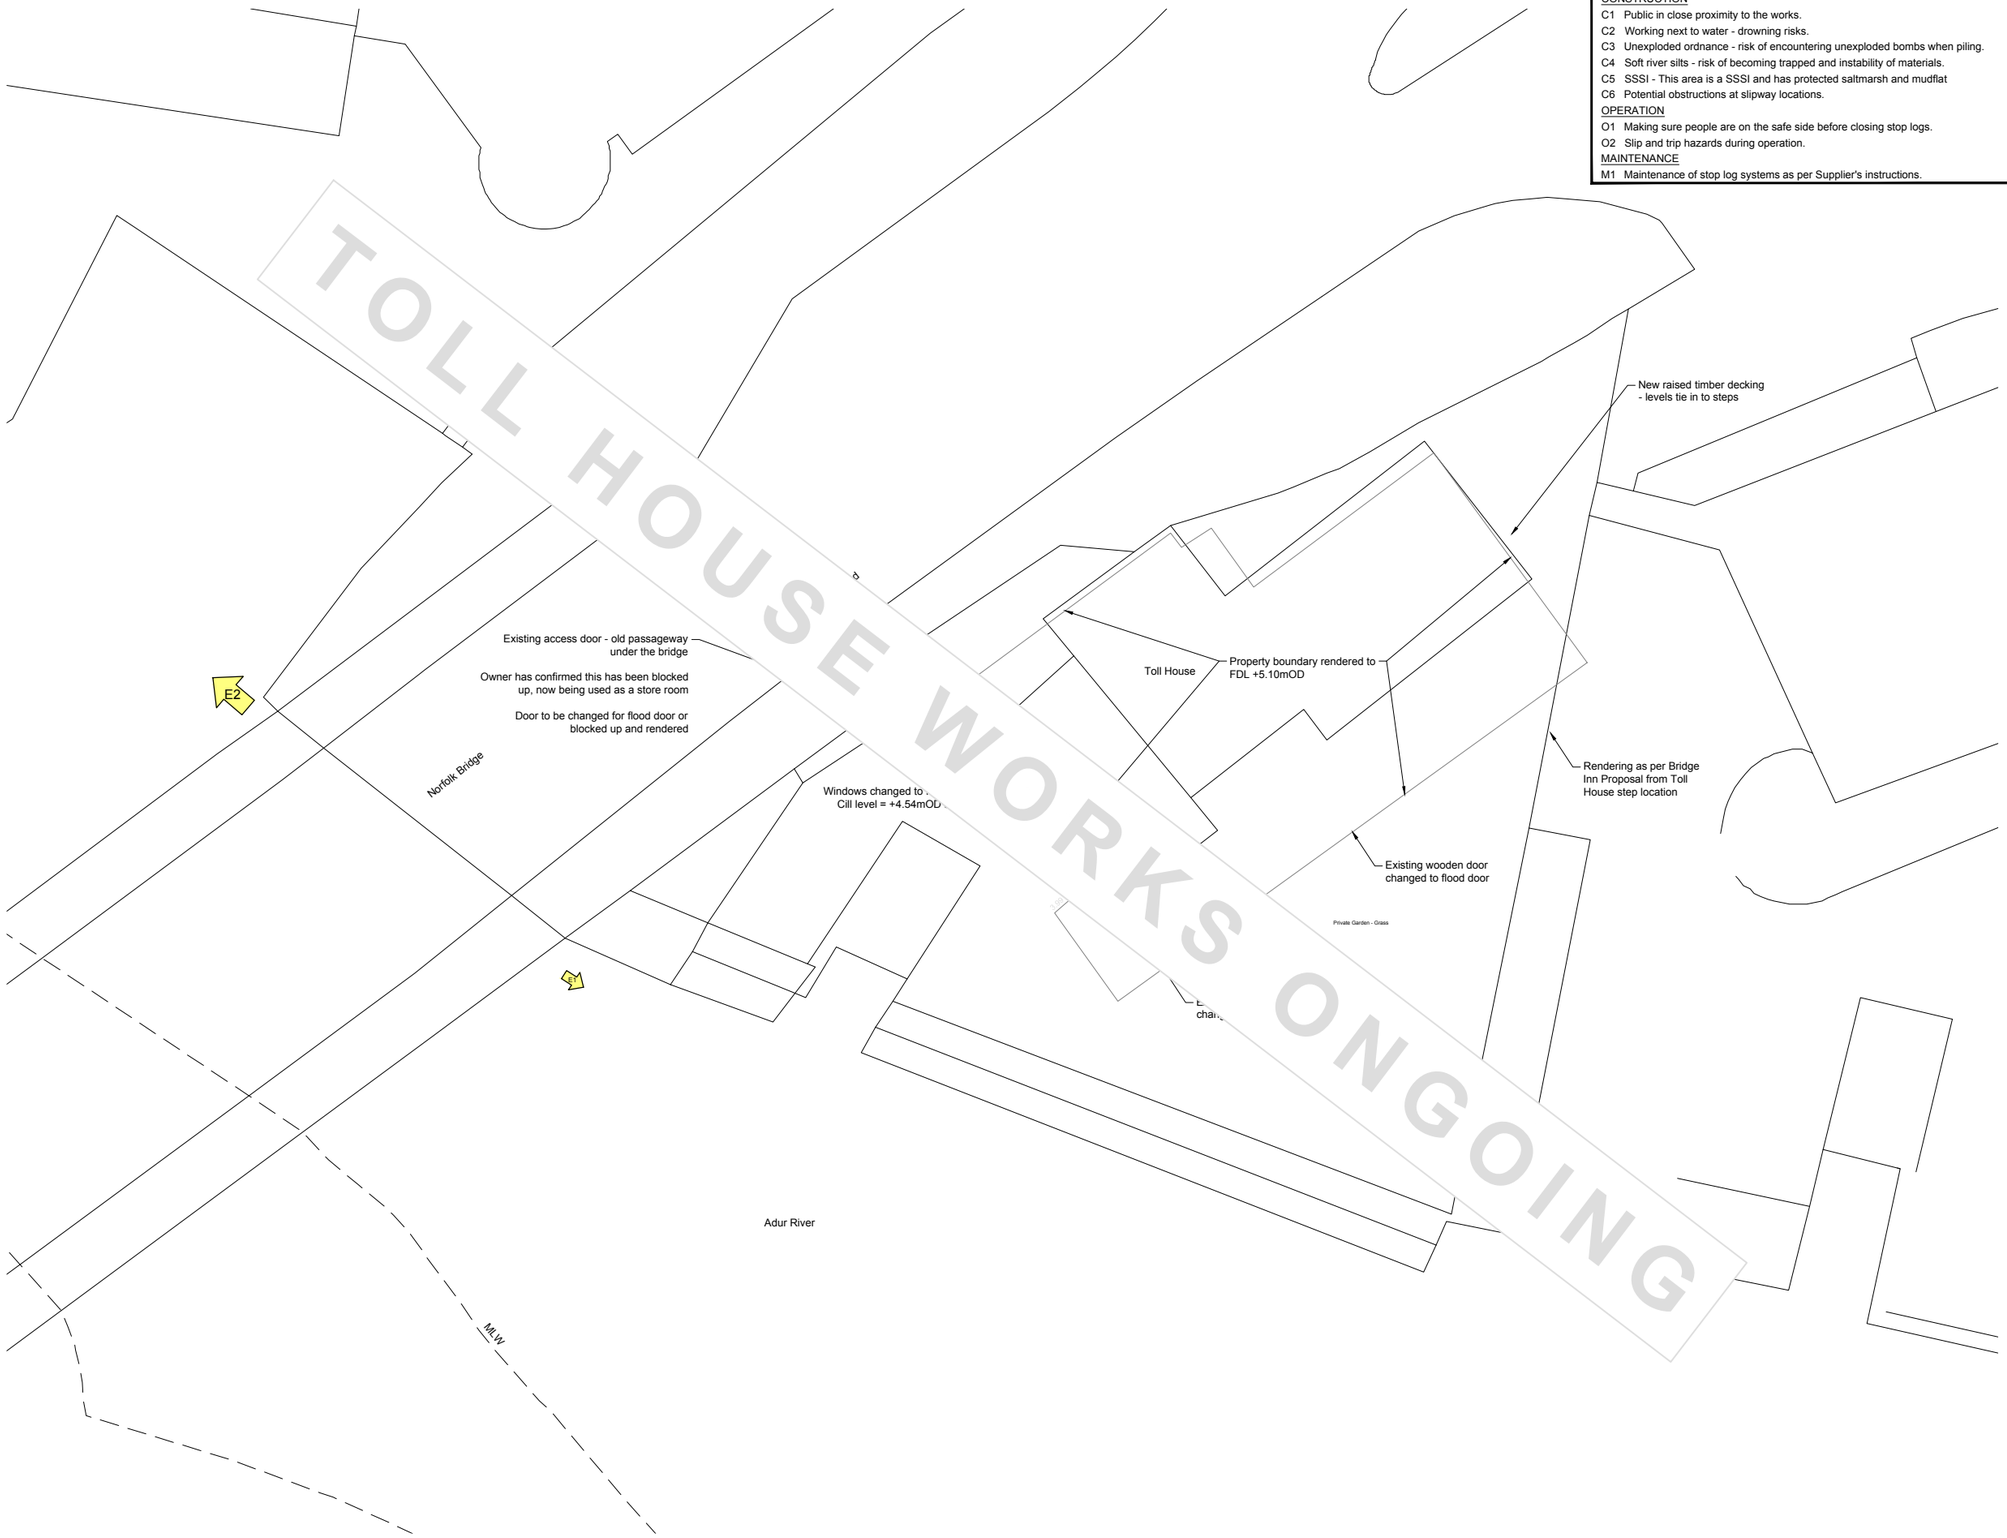


Safety, Health & Environmental Information

It is assumed that all works will be carried out by a competent contractor working, where appropriate, to an approved method statement.

In addition to the hazards/risks normally associated with the types of work detailed on this drawing, note the following risks and information:

CONSTRUCTION

C1 Public in close proximity to the works.
C2 Working next to water - drowning risks.
C3 Unexploded ordnance - risk of encountering unexploded bombs when piling.
C4 Soft river silts - risk of becoming trapped and instability of materials.
C5 SSSI - This area is a SSSI and has protected saltmarsh and mudflat
C6 Potential obstructions at slipway locations.

OPERATION

O1 Making sure people are on the safe side before closing stop logs.
O2 Slip and trip hazards during operation.

MAINTENANCE

M1 Maintenance of stop log systems as per Supplier's instructions.


Notes

1. All dimensions are in millimetres unless noted otherwise.
2. All levels are in metres relative to Ordnance Datum Newlyn (OD).
3. All positions are in metres relative to National Grid.
4. For flood gate details, refer to drawing IMSO000648-MMC-01-E1-DR-C-1146.
5. For reinforcement details related to the piers of the flood gate, refer to Drawing IMSO000648-MMC-01-E1-DR-C-1152 which will be amended based on the exact dimensions of this flood gate.

Key to symbols

CJ - Contraction Joint
EJ - Expansion Joint
Mean High Water (MHW)
E1 Reach extent

Key plan

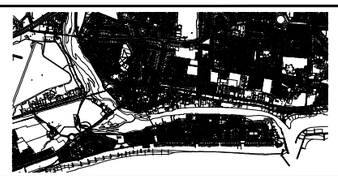

Reference drawings

IMSO000648-MMC-01-E1-DR-C-1131 - General Arrangement
IMSO000648-MMC-01-E1-DR-C-1140 - Sections Sheet 4 - Toll House
IMSO000648-MMC-01-E1-DR-C-1146 - Flood Gate & Stop Log Details - Sheet 2

As Built

1:50 0 2.5m 5m

Rev	Date	Drawn	Description	Ch'k'd	App'd
C03	10.12.18	IAS	As Built	GRW	NJC
C2	11.07.16	PMS	Construction Revision	NJC	PJP
C1	18.05.16	PMS	Contract Drawing	NJC	PJP

Mott MacDonald House
8-10 Sydenham Road
Croydon, CR0 2EE
United Kingdom

T +44 (0)20 8774 2000
F +44 (0)20 8681 5706
W www.mottmac.com

Client: Environment Agency

Title: Shoreham Adur Tidal Walls
Reach E1 : Tollhouse Bridge

Plan View - Area of Interest 4

Designed	F Loy	FL	Eng check	F Loy	FL
Drawn	I Sussex	IAS	Coordination	N J Clarke	NJC
Dwg check	P M Starnes	PMS	Approved	P J Phipps	PJP

Scale at A1	Status	Rev	Security
1:50	A6	C03	STD

Drawing Number: IMSO000648-MMC-01-E1-DR-C-1135

© Mott MacDonald

This document is issued for the party which commissioned it and for specific purposes connected with the captioned project only. It should not be relied upon by any other party or used for any other purpose.
We accept no responsibility for the consequences of this document being relied upon by any other party, or being used for any other purpose, or containing any error or omission which is due to an error or omission in data supplied to us by other parties.

© Crown copyright and database rights 2014 Ordnance Survey 100024198 © Environment Agency copyright and/or database rights 2014. All rights reserved.