

Door Ref: A

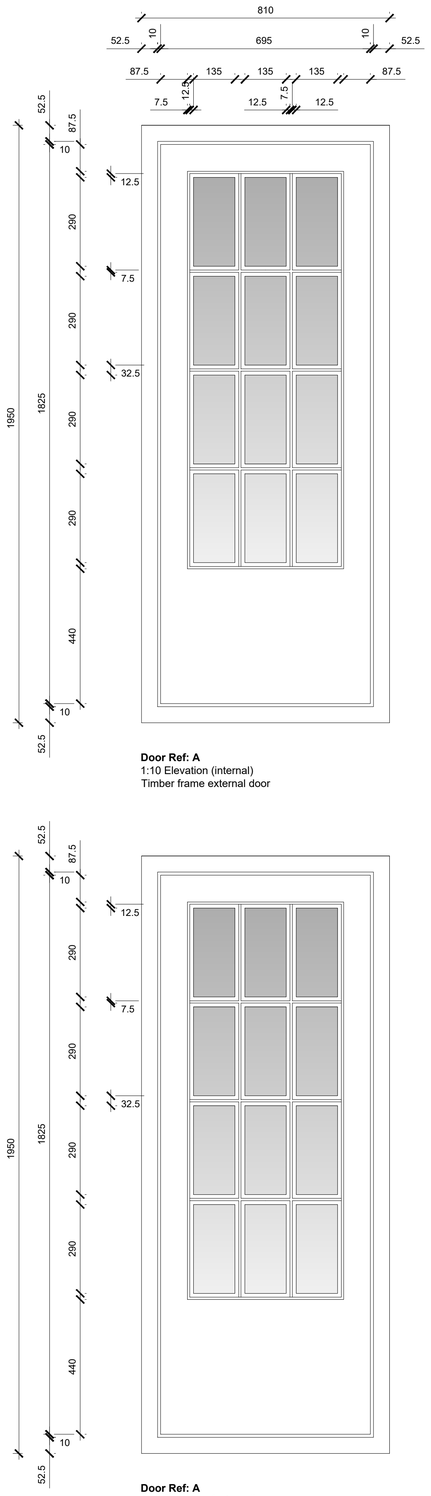


Door Ref: A
1:10 Elevation (internal)
Timber frame external door

Door Ref: A
1:10 Elevation (external)
Timber frame external door

Window Ref: A

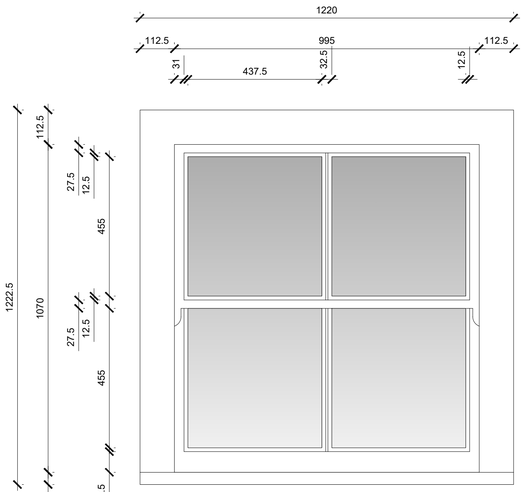


Window Ref: A
1:10 Elevation (external)
Timber frame sash window

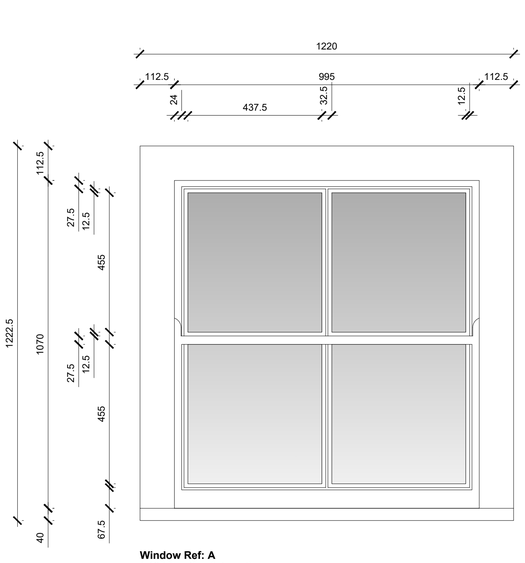


Window Ref: A
1:10 Elevation (internal)
Timber frame sash window

Window Ref: B

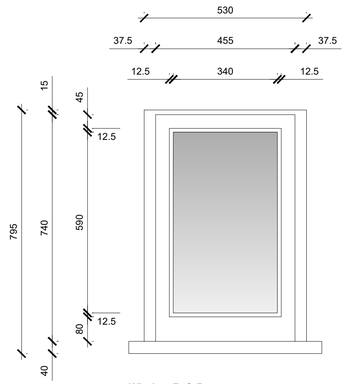


Window Ref: B
1:10 Elevation (external)
Timber frame casement window

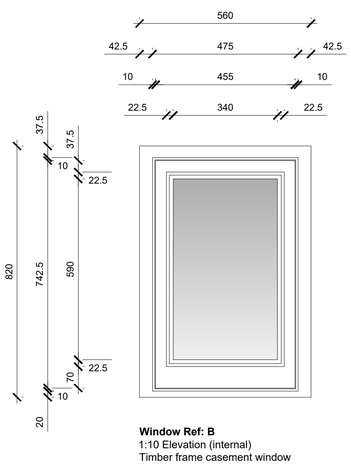


Window Ref: B
1:10 Elevation (internal)
Timber frame casement window

Window Ref: C / Door Ref: B

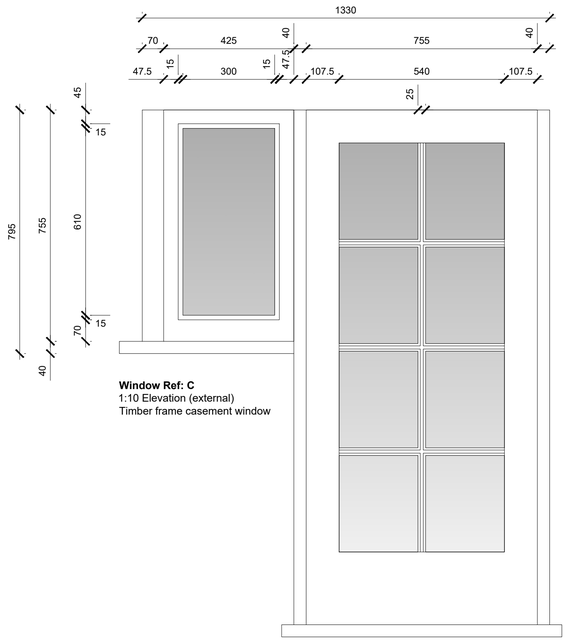


Window Ref: C
1:10 Elevation (external)
Timber frame casement window

Door Ref: B
1:10 Elevation (external)
Timber frame external door

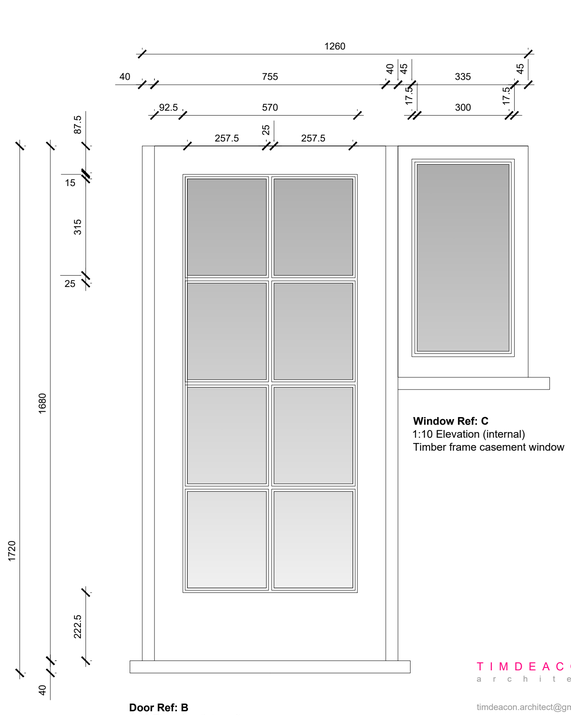


Door Ref: B
1:10 Elevation (internal)
Timber frame external door

Window Ref: D

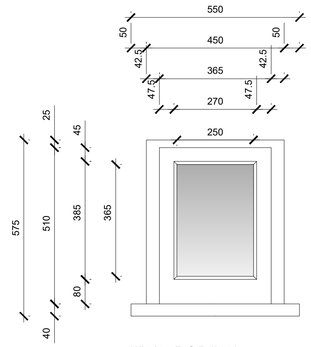

Window Ref: D (2no.)
1:10 Elevation (external)
Timber frame casement window

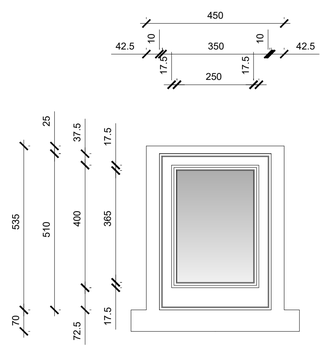

Window Ref: D (2no.)
1:10 Elevation (internal)
Timber frame casement window

0 0.25 0.5 0.75
Scale In Metres

TIMDEACON.
architect

timdeacon.architect@gmail.com

rev.	date	comment
amendments		
b.	11.11.24	Windows & Doors amended as installed.
a.	12.07.23	Text & dimensions revised.

client	Mr & Mrs Crampton
job	2 Old Swan Cottages, 40 Middle Street, Shoreham-by-Sea, BN43 5DP
dwg #	150.PL.02b
dwg title	Proposed Door/Window Elevations (A-D)
	PLANNING (LBC)
scale	1:10 @ A1
date	April 2023
RIBA work stage	D

Do not scale off drawing unless solely for Planning purposes.
Check all dimensions on site before work commences.
All goods materials workmanship to conform with current building regulations BSS and COP's.
© Copyright Tim Deacon. Architect