
Window Ref: E

Inaccessible externally

Window Ref: F


Inaccessible externally

Window Ref: G

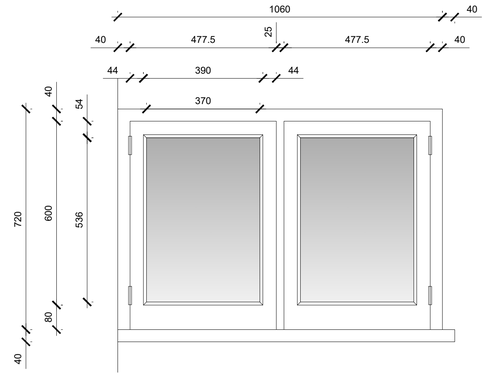


Window Ref: G
1:10 Elevation (external)
Timber frame casement window

Window Ref: H

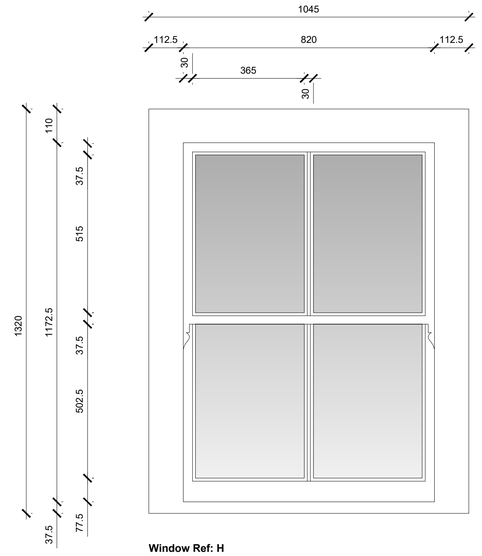


Window Ref: H
1:10 Elevation (external)
Timber frame sash window

Window Ref: E

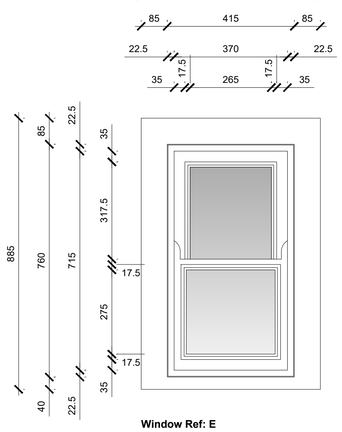


Window Ref: E
1:10 Elevation (internal)
Timber frame sash window

Window Ref: F

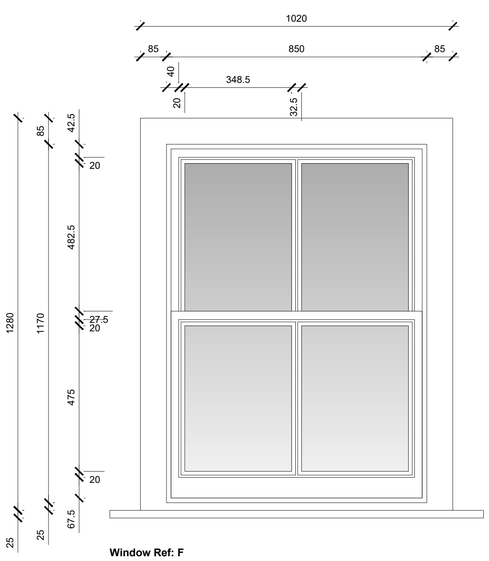


Window Ref: F
1:10 Elevation (internal)
Timber frame sash window

Window Ref: G

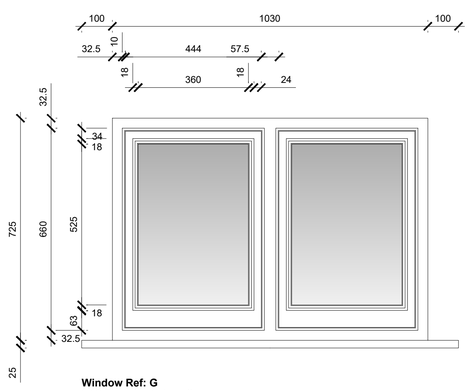

Window Ref: G
1:10 Elevation (internal)
Timber frame casement window

Window Ref: H

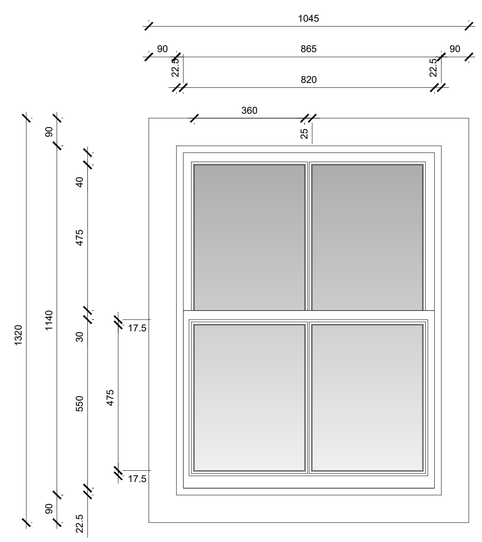

Window Ref: H
1:10 Elevation (internal)
Timber frame sash window



Scale In Metres

T I M D E A C O N .
a r c h i t e c t

timdeacon.architect@gmail.com

rev.	date	amendments
c.	11.11.24	Windows & Doors amended as installed.
b.	28.08.23	Proposed glazing revised.
a.	12.07.23	Dimensions & sections revised.

client	Mr & Mrs Crampton
job	2 Old Swan Cottages, 40 Middle Street, Shoreham-by-Sea, BN43 5DP
dwg #	150.PL.03c
dwg title	Proposed Door/Window Elevations (E-H) PLANNING (LBC)
scale	1:10 @ A1
date	April 2023
RIBA work stage	D

Do not scale off drawing unless solely for Planning purposes.
Check all dimensions on site before work commences.
All goods materials workmanship to conform with current building regulations BSS and COP's.
© Copyright Tim Deacon. Architect